


WINDOW AND EXTERIOR DOOR SCHEDULE									
SYM	MANUF.	TYPE	NUMBER	ROUGH OPENING	QUANTITY	GLAZING	GRILLES	U-FACTOR	NOTES
1	ANDERSEN	CASEMENT	CW 125	2'-4 7/8" x 2'-4 7/8"	3 (2L, 1R)	FDL - LOW E 4	2W 2H	0.28	2 L UNITS INTERIOR VINYL WRAPPED, 1R UNIT TO BE TEMPERED GLASS
2	ANDERSEN	CASEMENT	CW 135	2'-4 7/8" x 3'-5 5/8"	3 (1L, 2R)	FDL - LOW E 4	2W 2H	0.28	1R UNIT TO BE TEMPERED GLASS
3	ANDERSEN	CASEMENT	CW 335	7'-1 1/8" x 3'-5 5/8"	1 (L,F,R)	FDL - LOW E 4	2W 2H	0.28	
4	ANDERSEN	TILT WASH DBL HUNG	TW 24310	2'-6 1/8" x 4'-0 7/8"	2	FDL - LOW E 4	2 OVER 2	0.31	
5	ANDERSEN	TILT WASH DBL HUNG	TW 2452	2'-6 1/8" x 5'-4 7/8"	14	FDL - LOW E 4	2 OVER 2	0.31	1 UNIT TO BE TEMPERED GLASS IN LOWER SASH
6	ANDERSEN	TILT WASH DBL HUNG	TW 30410	3'-2 1/8" x 5'-0 7/8"	3	FDL - LOW E 4	2 OVER 2	0.31	
7	ANDERSEN	AWNING	AW21	2'-4 7/8" x 2'-4 7/8"	2	FDL - LOW E 4	2W 2H	0.28	
8	ANDERSEN	TILT WASH DBL HUNG	CUSTOM	2'-3 3/4" x 3'-6 1/4"	1	FDL - LOW E 4	2 OVER 2	0.31	
9	ANDERSEN	TILT WASH DBL HUNG	CUSTOM	2'-9 5/8" x 4'-7 5/8"	2	FDL - LOW E 4	2 OVER 2	0.31	
A				3'-2 1/2" x 7'-6"	1		2W2H	0.XX	
B	ANDERSEN	INSWING FRENCH DR	FWH 90611 - 3	9'-0" x 6'-11"	1 (S, R, S)	FDL - LOW E 4	2W3H	0.31	
C	ANDERSEN	INSWING FRENCH DR	FWH 6080 APLR	6'-0" x 8'-0"	1	FDL - LOW E 4	2W3H	0.31	
ANDERSEN WINDOW AND DOOR NOTES: 1. DOORS AND WINDOWS - ANDERSEN 400 SERIES 2. GLAZING - FULL DIVIDED LIGHT WITH SPACER BAR									


INTERIOR DOOR SCHEDULE							
SYM	MANUF	TYPE	TYPE	SIZE	ROUGH OPENING	QUANTITY	NOTES
E		SWINGING DOOR		2'-6" x 6'-8"	2'-8" x 6'-10 1/2"	2	
F		SWINGING DOOR		3'-0" x 6'-8"	3'-2" x 6'-10 1/2"	4	
G		SWINGING DOOR		3'-0" x 6'-8"	3'-2" x 6'-10 1/2"	1	3/4 HR FIRE RATED W/SELF CLOS. MECHANISM
H		SWINGING DOOR		(2) 1'-8" x 6'-8"	3'-4" x 6'-8 1/2"	1	
J		SWINGING DOOR		(2) 1'-8" x 6'-8"	3'-4" x 6'-10 1/2"	5	
K		SWINGING DOOR		(2) 2'-0" x 6'-8"	4'-2" x 6'-10 1/2"	2	
L		POCKET DOOR		3'-0" x 6'-8"	6'-2" x 6'-10 1/2"	1	

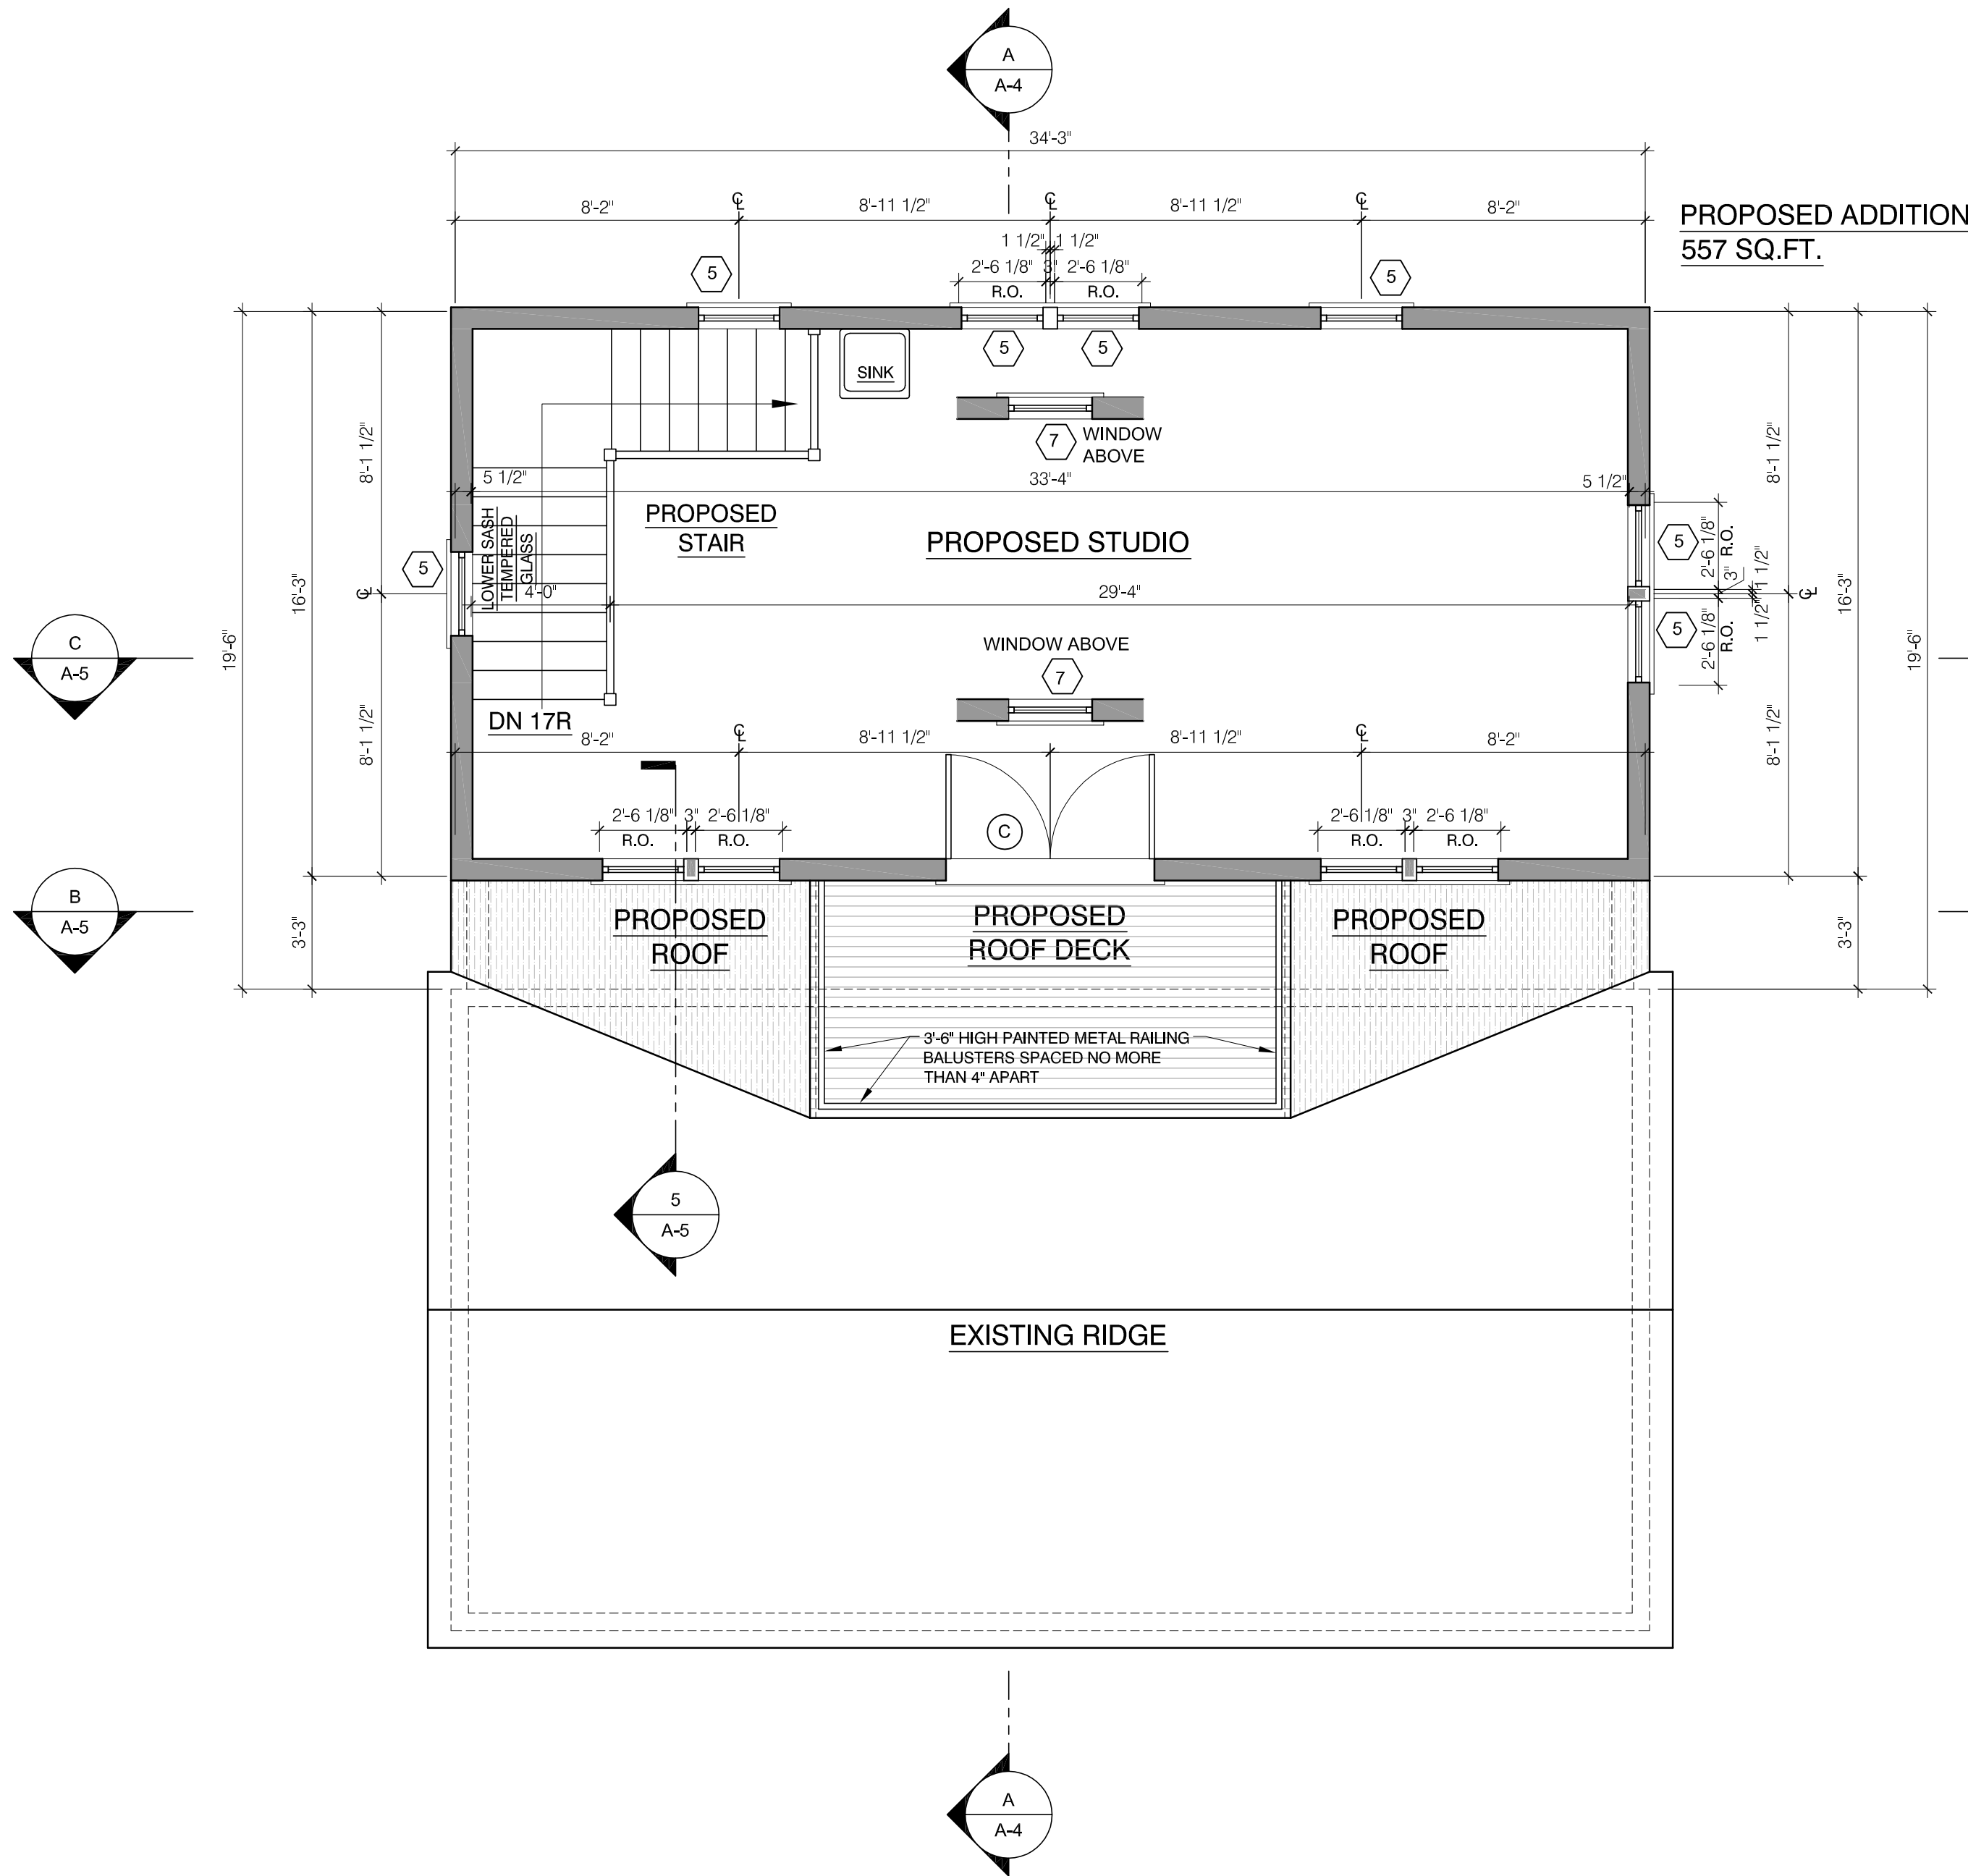

2 THIRD FLOOR PLAN
SCALE: 1/4" = 1'-0"


LEGEND

- EXISTING TO REMAIN
- EXISTING TO BE REMOVED
- PROPOSED WORK

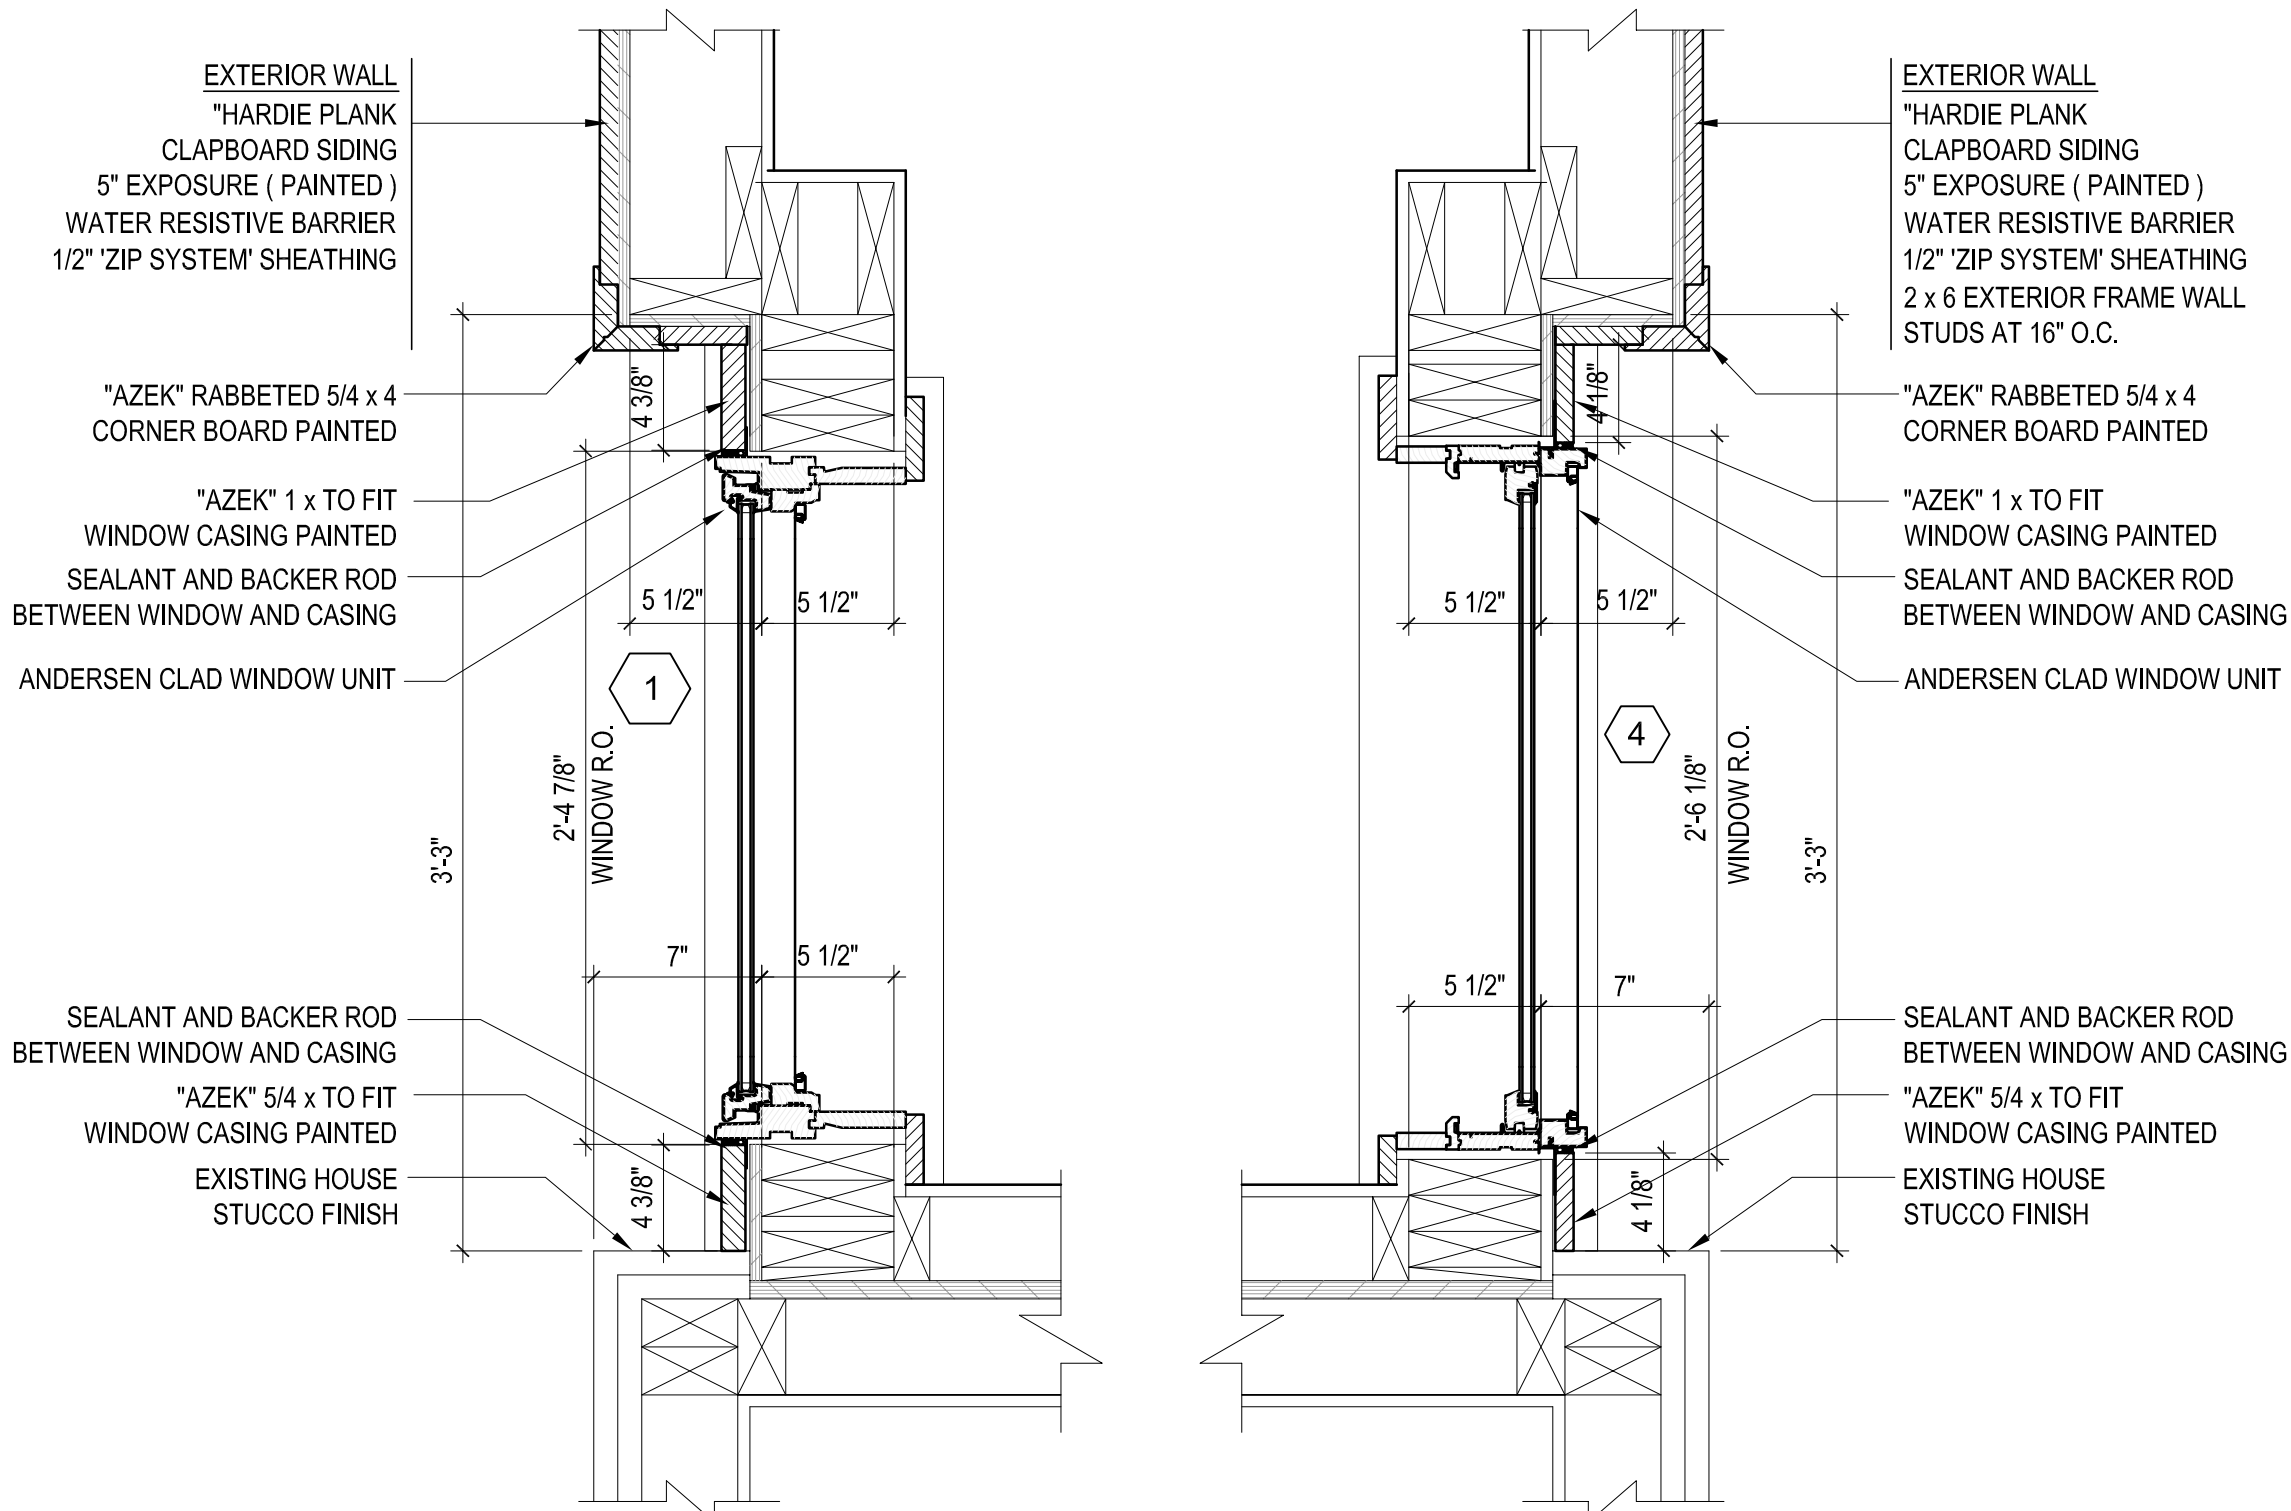

4 PLAN DETAIL
SCALE: 1 1/2" = 1'-0"

3 PLAN DETAIL
SCALE: 1 1/2" = 1'-0"

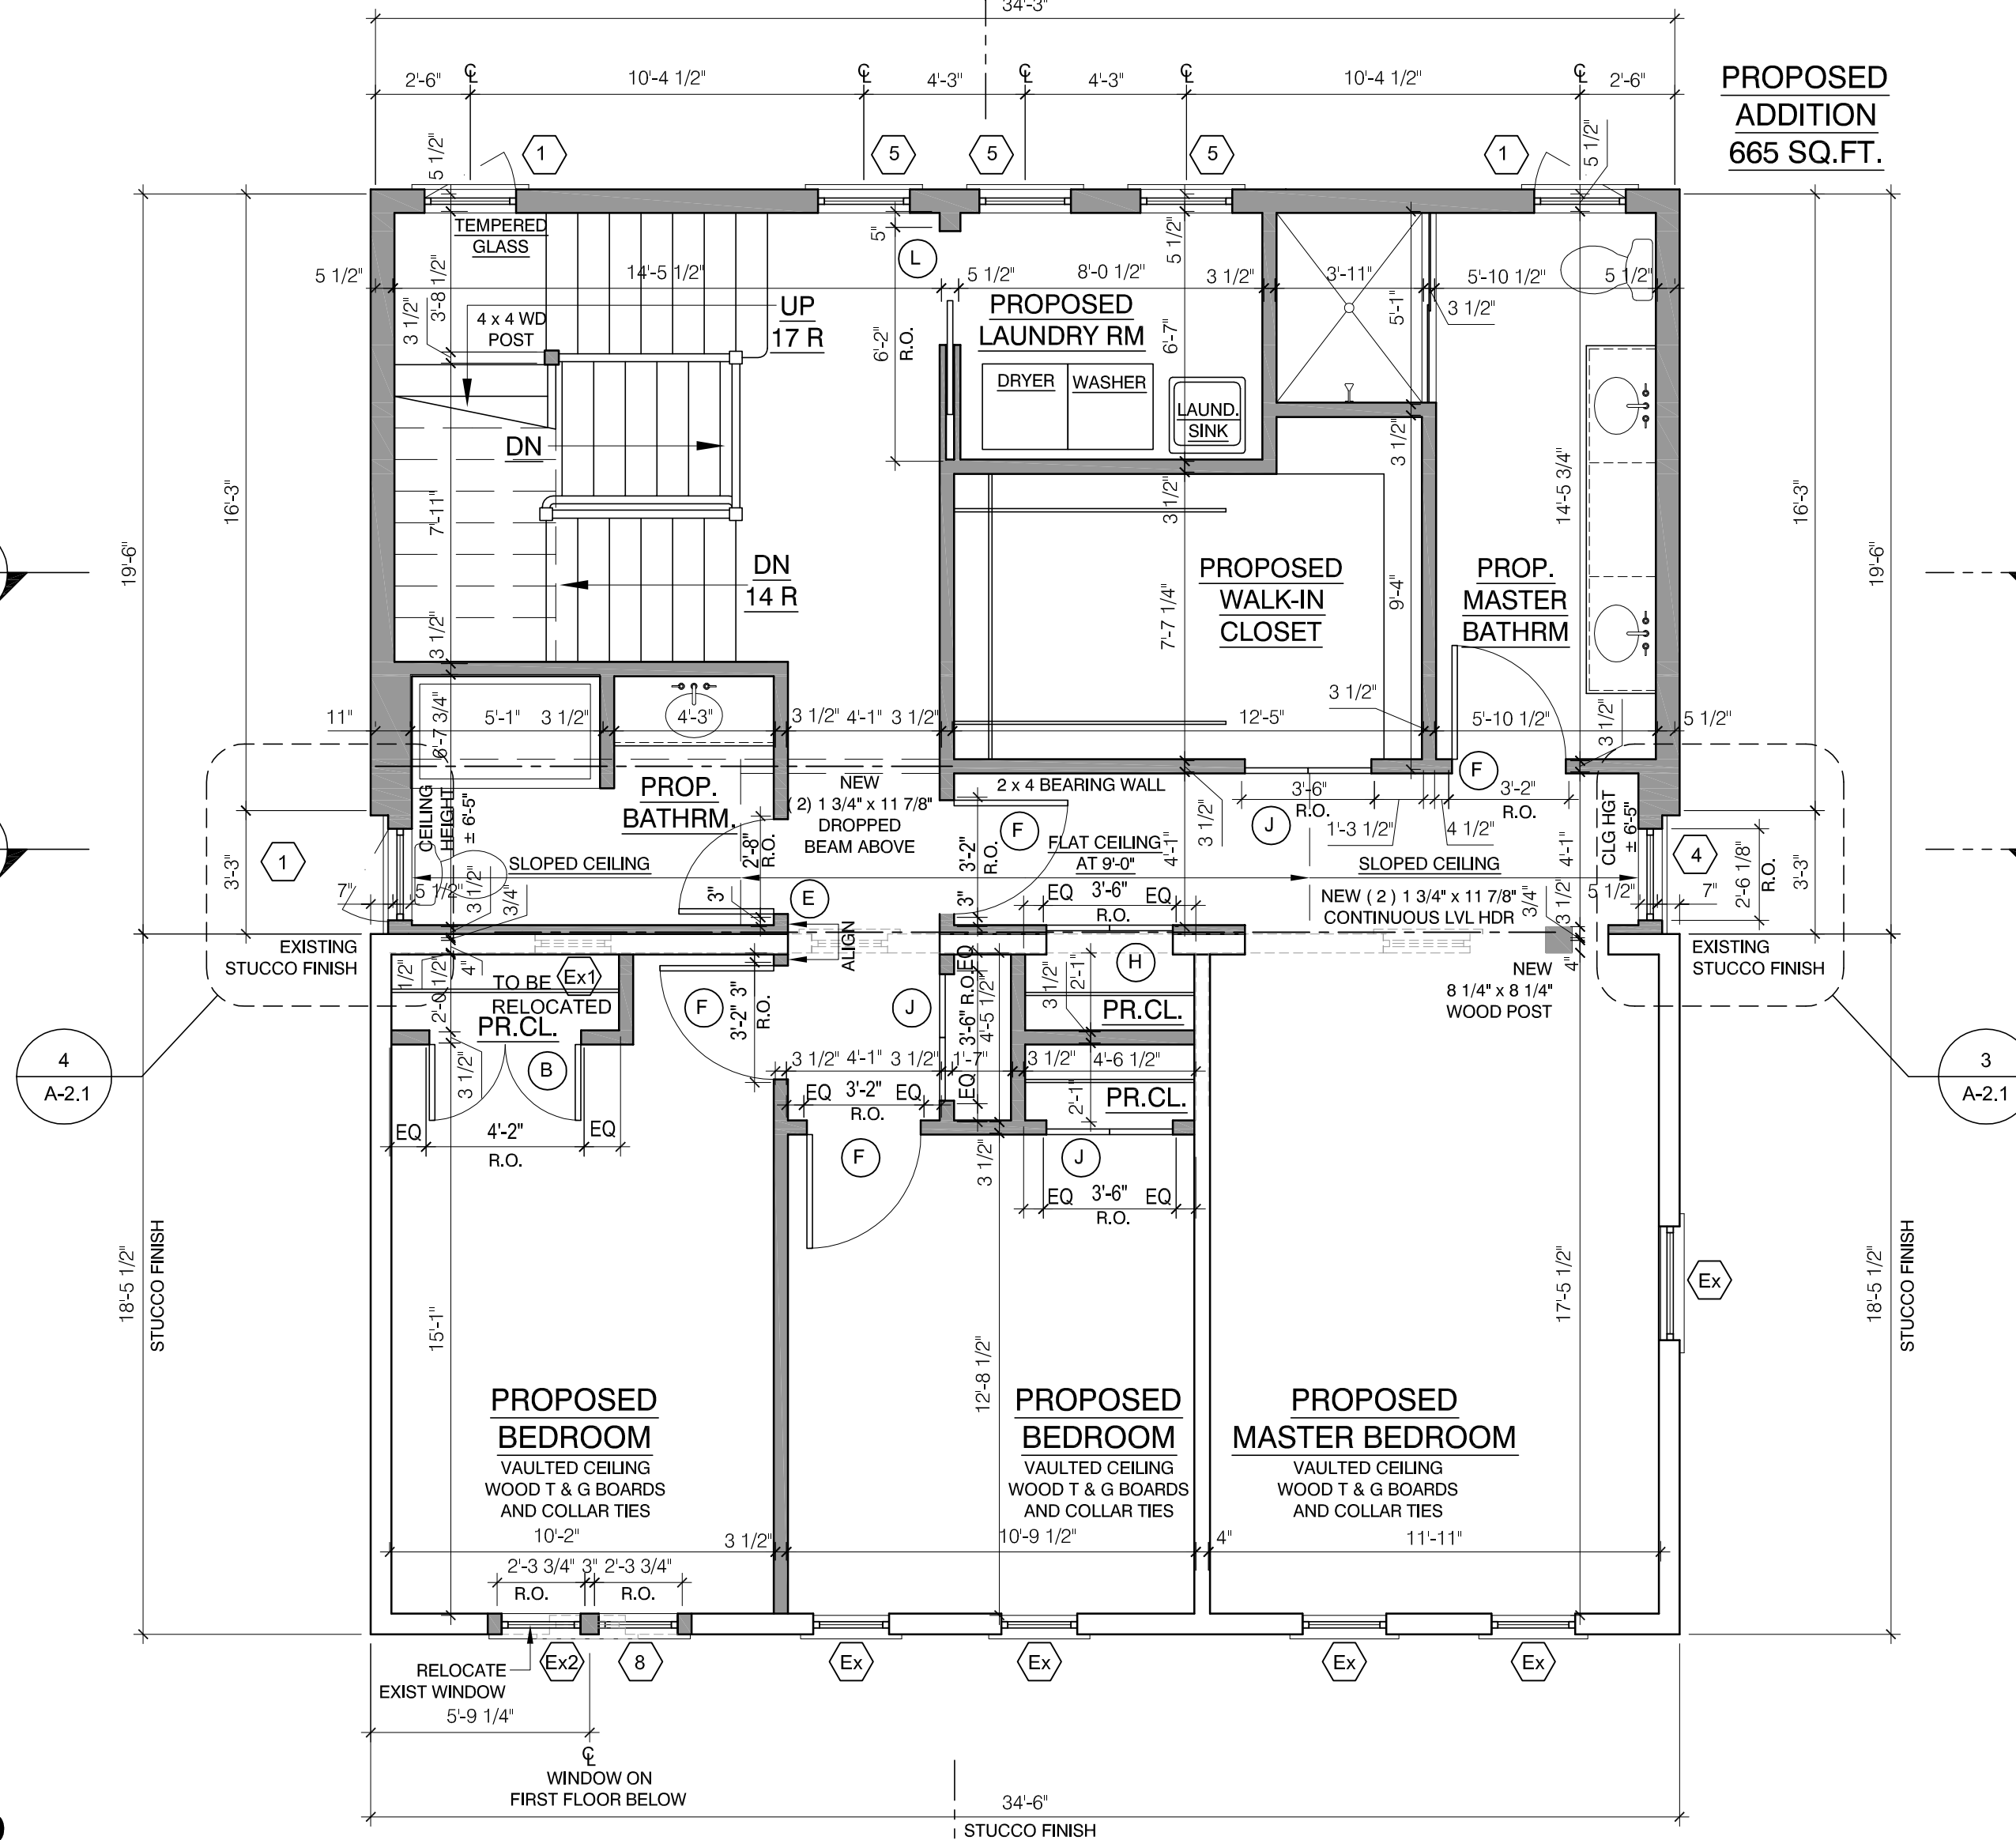

1 SECOND FLOOR PLAN
SCALE: 1/4" = 1'-0"



ROYAL CONSTRUCTION
ENGINEERING SERVICES PC
27 MAIN STREET
DOBBS FERRY, N.Y. 10522
TEL: 914 479-5040
abe@royal-newyork.com

N.Y.S. LICENSE No. 079548

PROJECT TITLE:
NOYES RESIDENCE
130 PALISADE STREET
DOBBS FERRY, NEW YORK 10522
PROJECT NO.: 1801

GOTHAM DESIGN
AND COMMUNITY DEVELOPMENT LTD.




329 Broadway
Dobbs Ferry, N.Y. 10522
Phone: (914) 693-5093
Fax: (914) 693-5390
email: arch329@gmail.com

ISSUED / REVISIONS	
04-04-18	AHRB SUBMISSION
REVISED	04-10-18
04-17-18	AHRB SUBMISSION
REVISED	04-27-18
REVISED	05-08-18
REVISED	06-26-18
1. ADDED WINDOW AND DOOR SWINGS	
2. NOTED WHICH WINDOWS ARE TEMPERED GLASS	
ISSUED	07-24-18
ISSUED FOR CONSTRUCTION	09-13-18
AS-BUILT	02-15-22

SHEET TITLE:
PROPOSED SECOND AND THIRD FLOOR PLANS

DATE: 04-04-18	DRAWN BY: BGO, MB
SCALE: AS NOTED	CHECKED BY: PRS

A-2.1

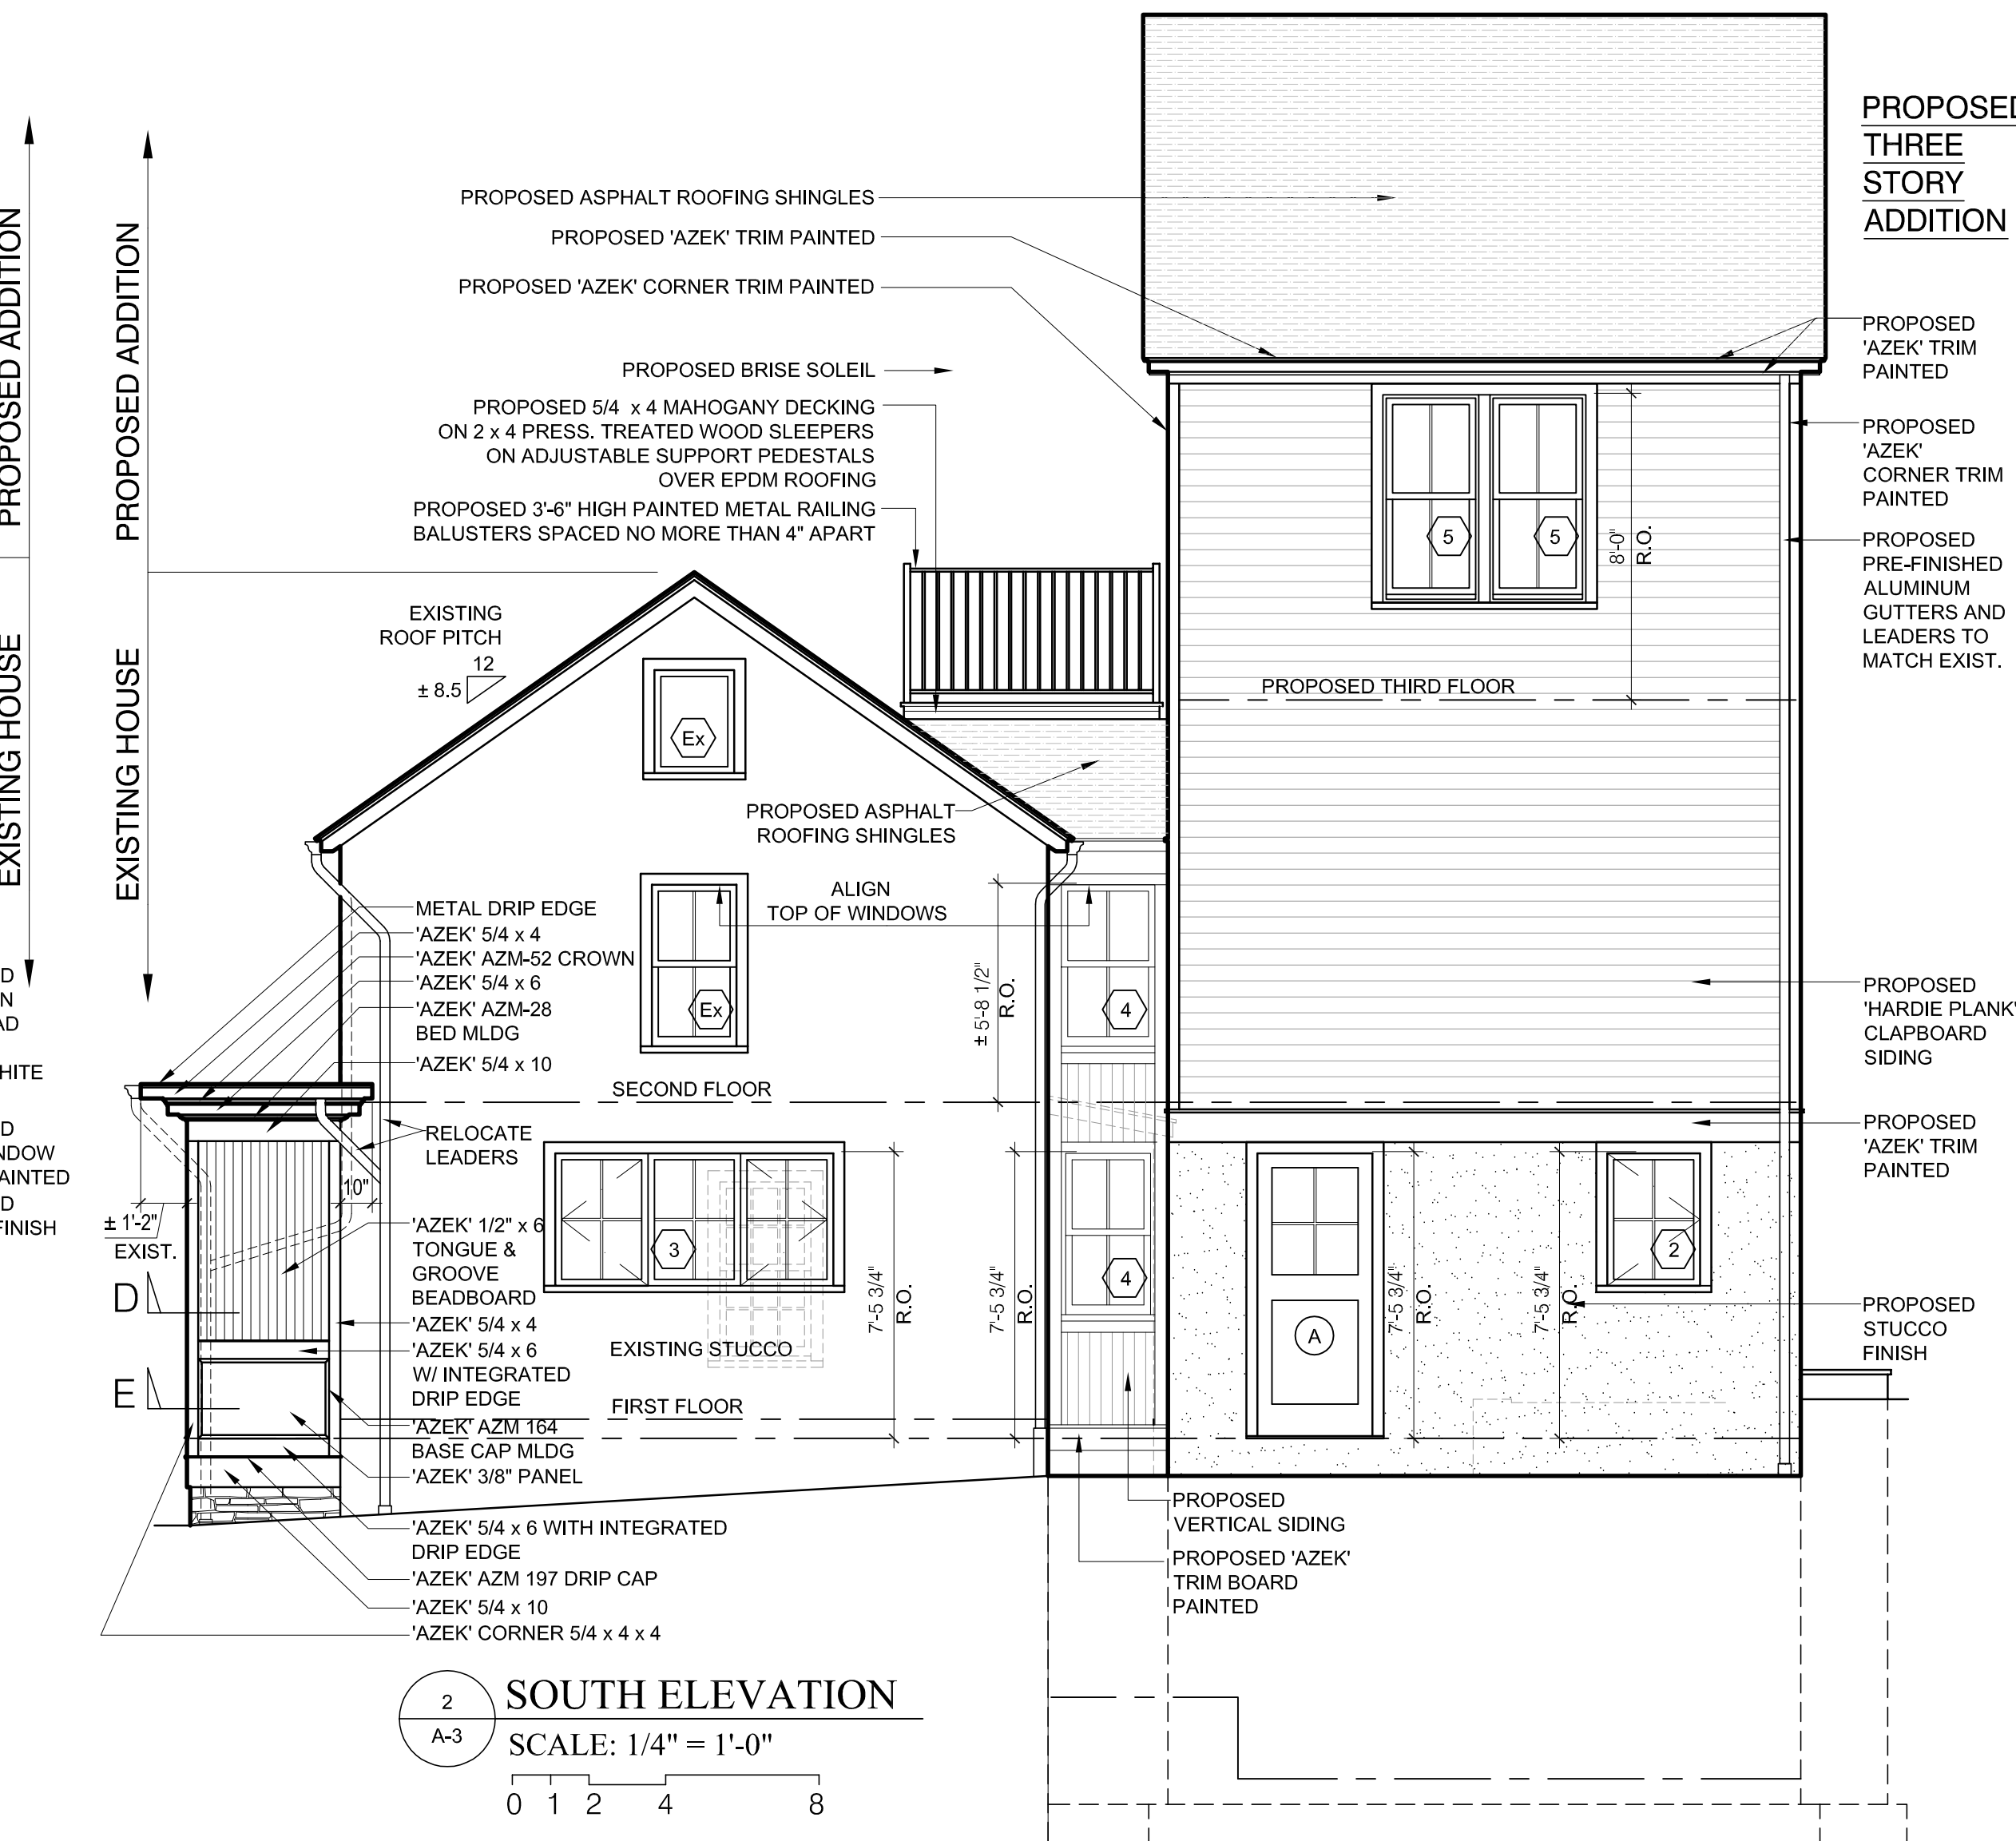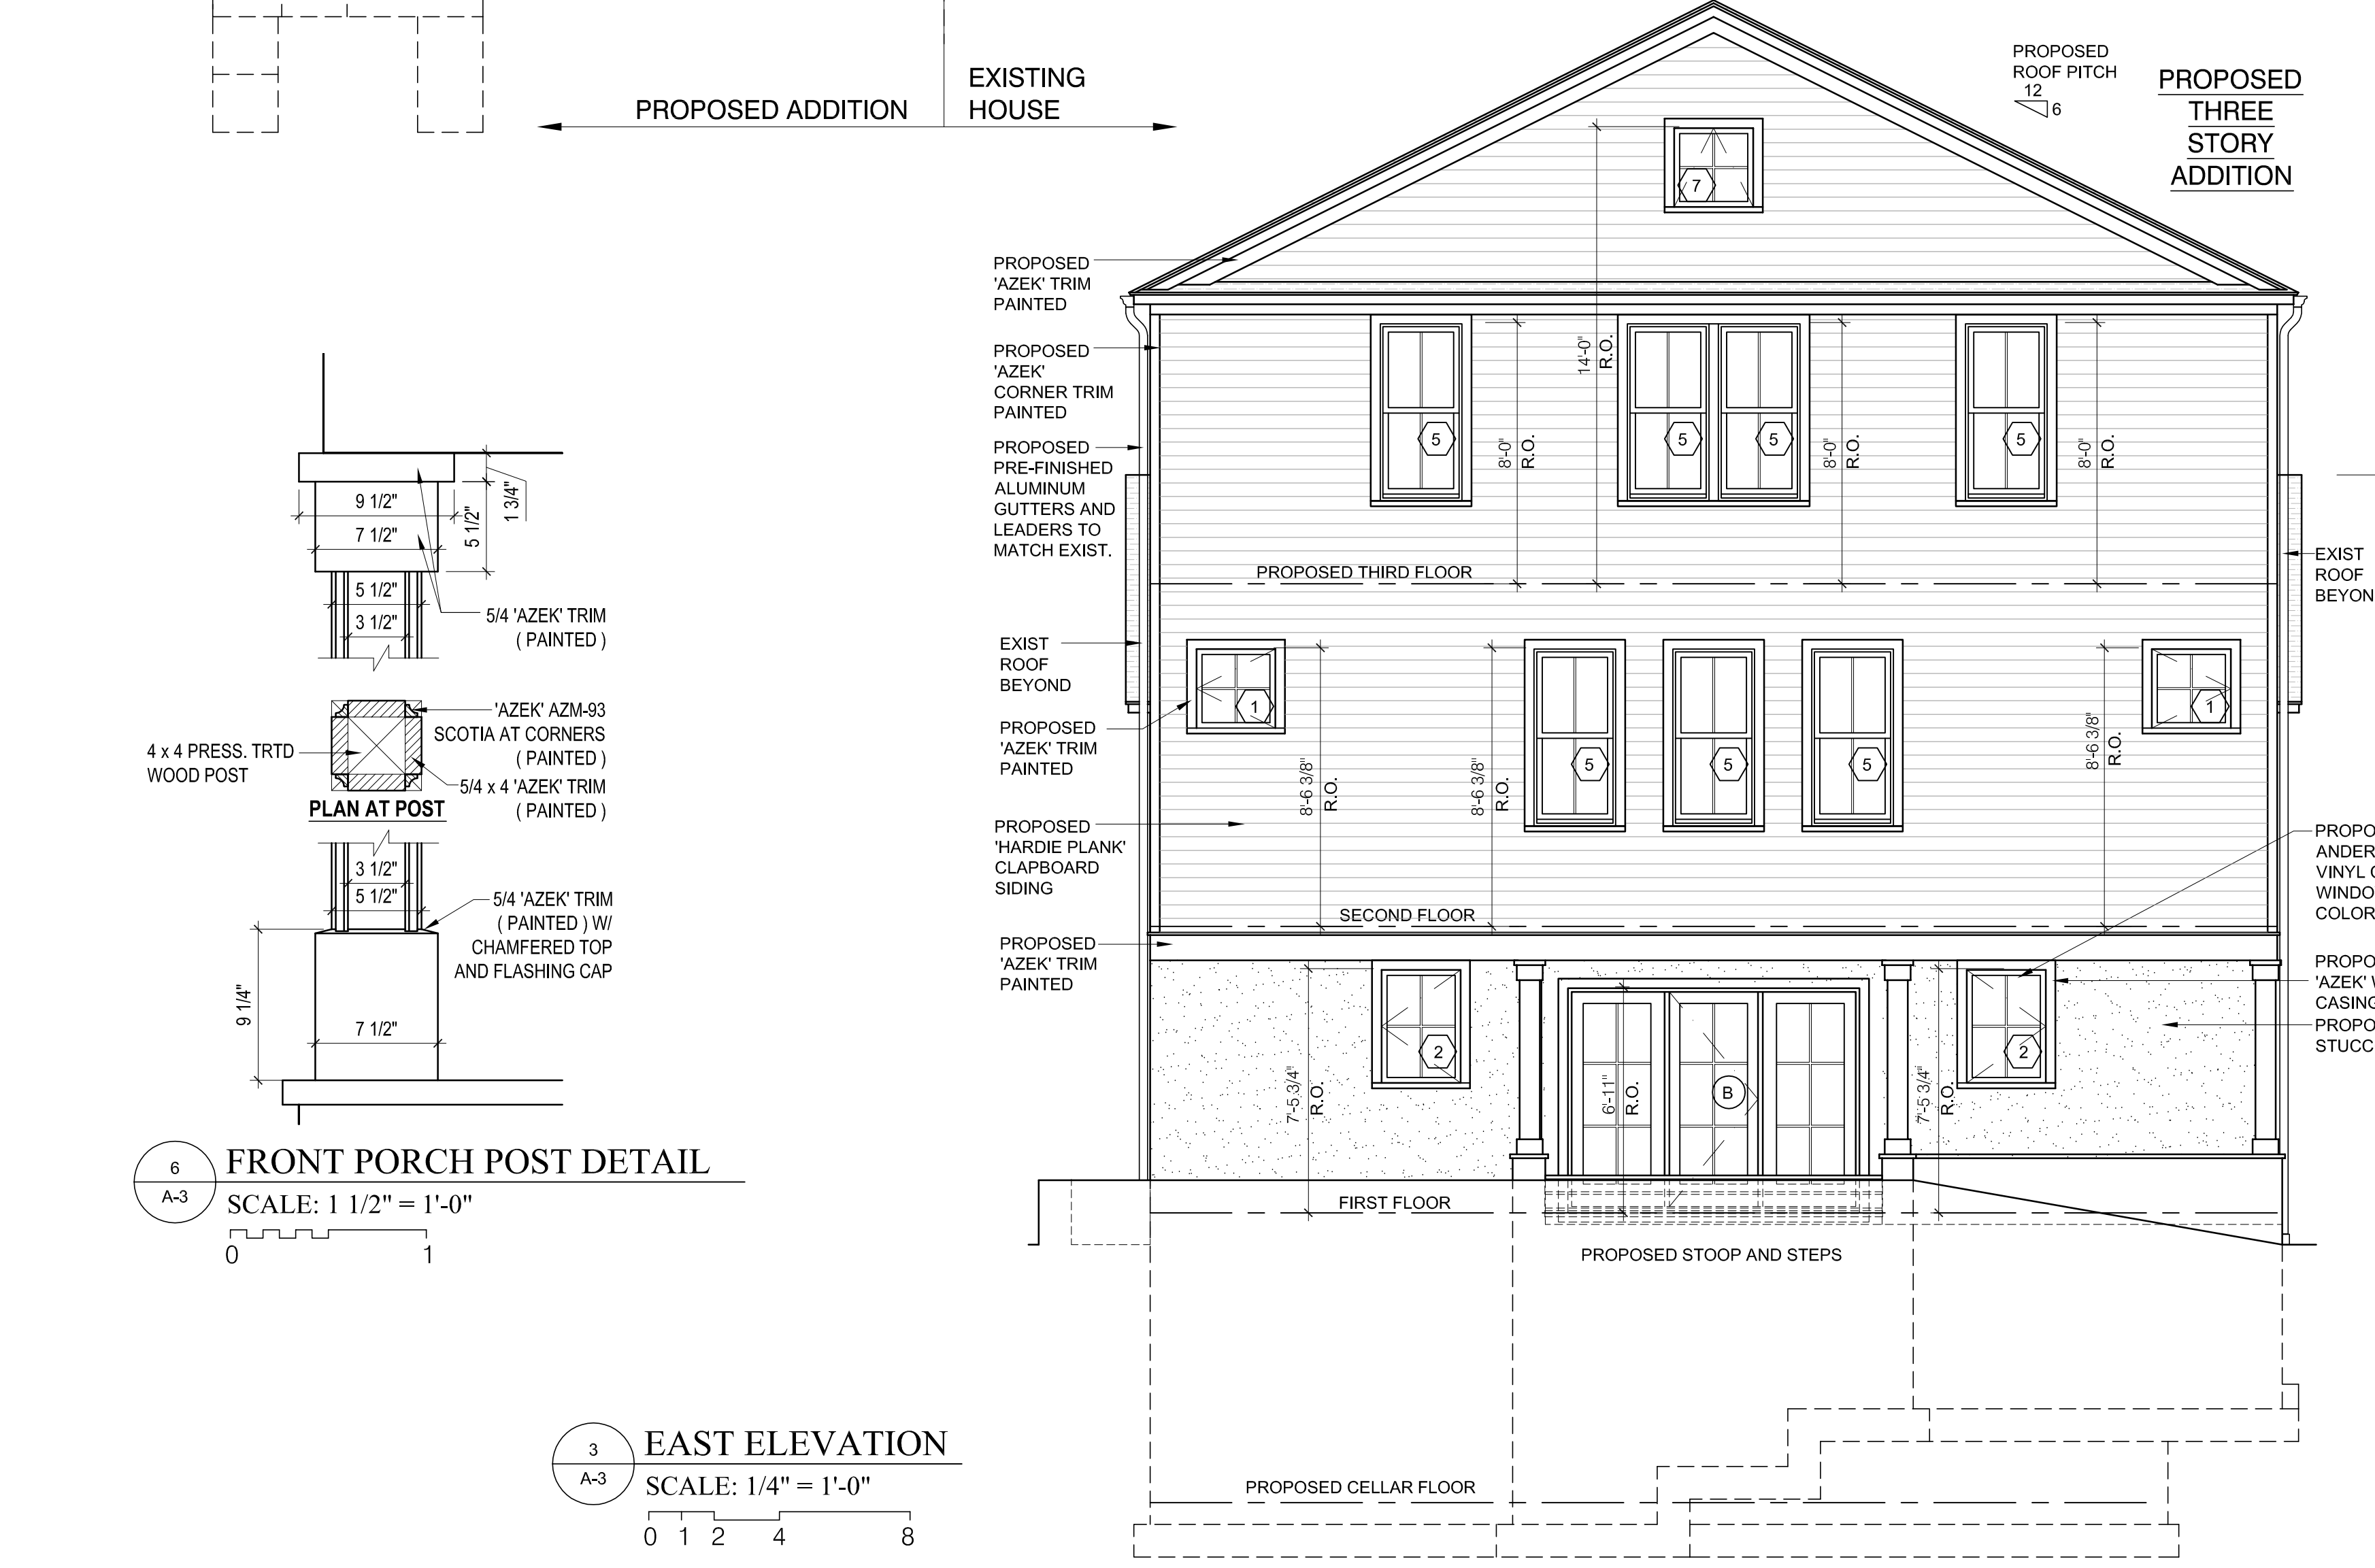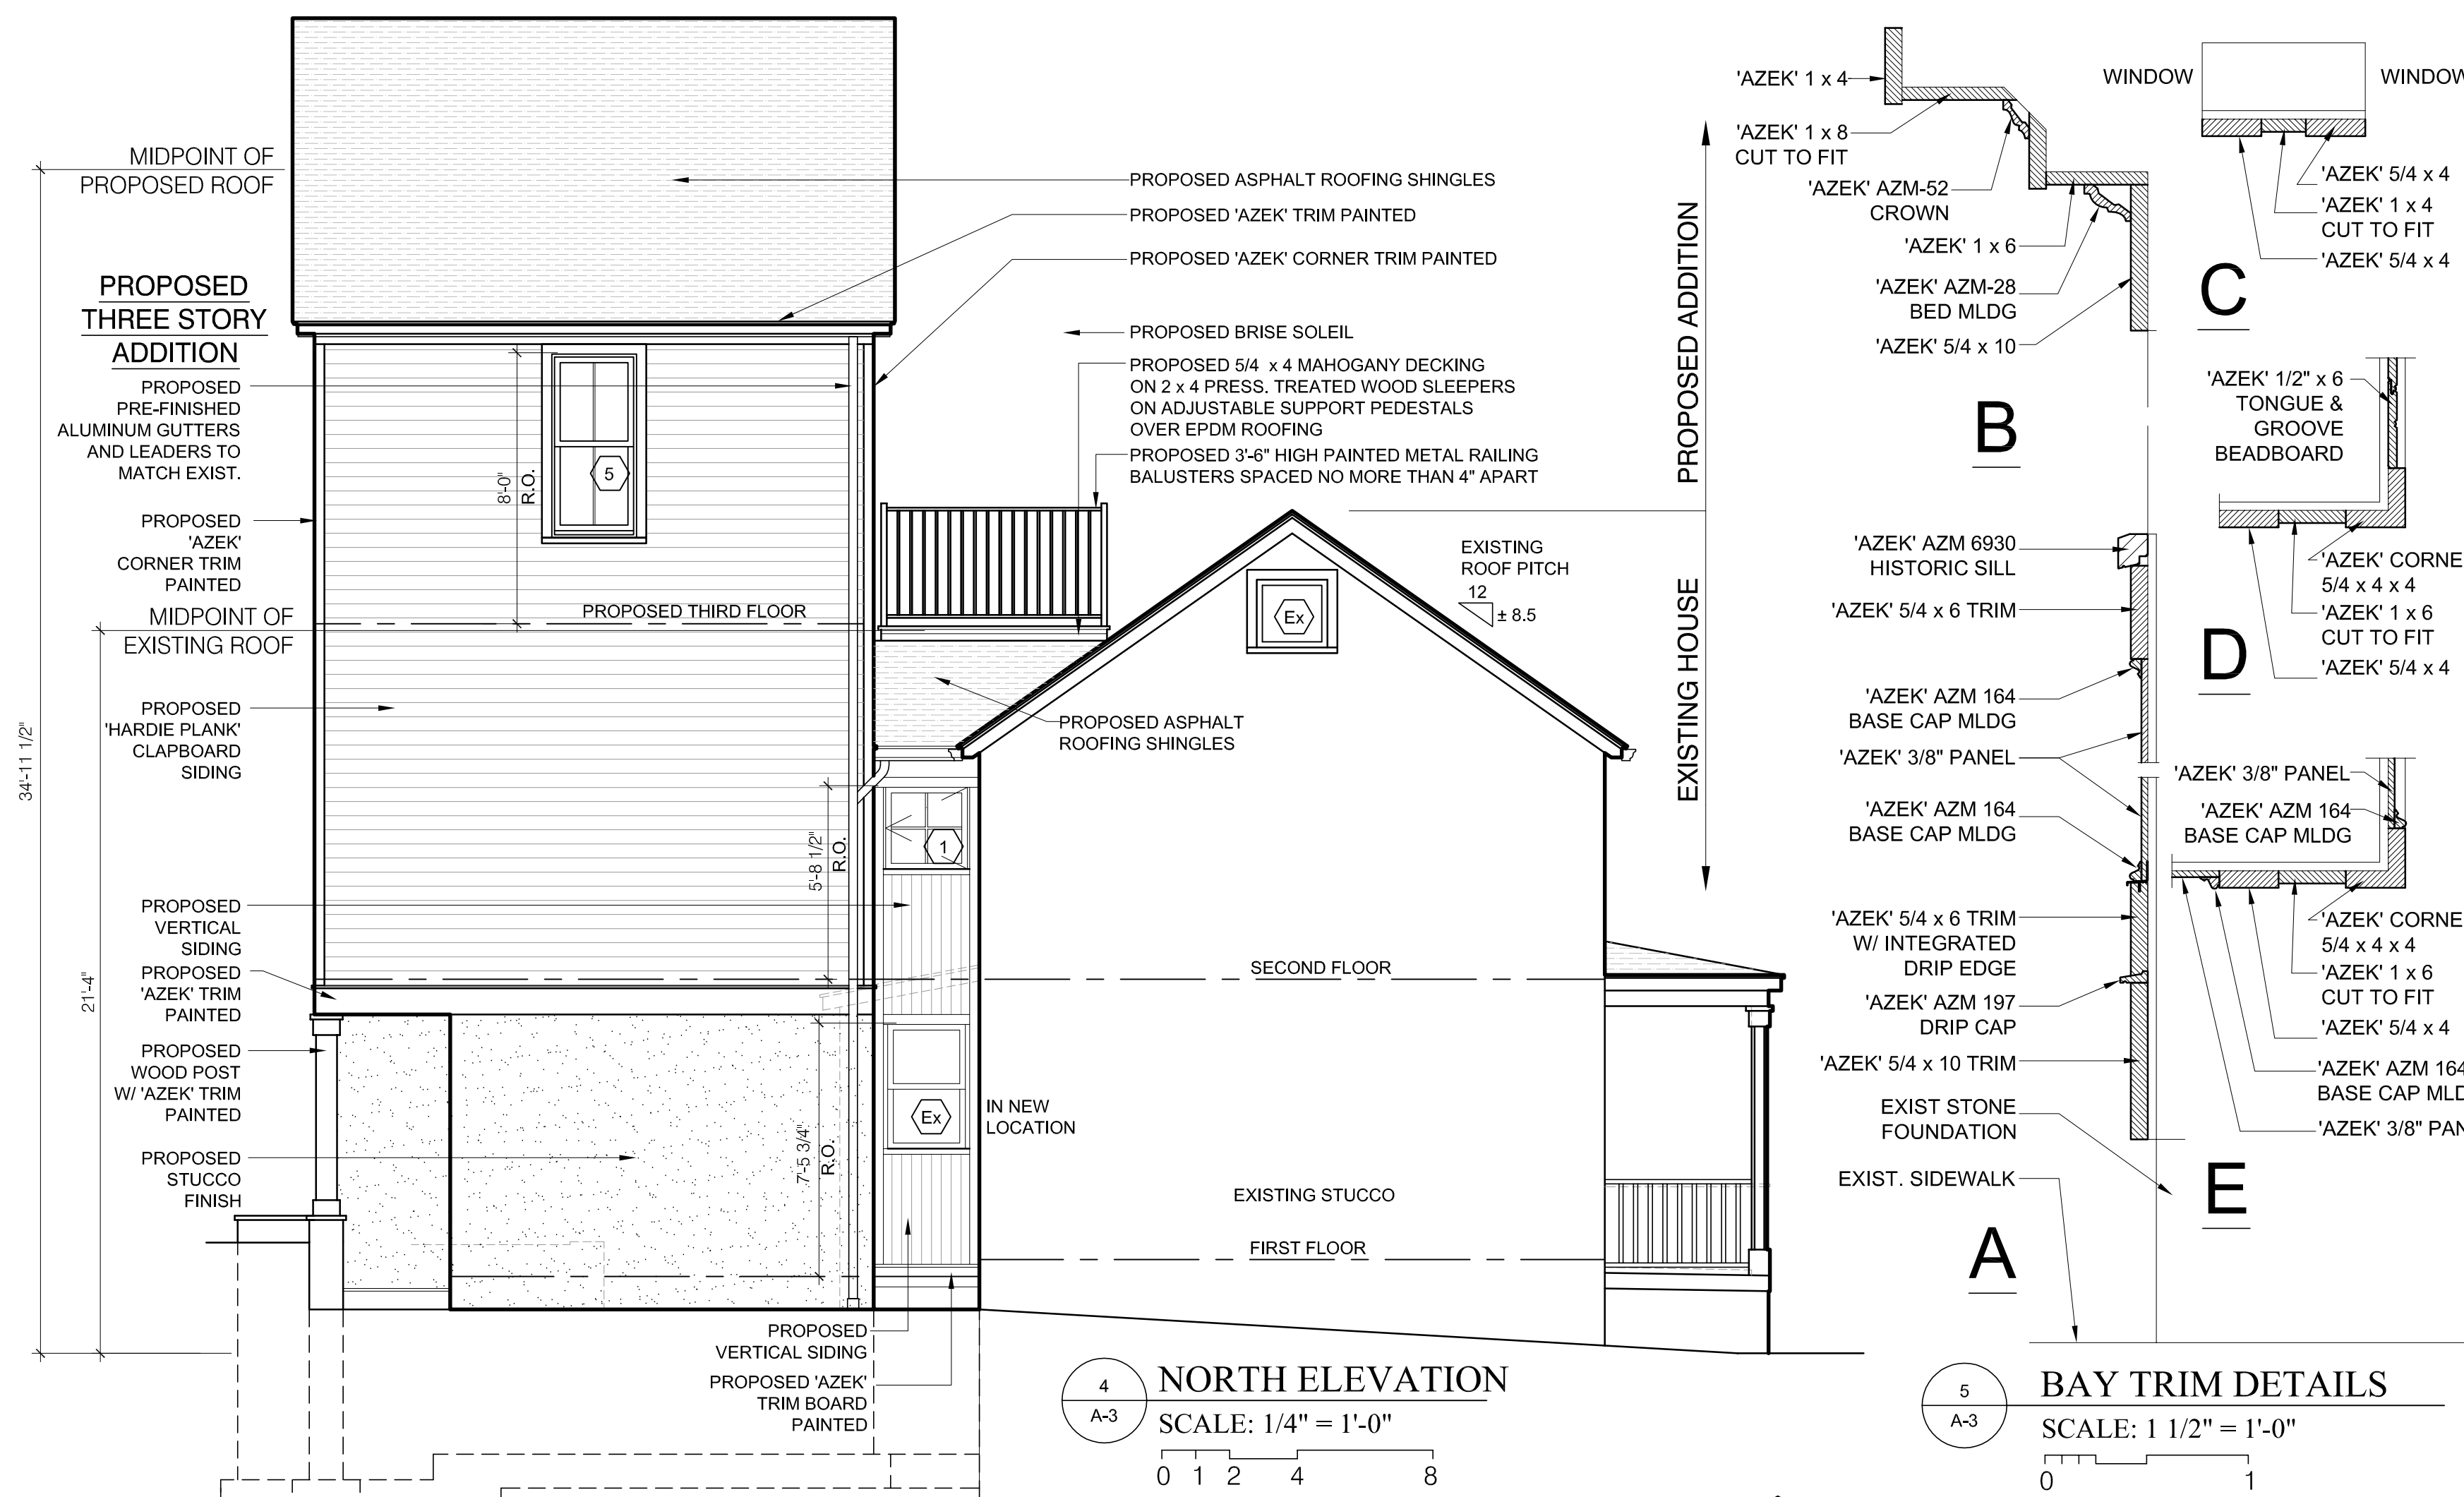

ROYAL CONSTRUCTION
ENGINEERING SERVICES PC
27 MAIN STREET
DOBBS FERRY, N.Y. 10522
TEL: 914 479-5040
abe@royal-newyork.com
N.Y.S. LICENSE No. 079548

PROJECT TITLE:
NOYES RESIDENCE
130 PALISADE STREET
DOBBS FERRY, NEW YORK 10522
PROJECT NO.: 1801

GOTHAM DESIGN
AND COMMUNITY DEVELOPMENT LTD.


329 Broadway
Dobbs Ferry, N.Y. 10522
Phone: (914) 693-5093
Fax: (914) 693-5390
email: arch329@gmail.com

ISSUED / REVISIONS		
04-04-18	AHRB SUBMISSION	
REVISED		04-10-18
04-17-18	AHRB SUBMISSION	
REVISED		04-27-18
REVISED		05-08-18
REVISED		06-26-18
1. ADDED WINDOW AND DOOR SWINGS		
2. ADDED WINDOW AND DOOR SCHEDULE		
ISSUED		07-24-18
ISSUED FOR CONSTRUCTION		09-13-18
REVISED		02-12-19
1. EAST ELEVATION		
2. ADDED ROOF SKIRT		
REVISED		04-02-19
2. ADDED BAY TRIM DETAILS		
AS-BUILT		02-15-22

SHEET TITLE: PROPOSED ELEVATIONS AND BUILDING SECTION	
DATE: 04-04-18	DRAWN BY: BGO
SCALE: AS NOTED	CHECKED BY: PRS
A-3	

WINDOW AND EXTERIOR DOOR SCHEDULE									
SYM	MANUF.	TYPE	NUMBER	ROUGH OPENING	QUANTITY	GLAZING	GRILLES	U-FACTOR	NOTES
1	ANDERSEN	CASEMENT	CW 125	2'-4 7/8" x 2'-4 7/8"	3 (2L, 1R)	FDL - LOW E 4	2W 2H	0.28	2 L UNITS INTERIOR VINYL WRAPPED, 1R UNIT TO BE TEMPERED GLASS
2	ANDERSEN	CASEMENT	CW 135	2'-4 7/8" x 3'-5 5/8"	3 (1L, 2R)	FDL - LOW E 4	2W 2H	0.28	1R UNIT TO BE TEMPERED GLASS
3	ANDERSEN	CASEMENT	CW 335	7'-1 1/8" x 3'-5 5/8"	1 (L,F,R)	FDL - LOW E 4	2W 2H	0.28	
4	ANDERSEN	TILT WASH DBL HUNG	TW 24310	2'-6 1/8" x 4'-0 7/8"	2	FDL - LOW E 4	2 OVER 2	0.31	
5	ANDERSEN	TILT WASH DBL HUNG	TW 2452	2'-6 1/8" x 3'-4 7/8"	14	FDL - LOW E 4	2 OVER 2	0.31	1 UNIT TO BE TEMPERED GLASS IN LOWER SASH
6	ANDERSEN	TILT WASH DBL HUNG	TW 30410	3'-2 1/8" x 5'-0 7/8"	3	FDL - LOW E 4	2 OVER 2	0.31	
7	ANDERSEN	AWNING	AW21	2'-4 7/8" x 2'-4 7/8"	2	FDL - LOW E 4	2W 2H	0.28	
8	ANDERSEN	TILT WASH DBL HUNG	CUSTOM	2'-3 3/4" x 3'-6 1/4"	1	FDL - LOW E 4	2 OVER 2	0.31	
9	ANDERSEN	TILT WASH DBL HUNG	CUSTOM	2'-9 5/8" x 4'-7 5/8"	2	FDL - LOW E 4	2 OVER 2	0.31	
A				3'-2 1/2" x 7'-6"	1		2W2H	0.XX	
B	ANDERSEN	INSWING FRENCH DR	FWH 90611 - 3	9'-0" x 6'-11"	1 (S, R, S)	FDL - LOW E 4	2W3H	0.31	
C	ANDERSEN	INSWING FRENCH DR	FWH 6080 APLR	6'-0" x 8'-0"	1	FDL - LOW E 4	2W3H	0.31	
ANDERSEN WINDOW AND DOOR NOTES: 1. DOORS AND WINDOWS - ANDERSEN 400 SERIES 2. GLAZING - FULL DIVIDED LIGHT WITH SPACER BAR									


INTERIOR DOOR SCHEDULE							
SYM	MANUF	TYPE	TYPE	SIZE	ROUGH OPENING	QUANTITY	NOTES
E		SWINGING DOOR		2'-6" x 6'-8"	2'-8" x 6'-10 1/2"	2	
F		SWINGING DOOR		3'-0" x 6'-8"	3'-2" x 6'-10 1/2"	4	
G		SWINGING DOOR		3'-0" x 6'-8"	3'-2" x 6'-10 1/2"	1	3/4 HR FIRE RATED W/SELF CLOS. MECHANISM
H		SWINGING DOOR		(2) 1'-8" x 6'-6"	3'-4" x 6'-8 1/2"	1	
J		SWINGING DOOR		(2) 1'-8" x 6'-8"	3'-4" x 6'-10 1/2"	5	
K		SWINGING DOOR		(2) 2'-0" x 6'-8"	4'-2" x 6'-10 1/2"	2	
L		POCKET DOOR		3'-0" x 6'-8"	6'-2" x 6'-10 1/2"	1	

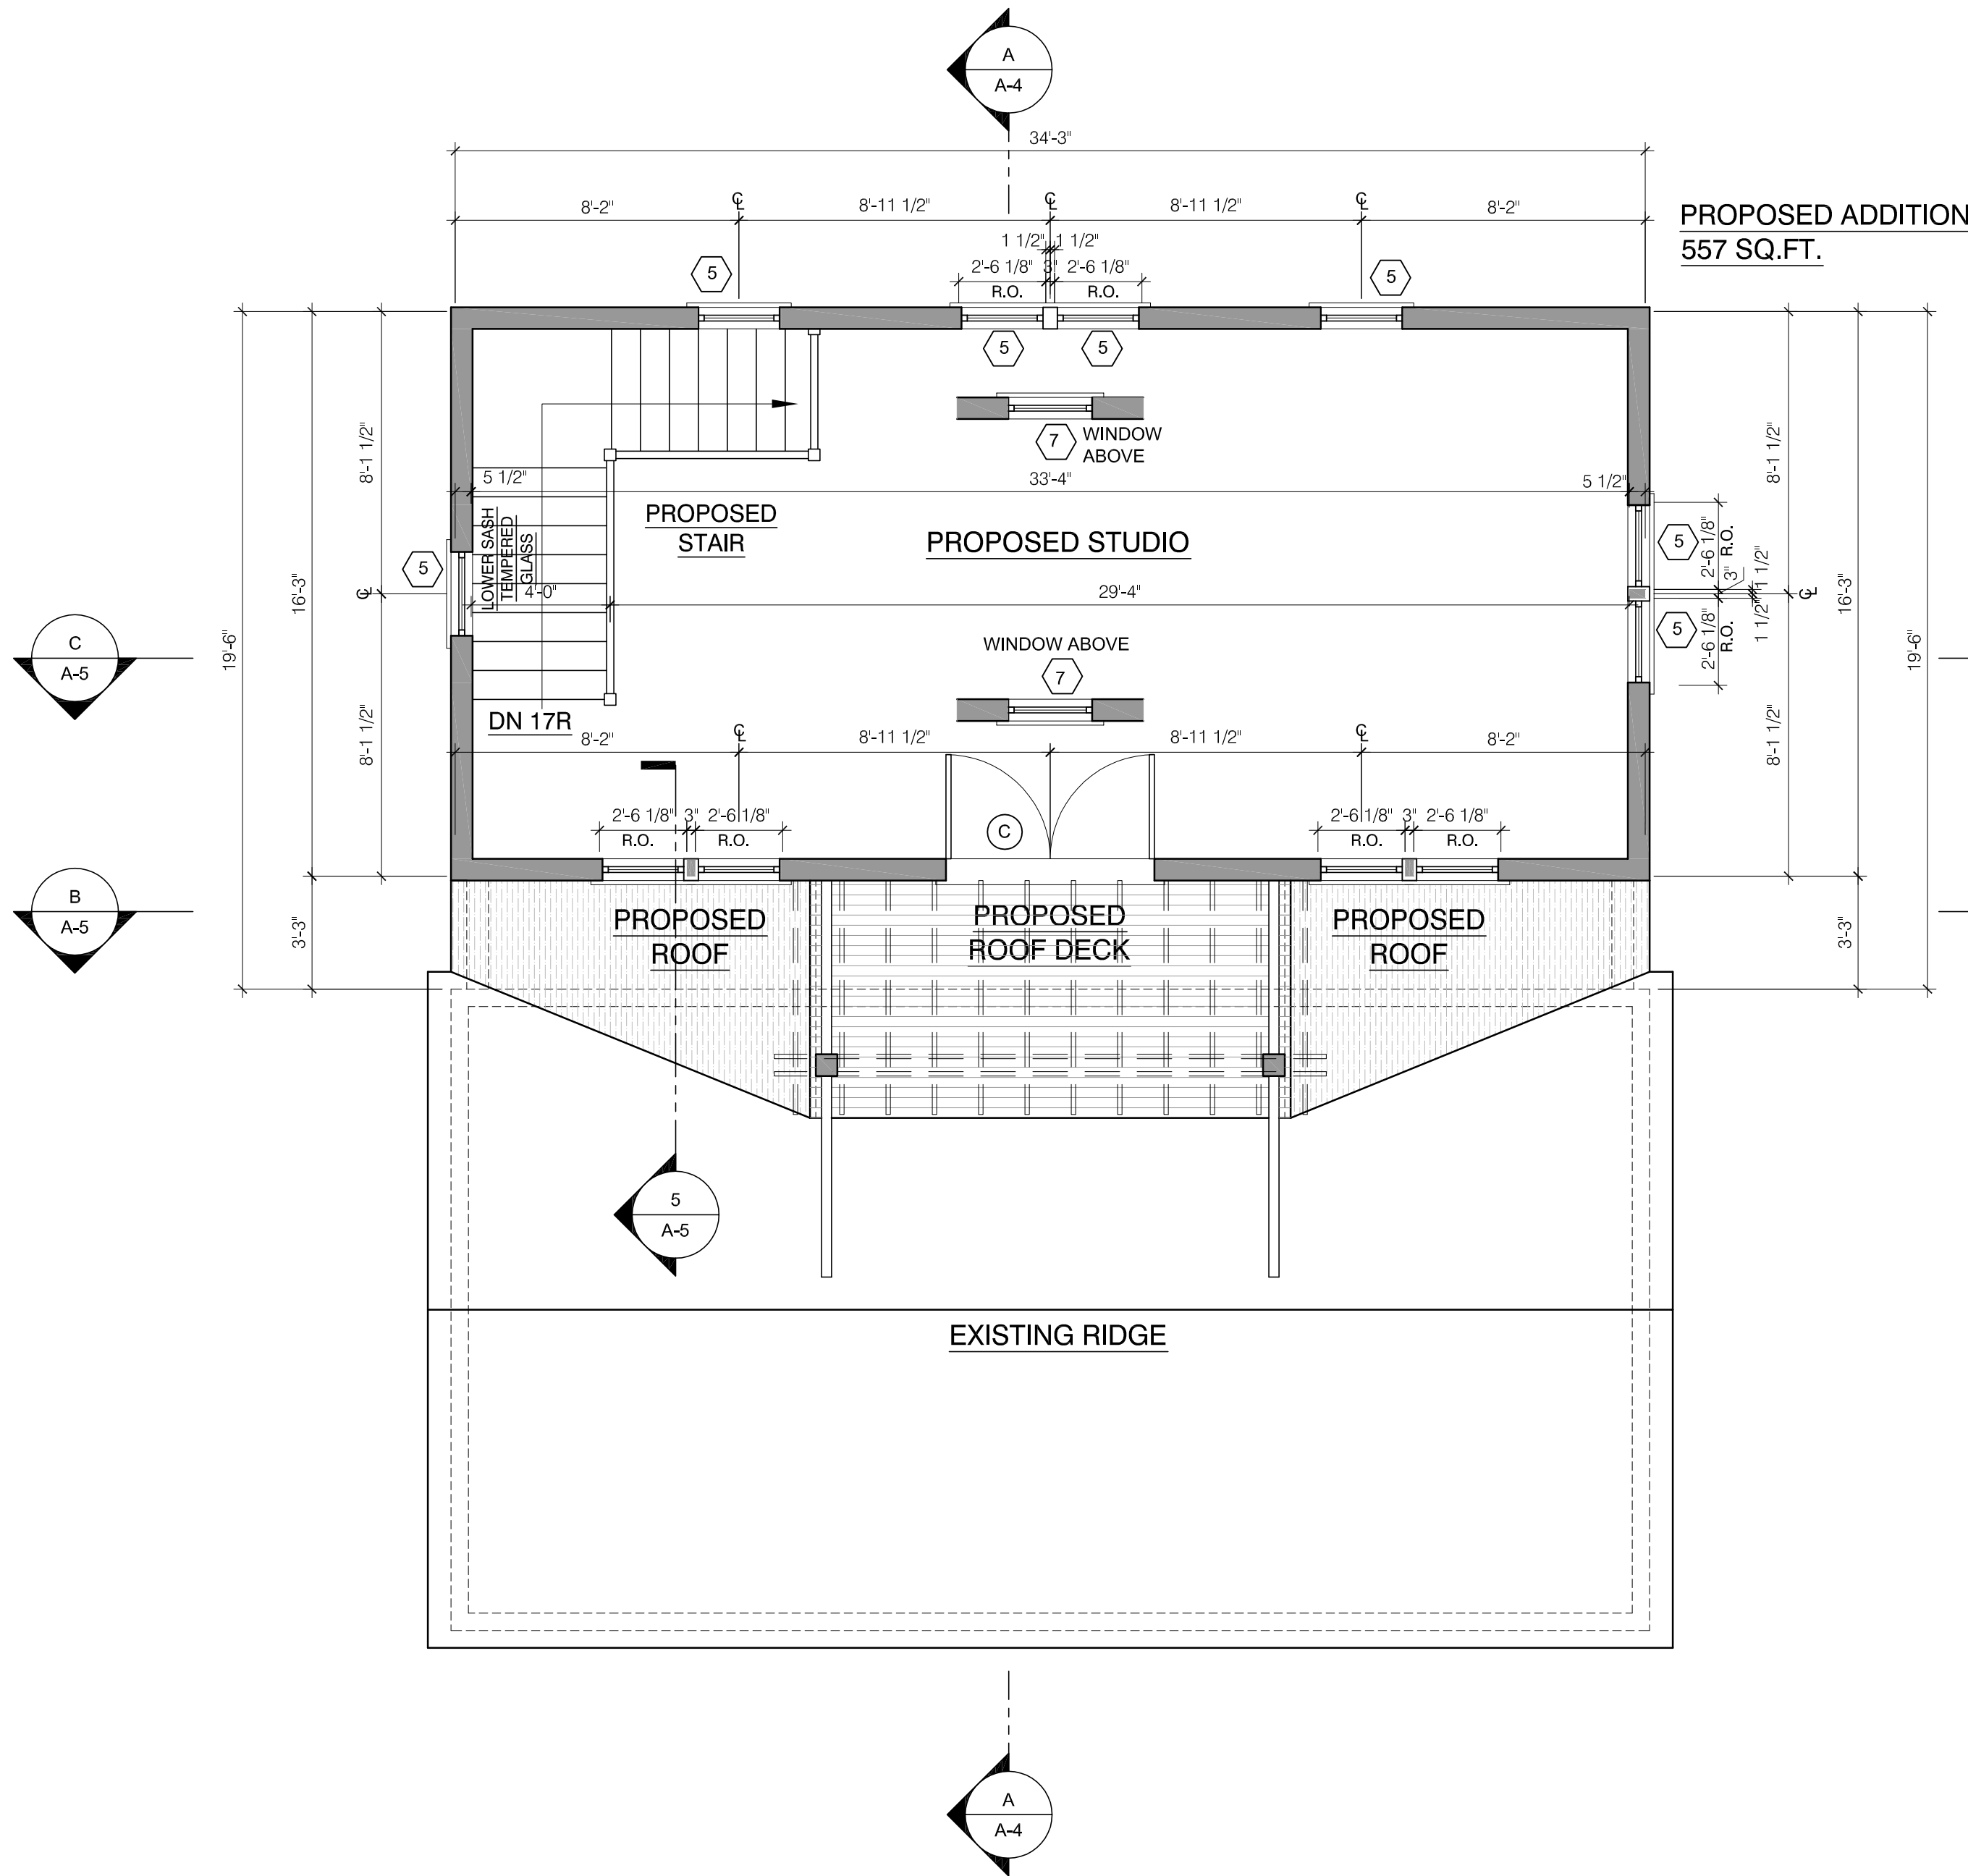

2 THIRD FLOOR PLAN
SCALE: 1/4" = 1'-0"


LEGEND

- EXISTING TO REMAIN
- EXISTING TO BE REMOVED
- PROPOSED WORK

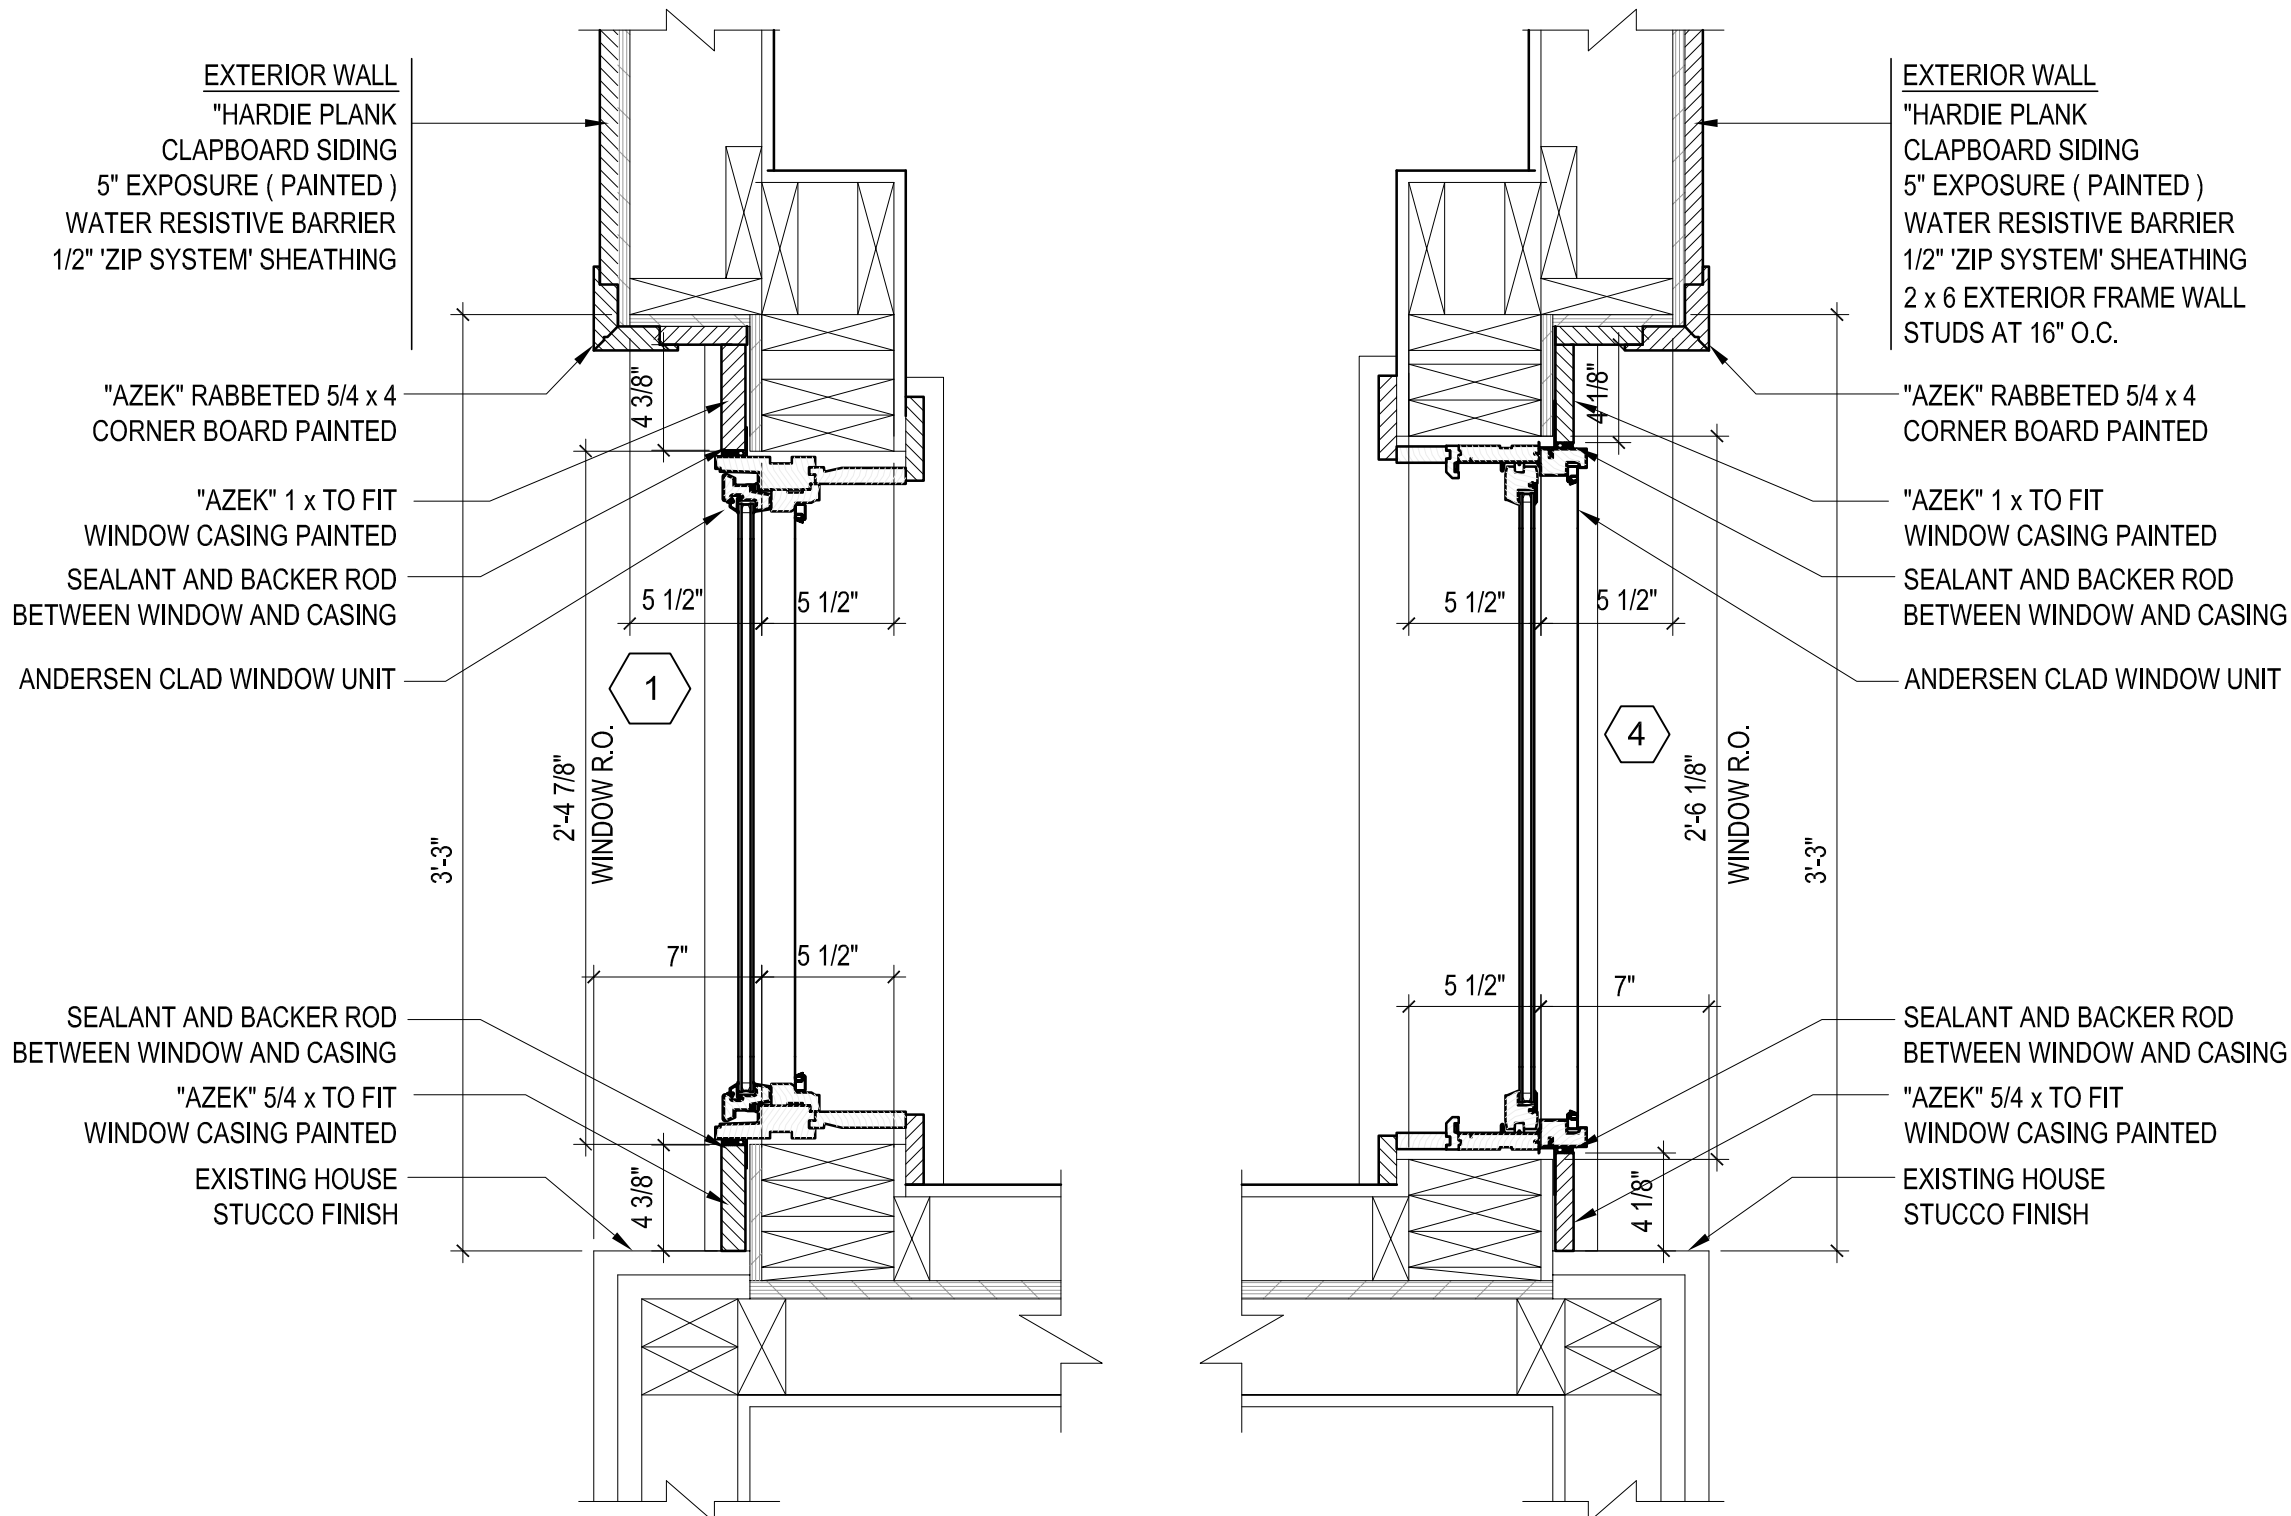


4 PLAN DETAIL
SCALE: 1 1/2" = 1'-0"

3 PLAN DETAIL
SCALE: 1 1/2" = 1'-0"

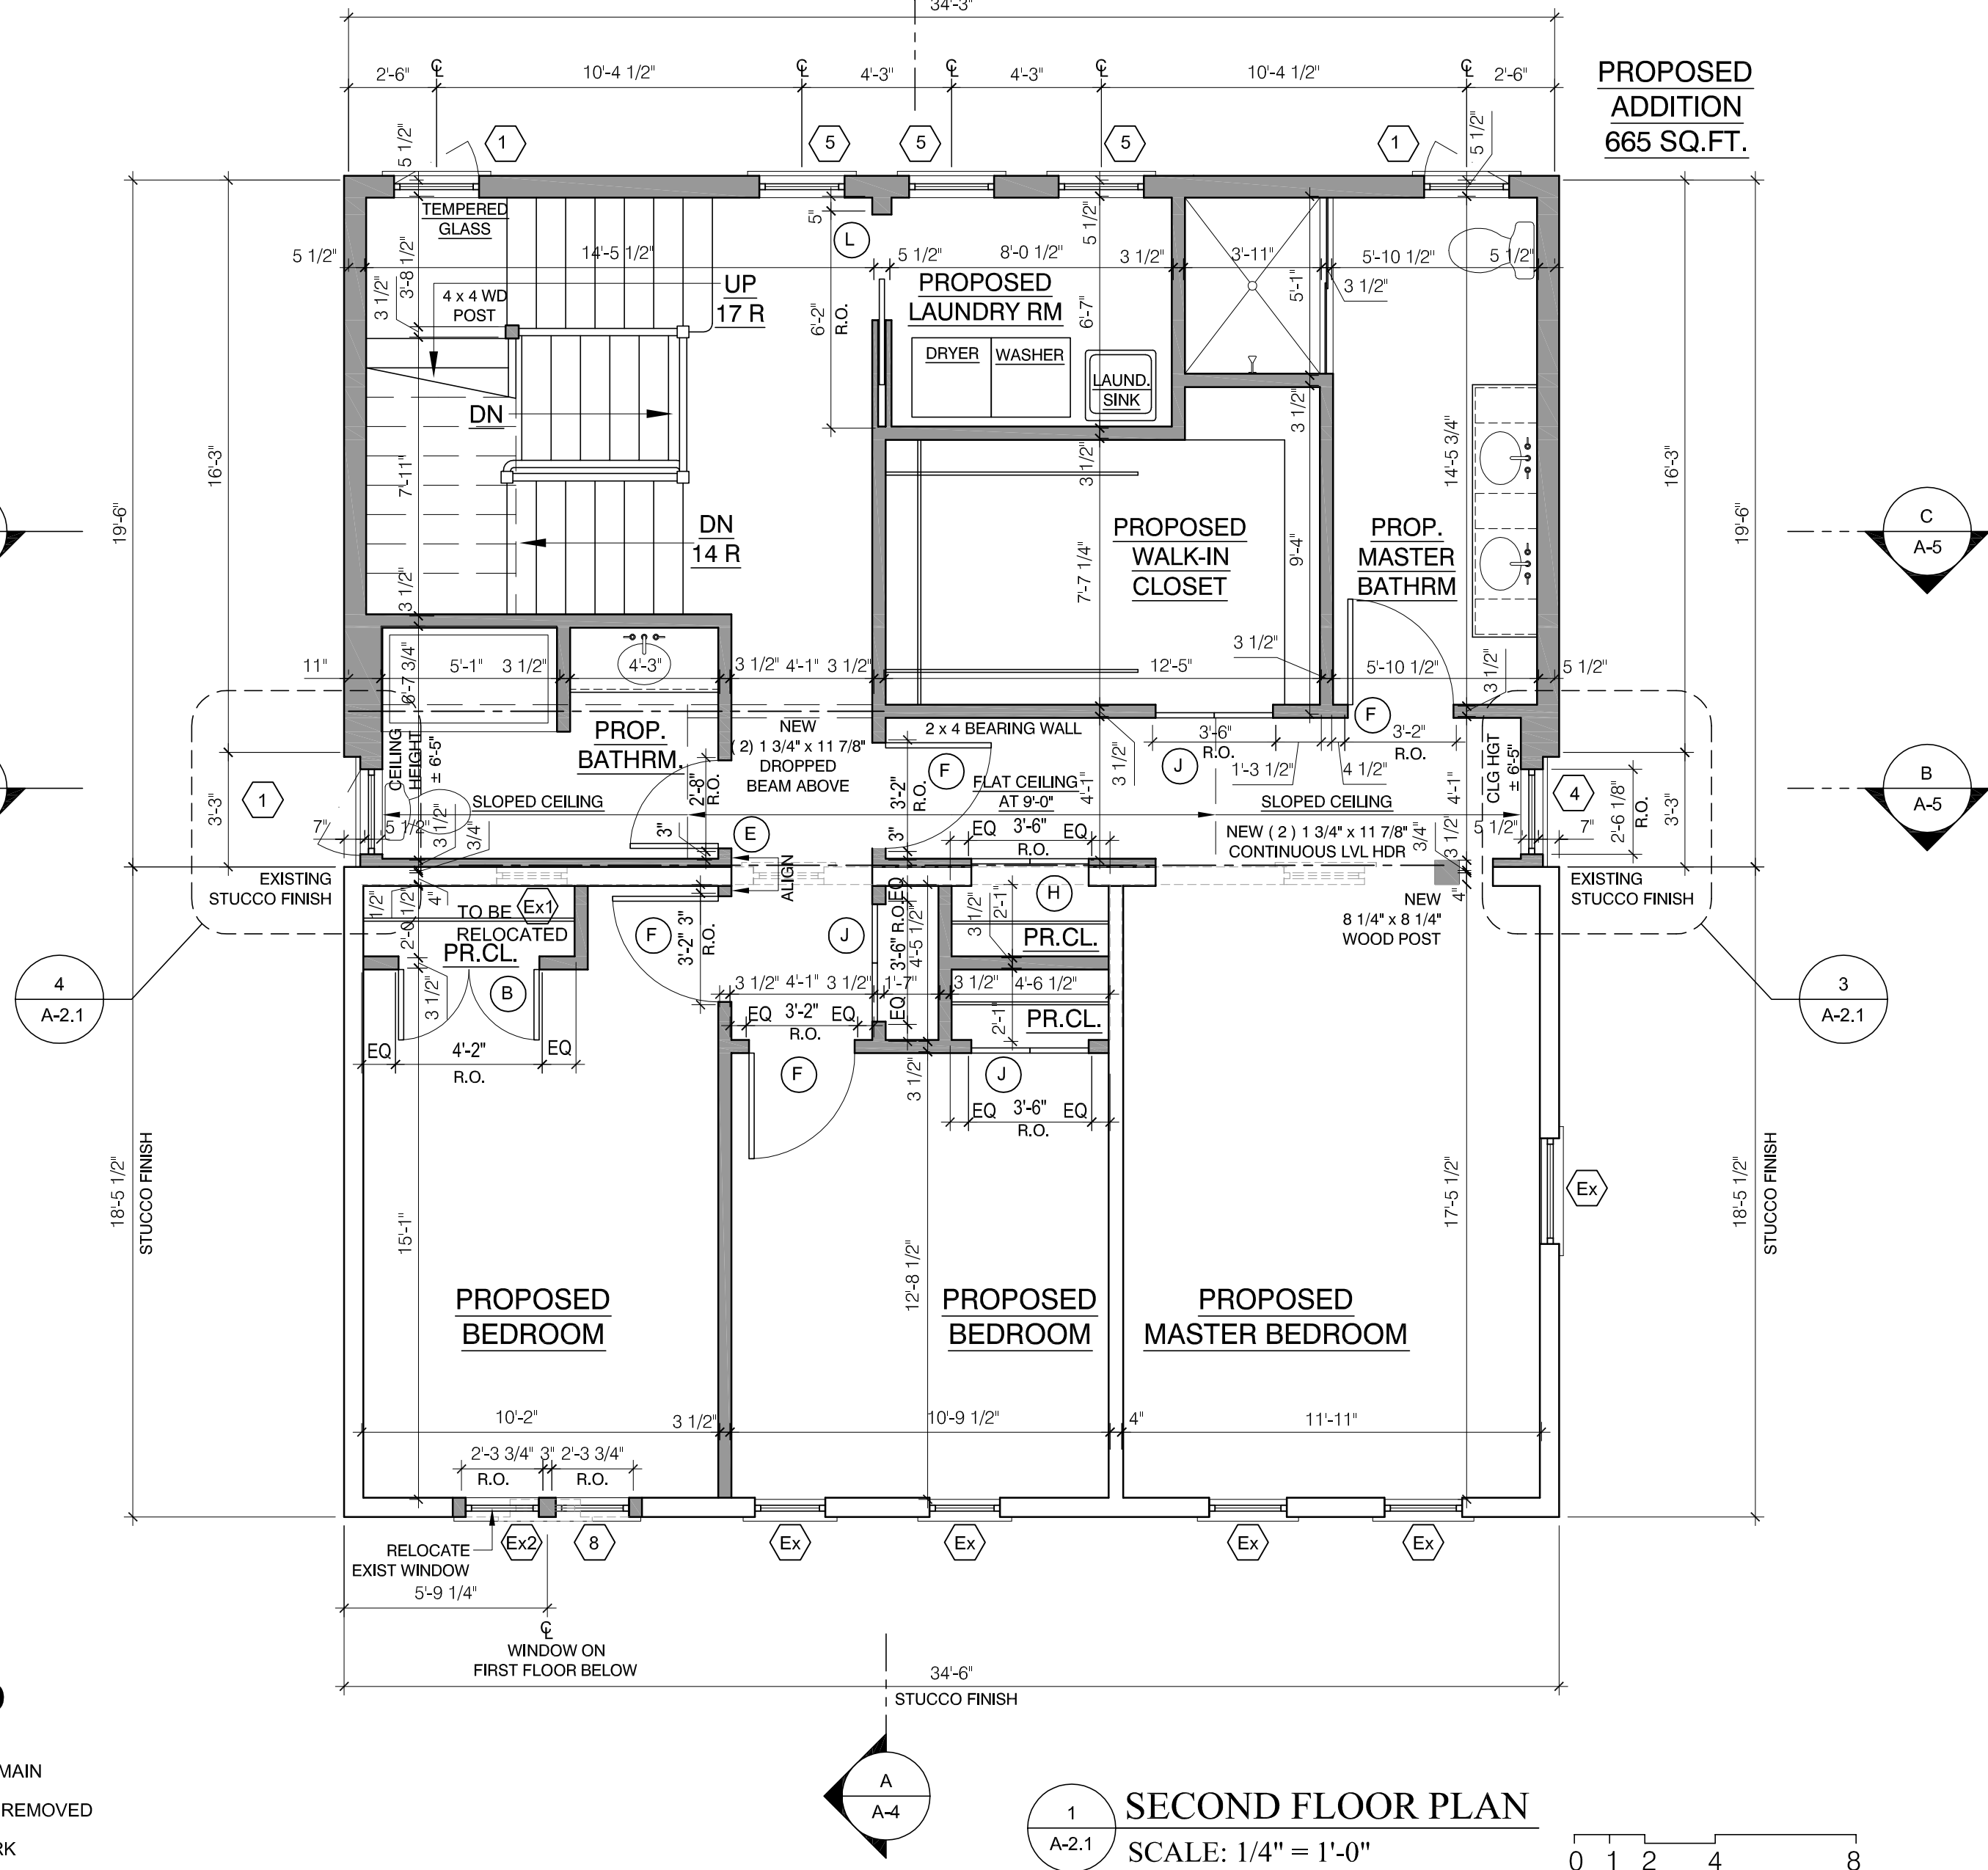

1 SECOND FLOOR PLAN
SCALE: 1/4" = 1'-0"

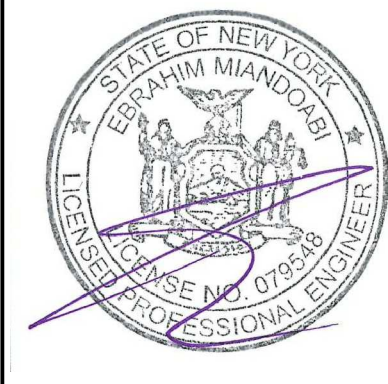

ROYAL CONSTRUCTION
ENGINEERING SERVICES PC
27 MAIN STREET
DOBBS FERRY, N.Y. 10522
TEL: 914 479-5040
abe@royal-newyork.com

N.Y.S. LICENSE No. 079548

PROJECT TITLE:
NOYES RESIDENCE

130 PALISADE STREET
DOBBS FERRY, NEW YORK 10522

PROJECT NO.: 1801

**GOTHAM
DESIGN**
AND COMMUNITY
DEVELOPMENT LTD.

329 Broadway
Dobbs Ferry, N.Y. 10522
Phone: (914) 693-5093
Fax: (914) 693-5390
email: arch329@gmail.com



ISSUED / REVISIONS	
04-04-18	AHRB SUBMISSION
REVISED	04-10-18
04-17-18	AHRB SUBMISSION
REVISED	04-27-18
REVISED	05-08-18
REVISED	06-26-18
1. ADDED WINDOW AND DOOR SWINGS	
2. NOTED WHICH WINDOWS ARE TEMPERED GLASS	
ISSUED	07-24-18
ISSUED FOR CONSTRUCTION	09-13-18

SHEET TITLE:

**PROPOSED
SECOND AND THIRD
FLOOR PLANS**

DATE: 04-04-18	DRAWN BY: BGO, MB
SCALE: AS NOTED	CHECKED BY: PRS

A-2.1

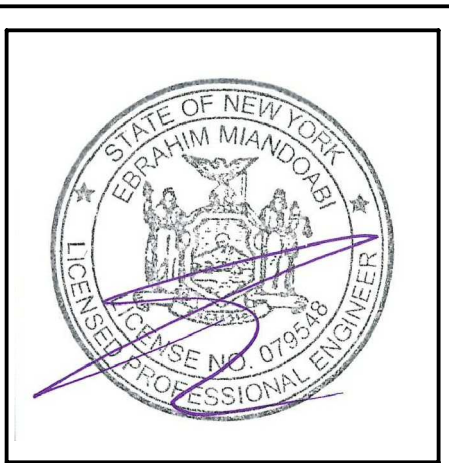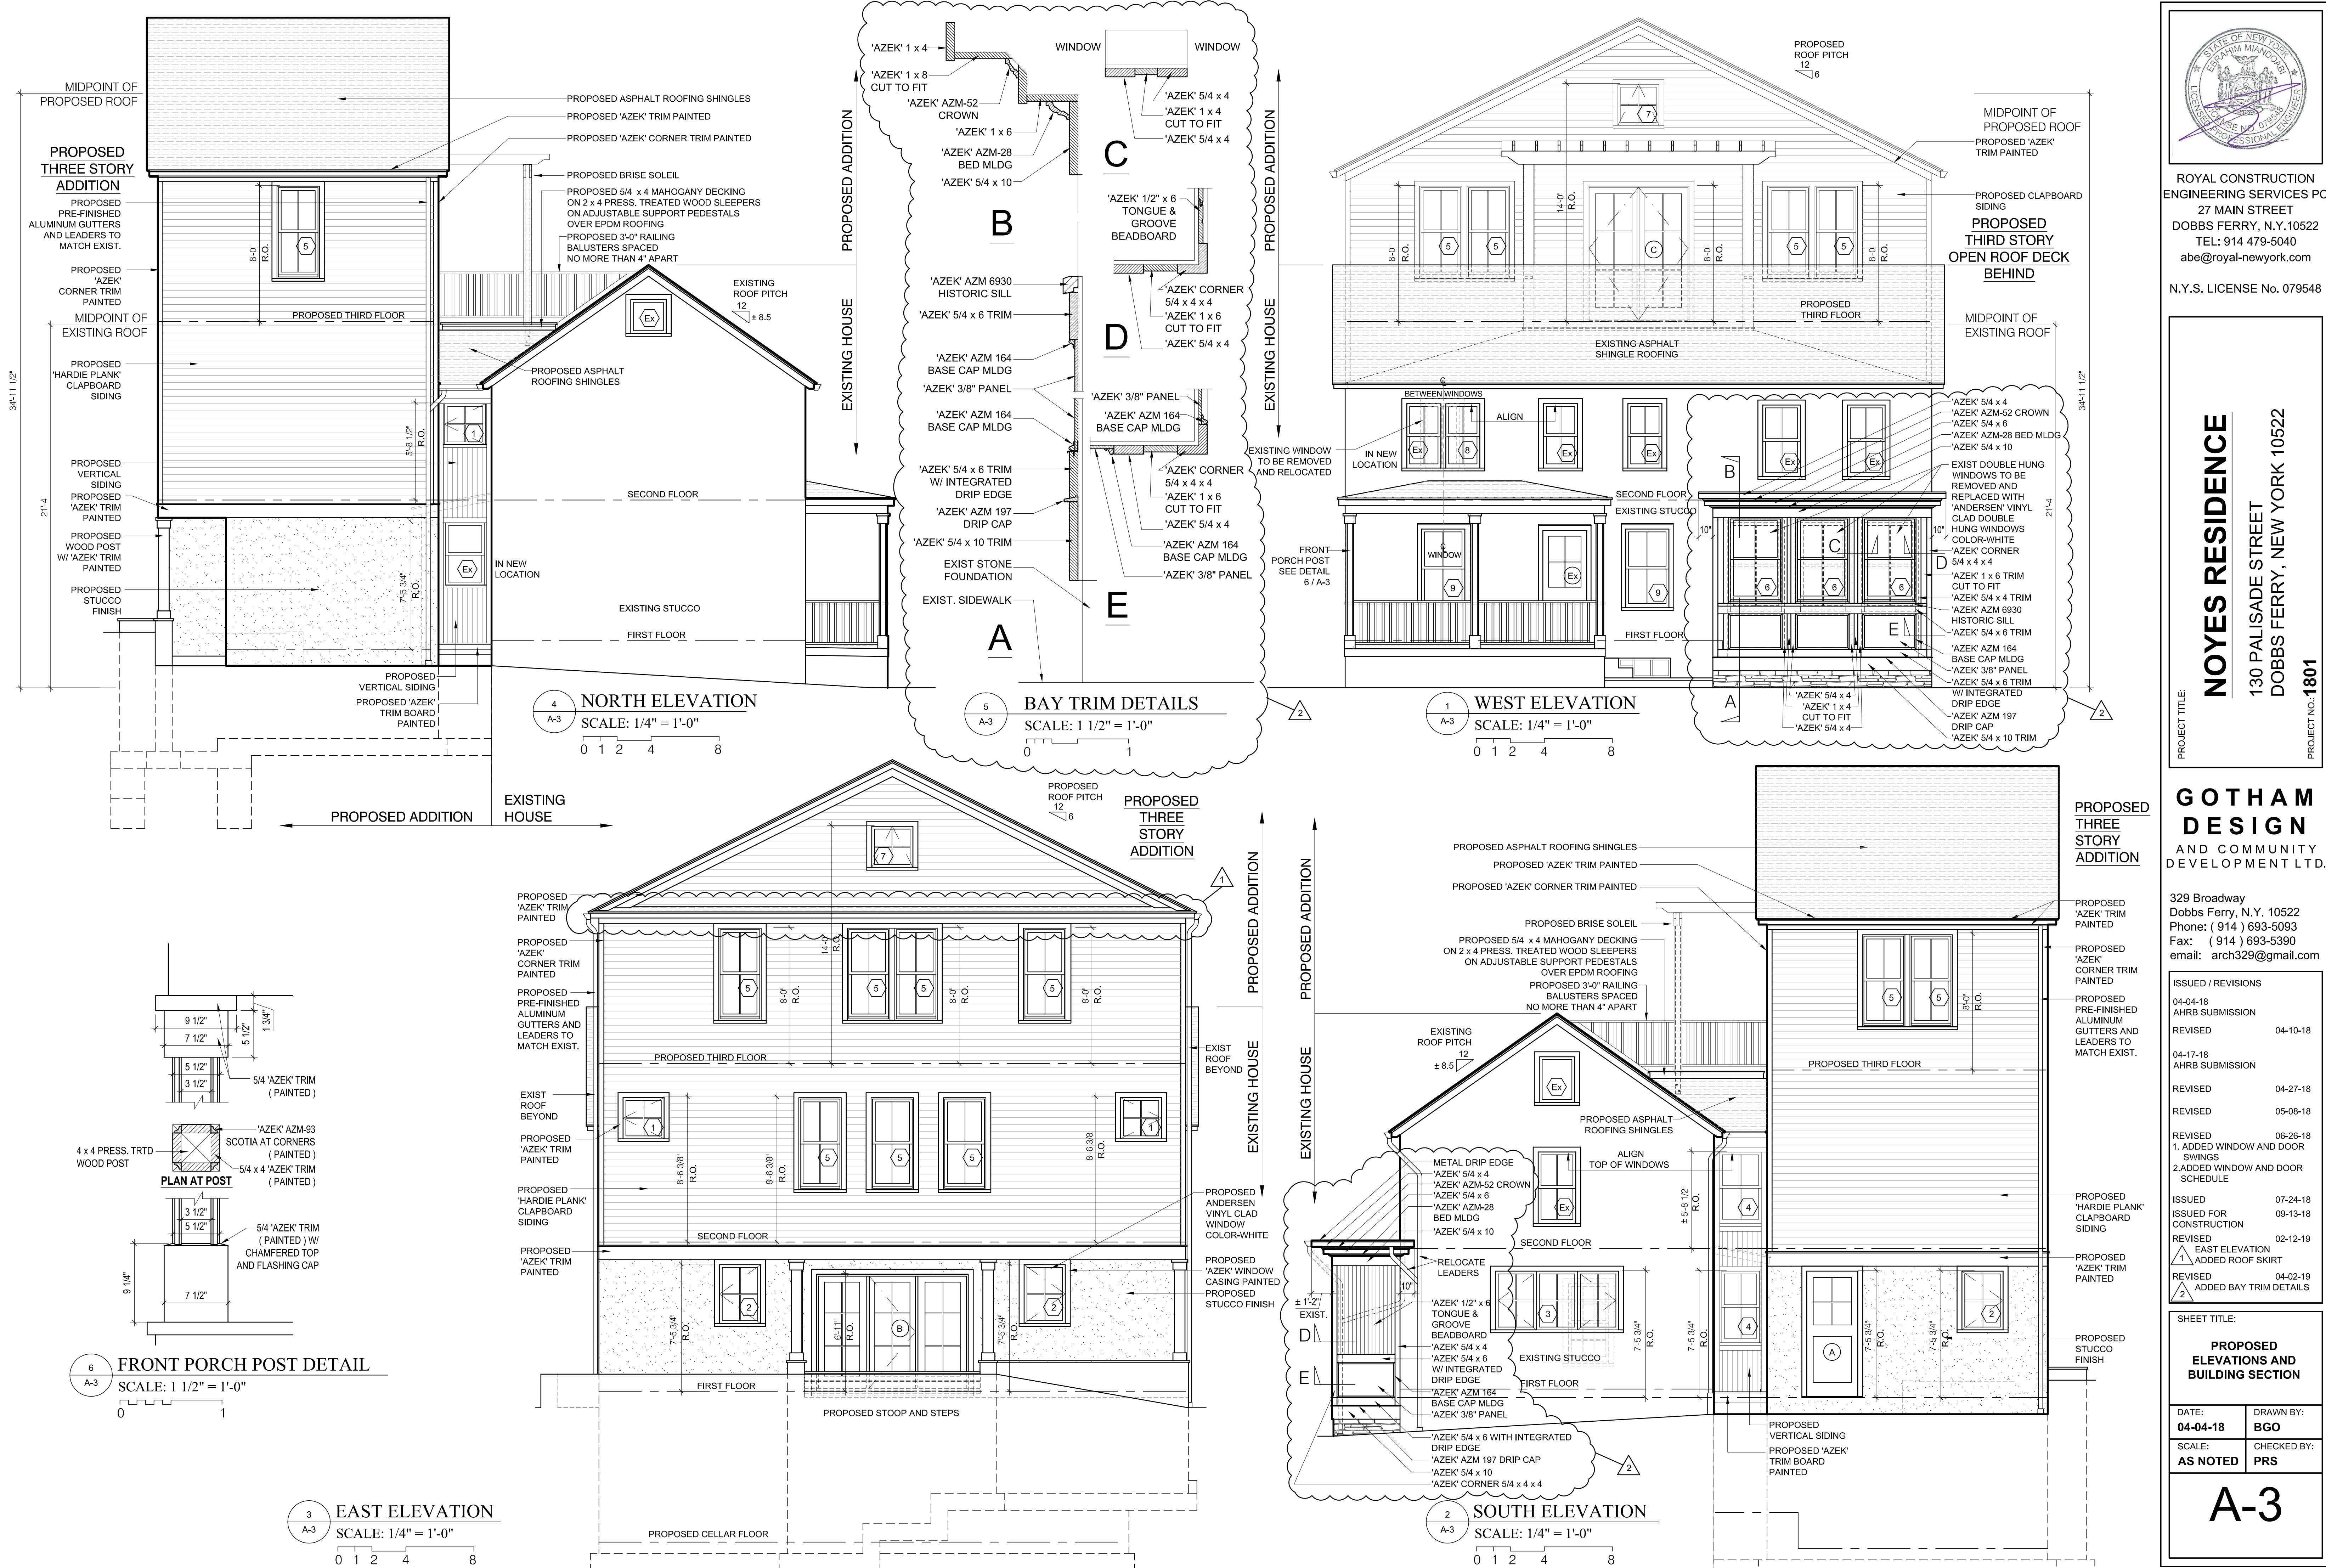

ROYAL CONSTRUCTION
ENGINEERING SERVICES PC
27 MAIN STREET
DOBBS FERRY, N.Y.10522
TEL: 914 479-5040
abe@royal-newyork.com
N.Y.S. LICENSE No. 079548

PROJECT TITLE:
NOYES RESIDENCE
130 PALISADE STREET
DOBBS FERRY, NEW YORK 10522
PROJECT NO.: 1801

GOTHAM DESIGN
AND COMMUNITY DEVELOPMENT LTD.

329 Broadway
Dobbs Ferry, N.Y. 10522
Phone: (914) 693-5093
Fax: (914) 693-5390
email: arch329@gmail.com

ISSUED / REVISIONS		
04-04-18	AHRB SUBMISSION	
REVISED		04-10-18
04-17-18	AHRB SUBMISSION	
REVISED		04-27-18
REVISED		05-08-18
REVISED		06-26-18
1. ADDED WINDOW AND DOOR SWINGS		
2. ADDED WINDOW AND DOOR SCHEDULE		
ISSUED		07-24-18
ISSUED FOR CONSTRUCTION		09-13-18
REVISED		02-12-19
1. EAST ELEVATION		
2. ADDED ROOF SKIRT		
REVISED		04-02-19
2. ADDED BAY TRIM DETAILS		

SHEET TITLE:
PROPOSED ELEVATIONS AND BUILDING SECTION

DATE: 04-04-18	DRAWN BY: BGO
SCALE: AS NOTED	CHECKED BY: PRS

A-3