


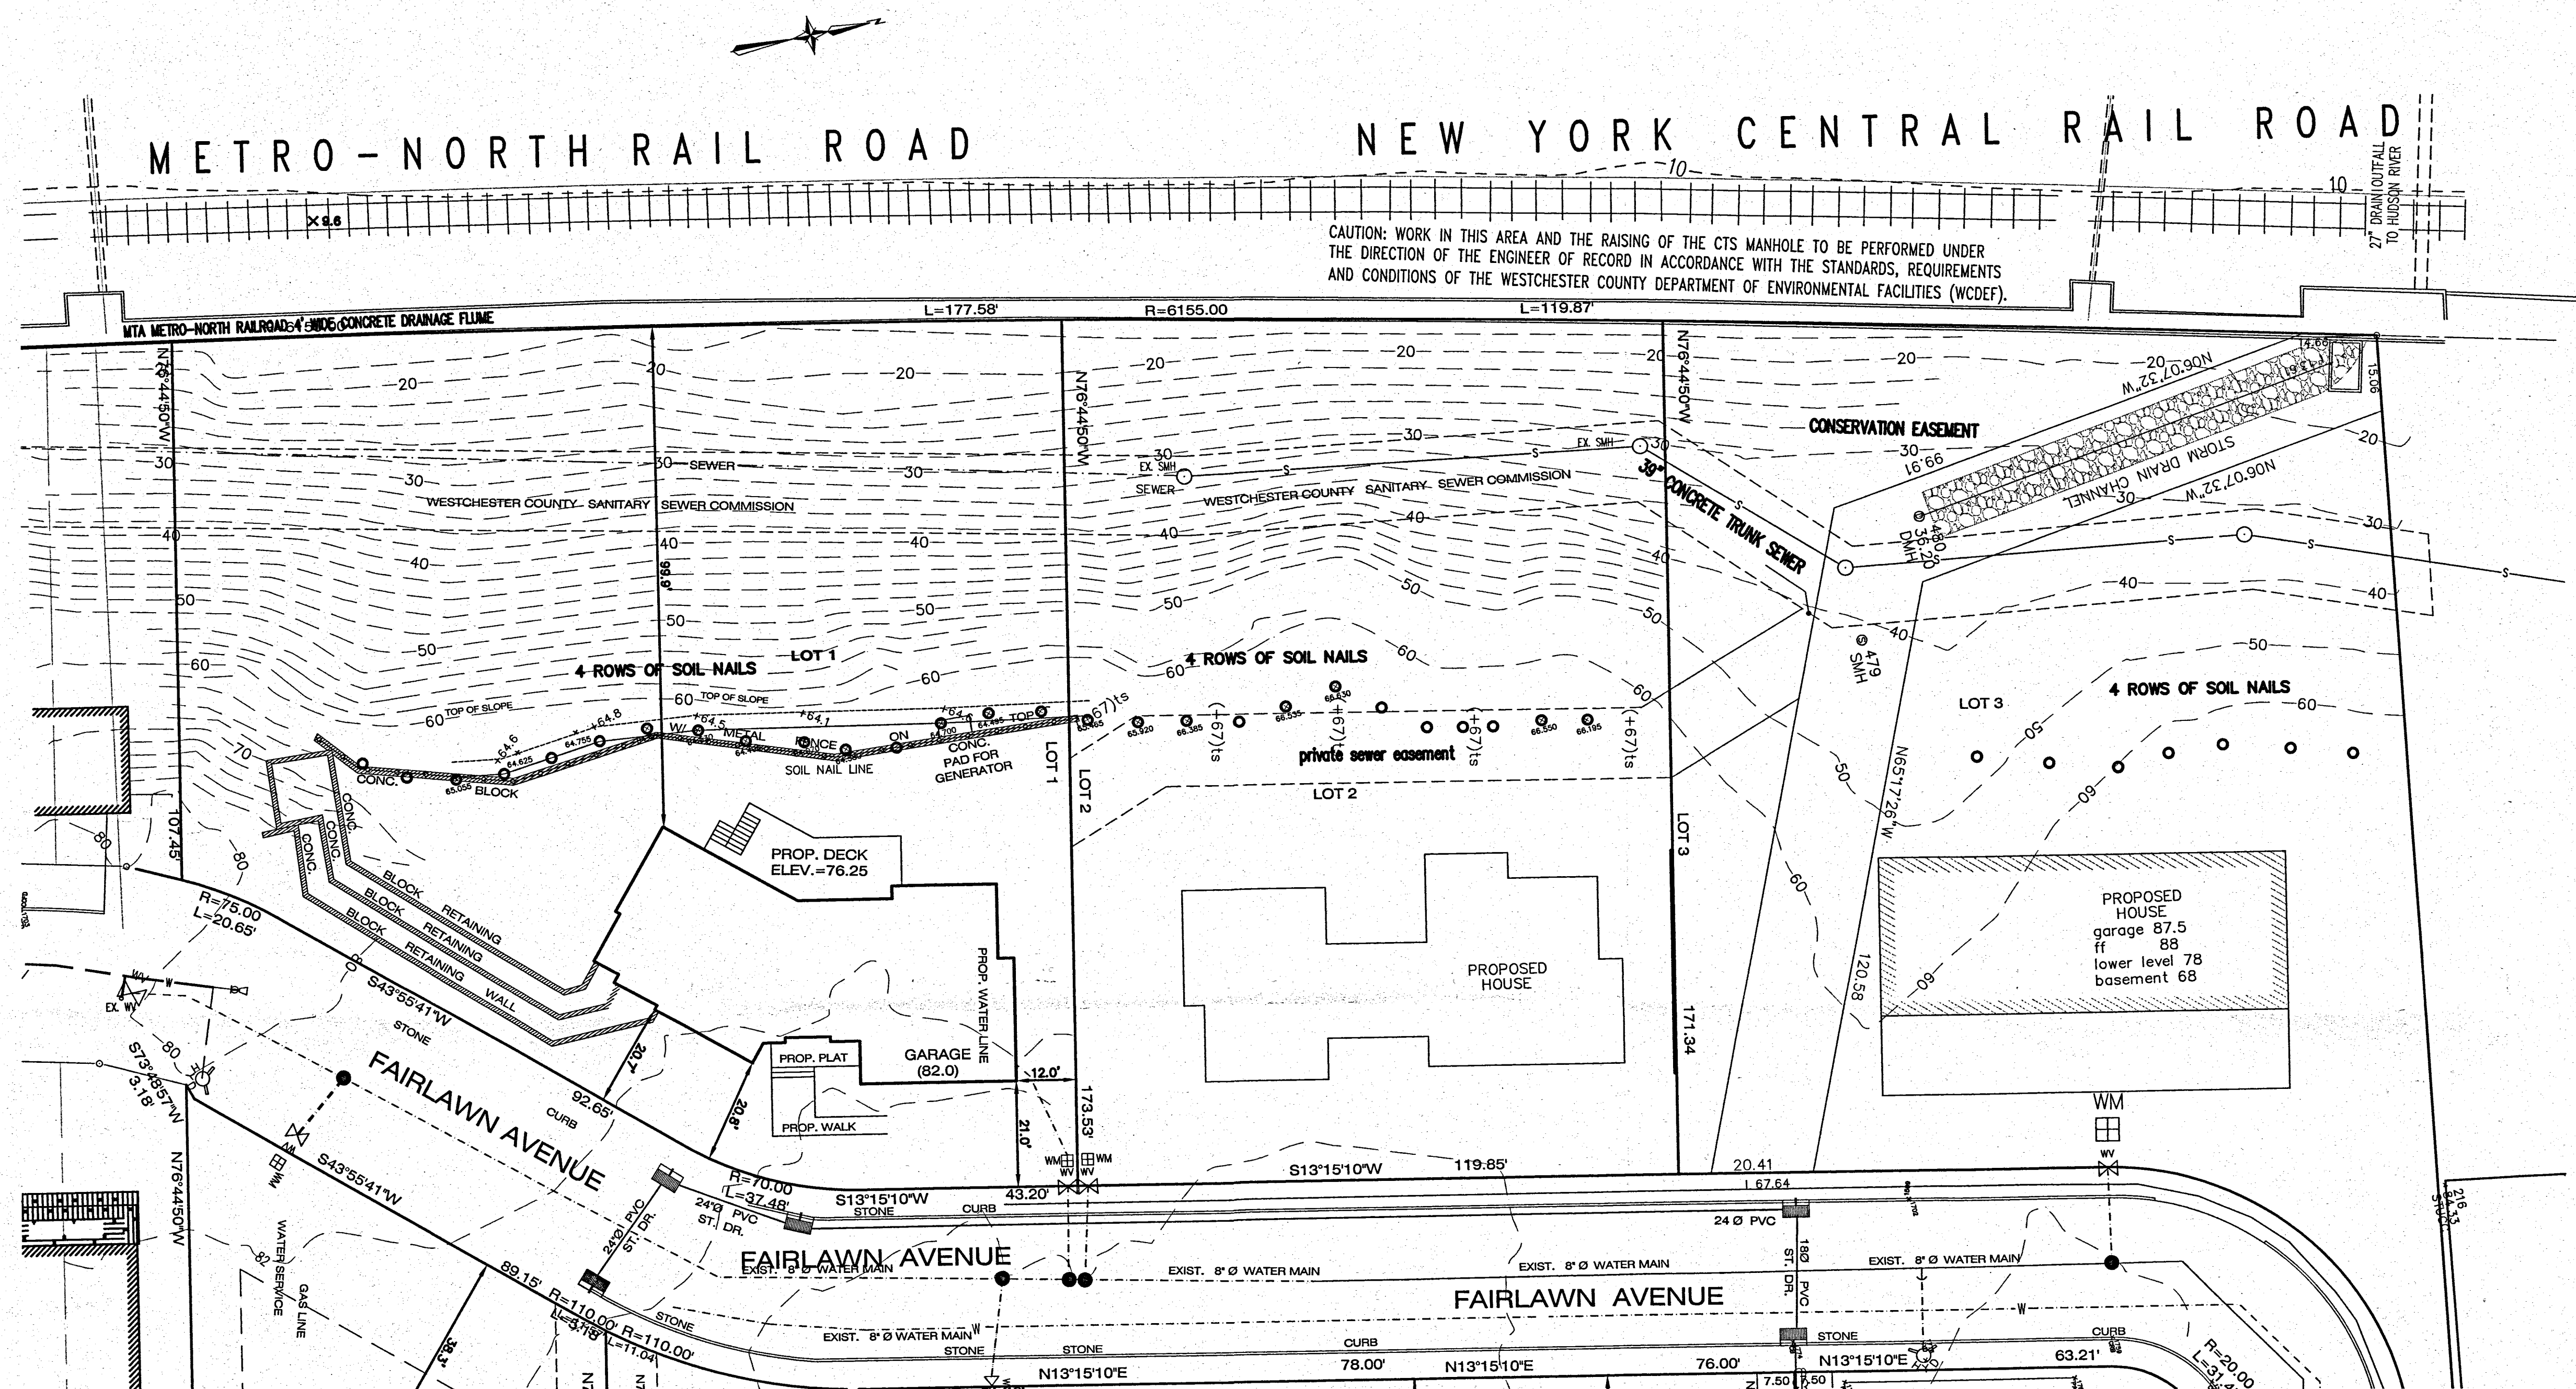

LEGEND	
SOIL NAIL	SEWER MANHOLE
CATCH BASIN	WATER MANHOLE
DRAIN INLET	ELECTRIC MANHOLE
UTILITY POLE	DRAIN MANHOLE
SIGN POST	MANHOLE
HYDRANT	ELECTRIC BOX
WATER VALVE	EXISTING GRADE
GAS VALVE	PROPOSED GRADE
LIGHT POLE	14" TREE
GUY WIRES	SIZE
TELE. MANHOLE	SIZE
SF—SF—SF—SILT FENCE	TREE TO BE REMOVED

NO	DATE	DESC	BY
1	08/02/2015	ISSUED FOR PERMIT	JES
2	08/02/2015	REVISION	JES
3	08/02/2015	REVISION	JES
4	08/02/2015	REVISION	JES
5	08/02/2015	REVISION	JES
6	08/02/2015	REVISION	JES
7	08/02/2015	REVISION	JES
8	08/02/2015	REVISION	JES
9	08/02/2015	REVISION	JES
10	08/02/2015	REVISION	JES

RECEIVED
SEP 23 2015
JAMES J. HAHN
ENGINEERING P.C.

SOIL NAIL LINE AS-BUILT

WATERS EDGE AT DOBBS FERRY
LOCATED IN THE
TOWN OF GREENBURGH
WESTCHESTER COUNTY, NEW YORK

COPYRIGHT GABRIEL E. SENOR, P.C. 2013

GABRIEL E. SENOR, P.C.
CONSULTING ENGINEER • LAND SURVEYORS
90 NORTH CENTRAL AVE., HARTSDALE, NEW YORK, 10530
(914) 422-0070 FAX 422-3009

SCALE: 1" = 20'

DATE: AUG 2, 2015

DRAWN BY: MCN. CHECKED BY: ES.

DWG NO.

