

Zoning Data

Village Of Dobbs Ferry

Zone: OF-2

Use: Single Family Residence

	Required By Code	Existing	Provided
Lot Area	20,000 sf	68,854.21 sf	68,854.21 sf

Set Backs

Front	30'	140.3'	135.44'
Side	20'	38.4'	33'
Total of Both	50'	129.3'	123.44'
Rear	25'	68.5'	50.75'

Building Hgt	2 1/2 Sty or 35'	2 Sty or 21.83'	2 Sty or 21.83'
Building Coverage	18 %	4.3 %	5.7 %
Impervious Surface	40 %	19.54 %	21.1 %


Additional Impervious Surface

Proposed	= 740 sf
Accessory Apartment	= 685 sf
Proposed Patio	= 1542 sf
Patio To Be Removed	= -853 sf
Driveway To Be Removed	= -165 sf
Greenhouse To Be Removed	= -1185 sf
Total Impervious Surface	= -1185 sf

Impervious Surface Credit Of 1/85 For Future Pool Cabana And Patio / Walkway At Pool


No Additional Storm Water Mangement Required

See Site Plan Dated 2-3-23 For Addition Site Work

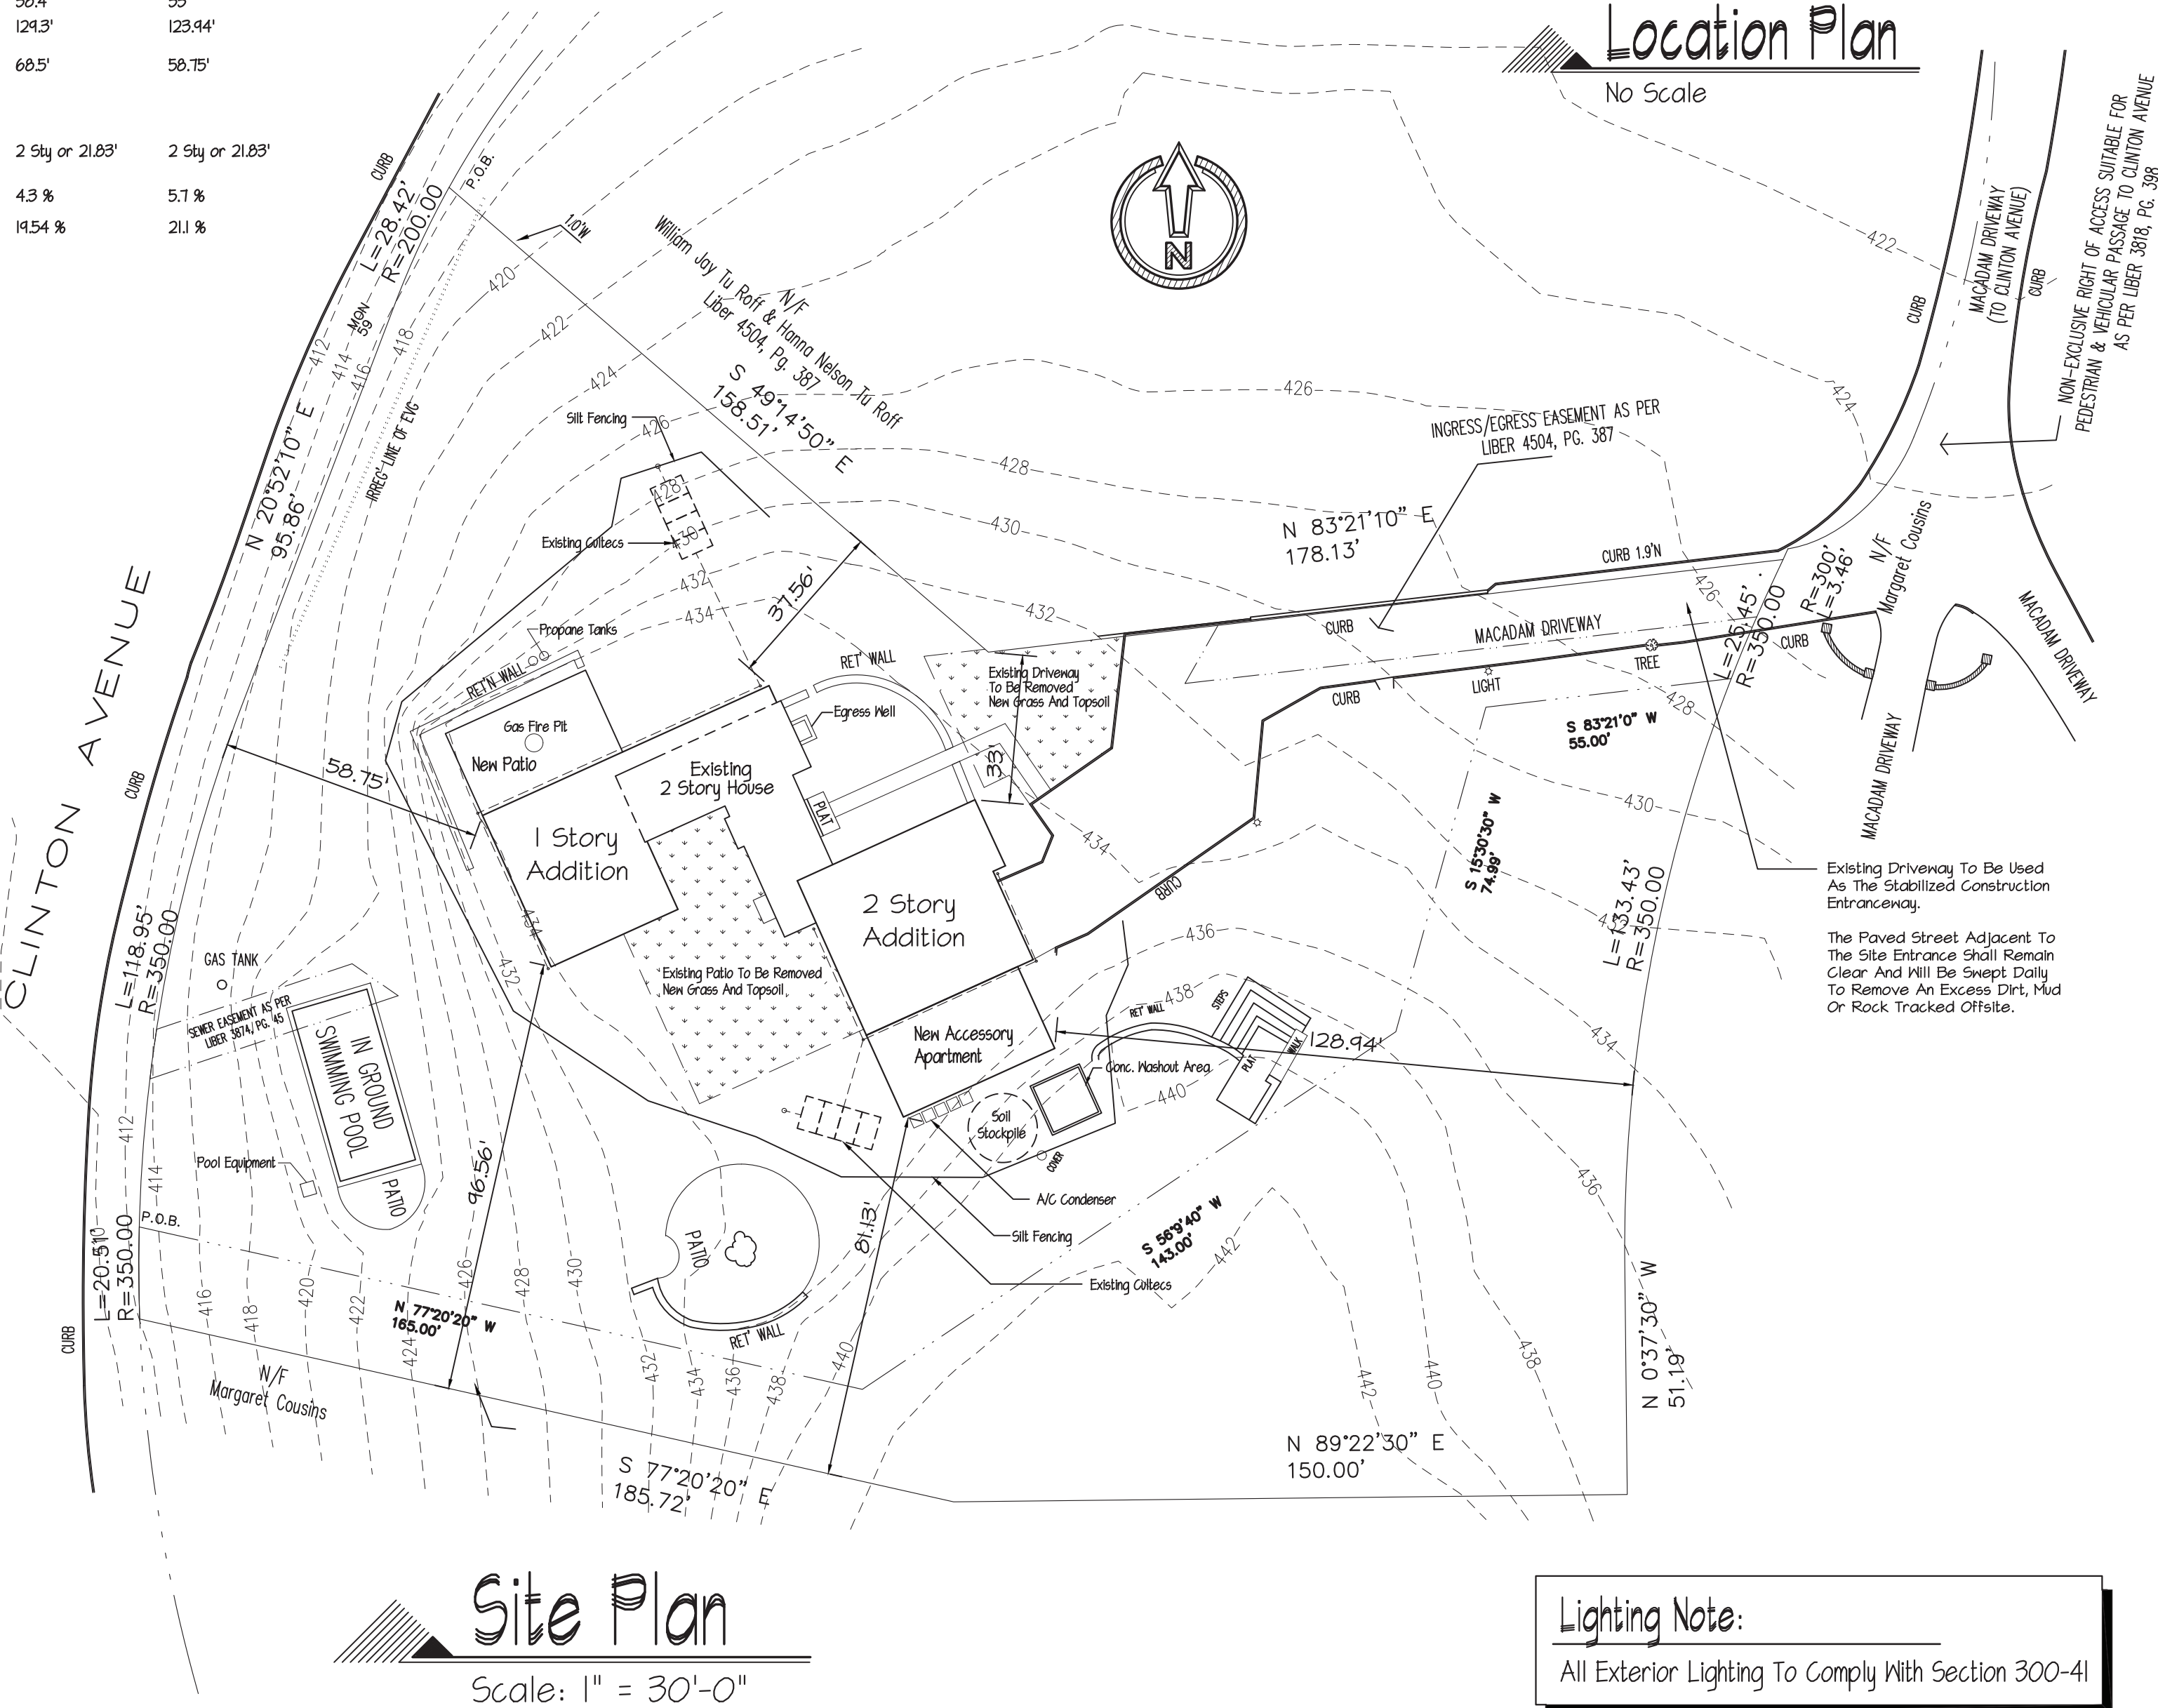

Lighting Note:

All Exterior Lighting To Comply With Section 300-41

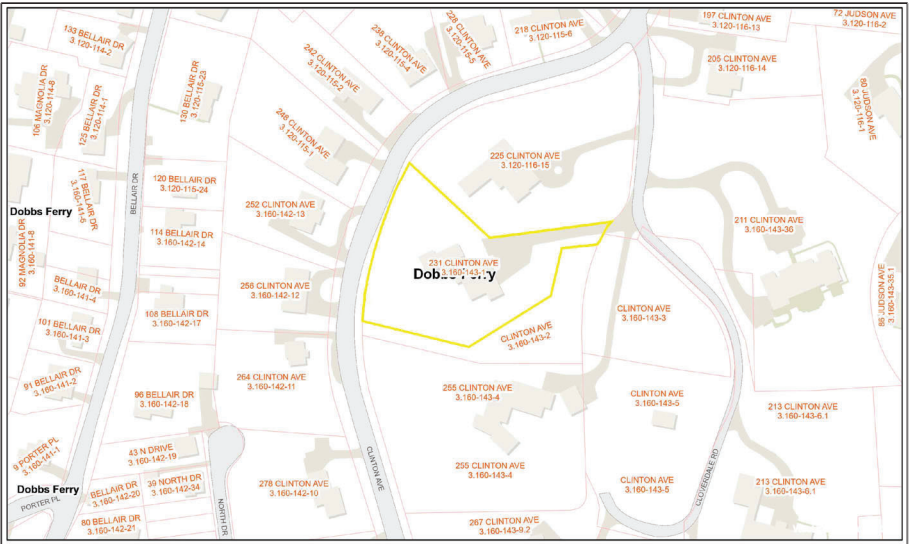

DeMasi Architects P.C.

105 SMITH AVENUE, MOUNT KISCO, NEW YORK 10549

EMAIL: Lou@DemasiArchitects.com

PHONE: (914) 666-3858






Accessory Apartment Site Plan For

231 Clinton Avenue  
Dobbs Ferry, NY




Revision	Date
Date	Oct 10, 2023
Job No	223-149
Drawing	

SP | OF 2



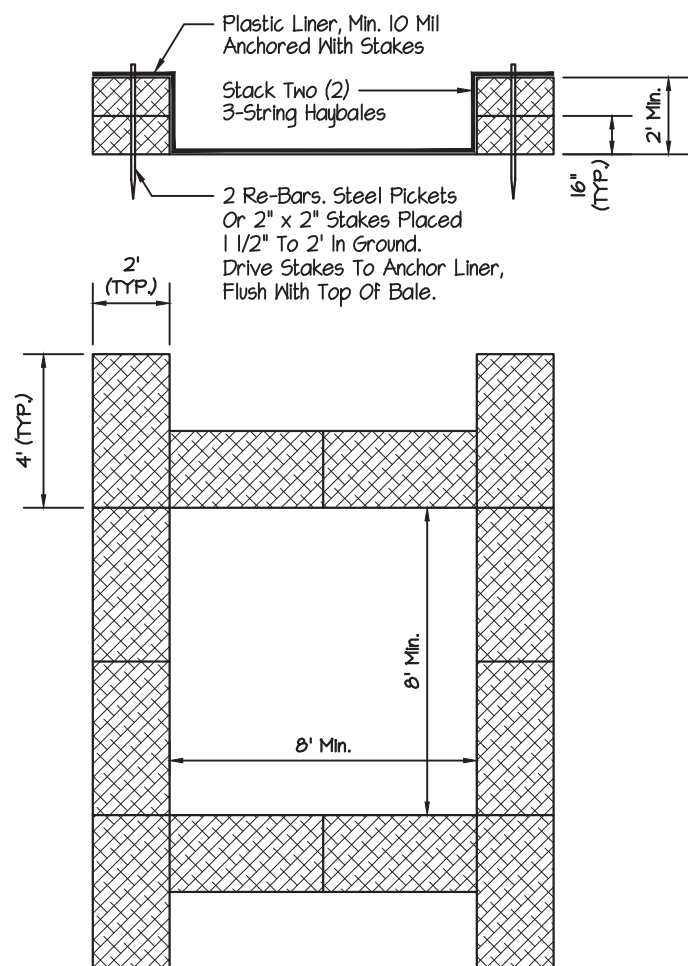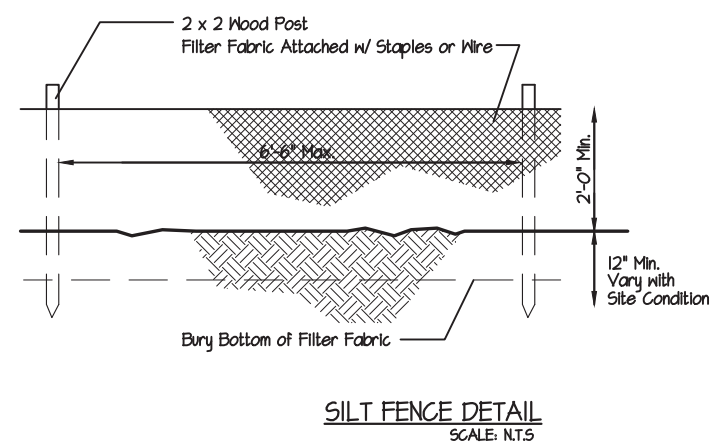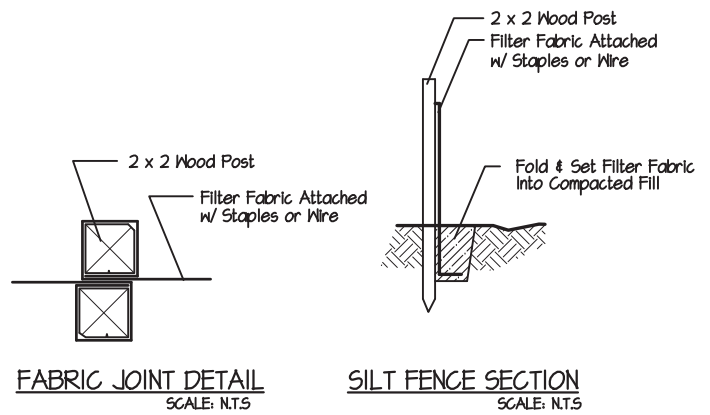

Notes:  
1. Minimum Size Shall Be 8 Feet By 8 Feet At Bottom, 2 Feet Deep.

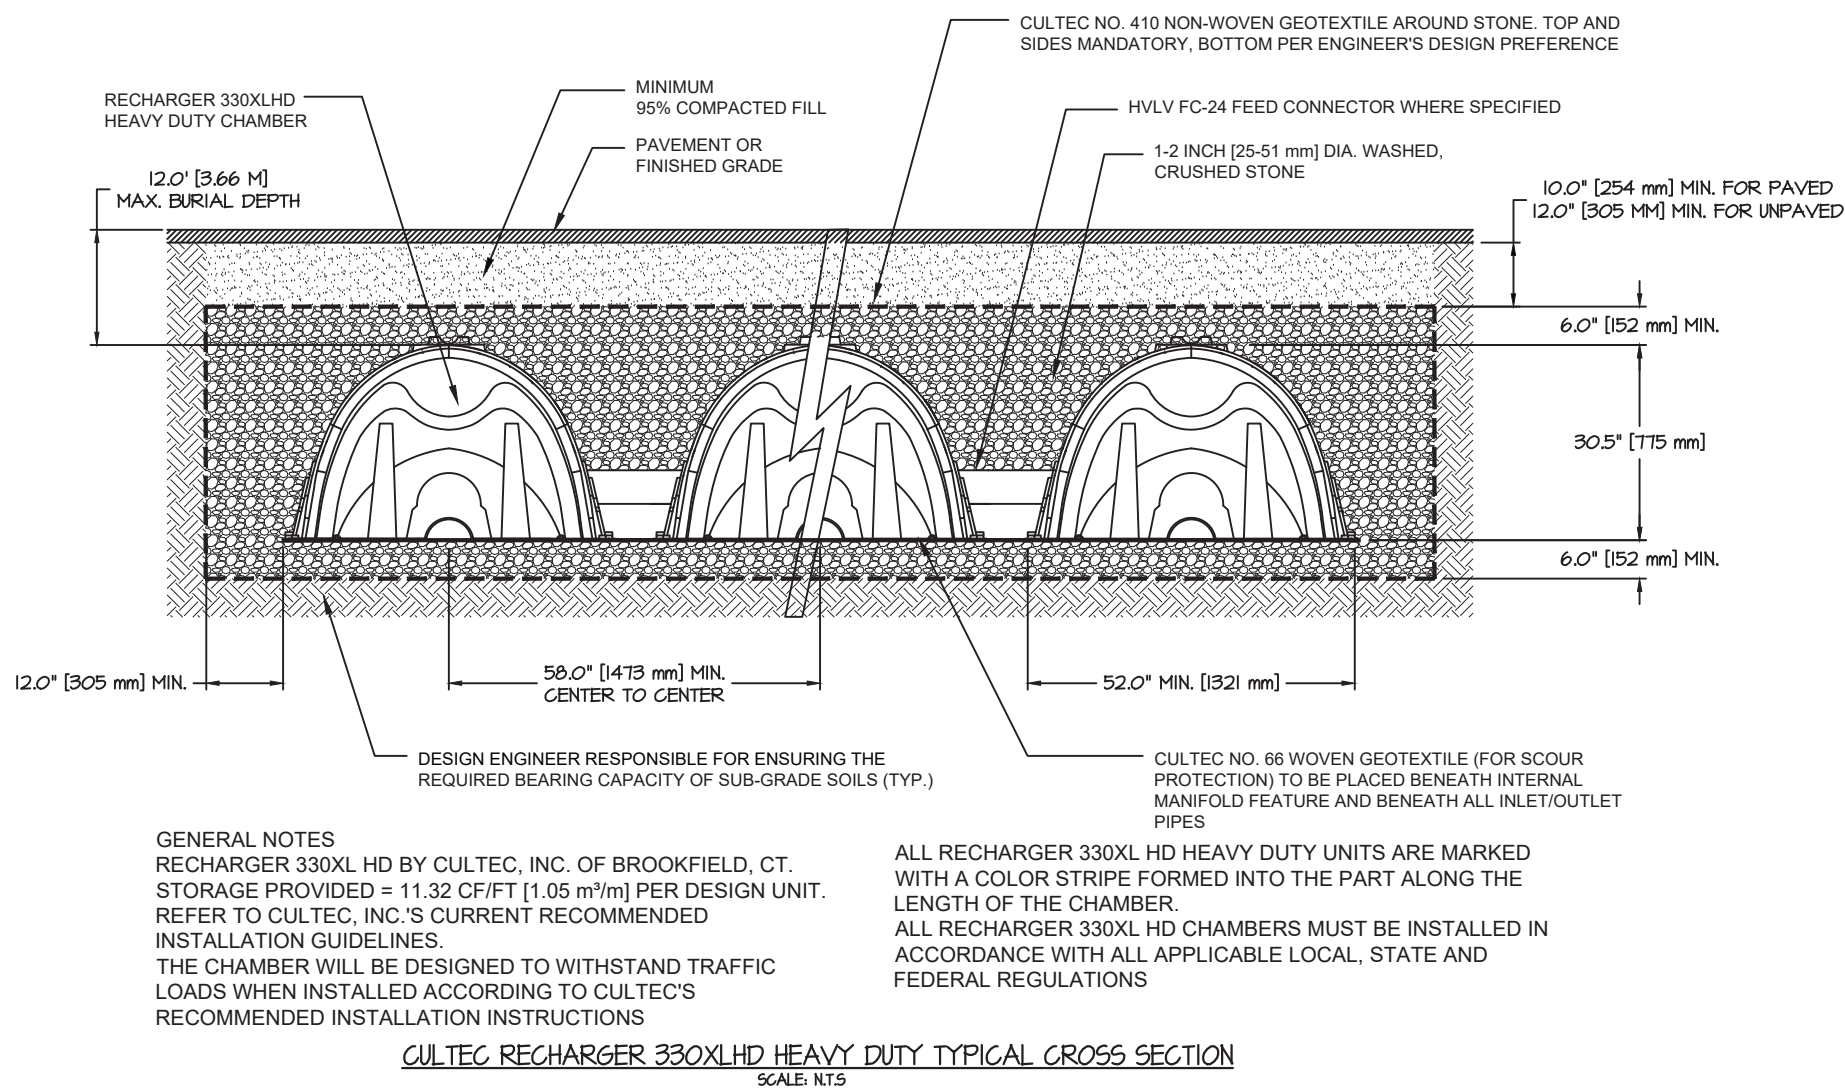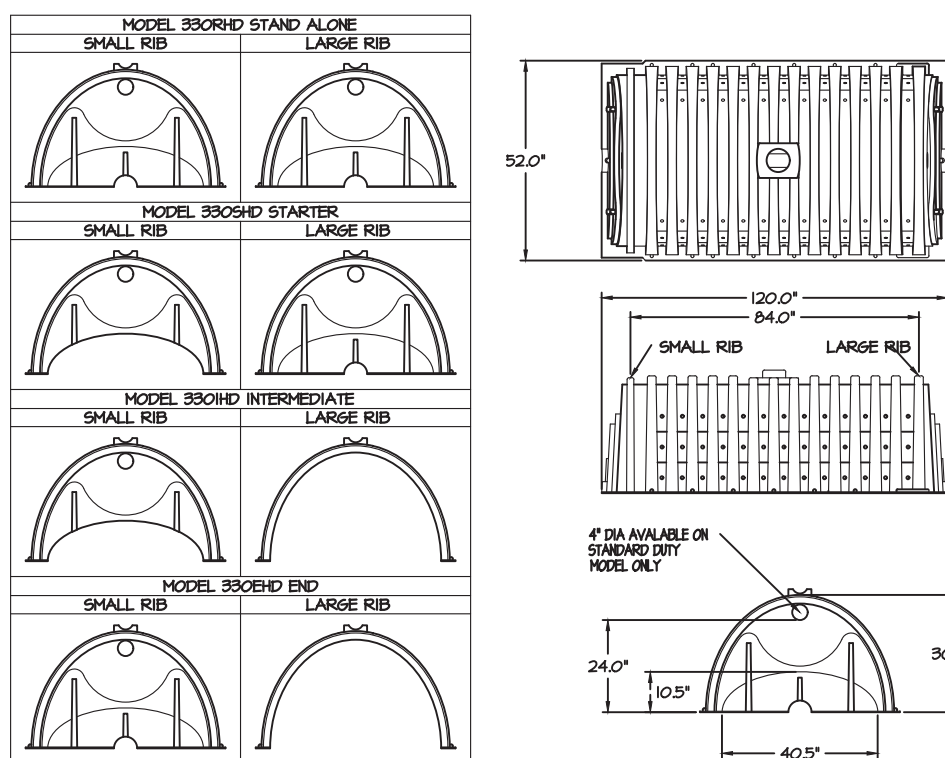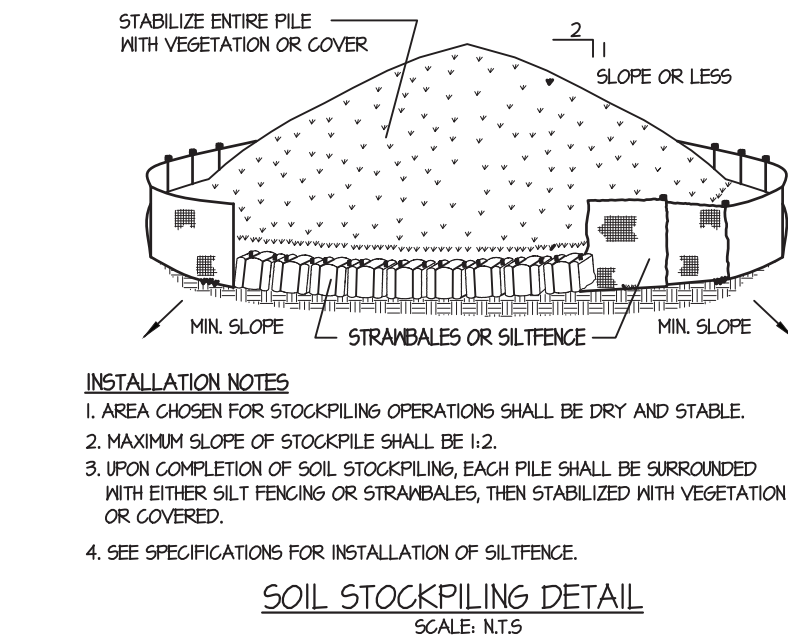

## Erosion Control Notes:

1. All Sediment & Erosion Control Measures Shall be Done In Accordance With any and all Federal, State & Local Regulations. A Pre-Construction Meeting Shall take Place Before Construction Commences with the Environmental Code Enforcement Officer Prior to Any Construction. The Perimeter of Any Areas to be Graded or Disturbed in Any Manner Shall be Marked With Orange Construction Fencing.
2. Sediment Barriers (Silt Fence, Hay Barriers, Etc.) Should be Installed Prior to Any Soil Disturbance of the Contributing Drainage Area Above Them. Mulch Netting Shall be Used to Anchor Mulch in all Areas With Slopes Greater Than 15%. After October 1 st the Same Applies for all Slopes Greater Than 8%. Install Silt Fence at Toe of Slope to Filter Silt From Runoff. See Silt Fence Detail.
3. All Erosion Control Structures will be Inspected, Replaced and/or Repaired Every 7 Days and Immediately Following any Significant Rainfall or Snow Melt or When no Longer Serviceable Due to Sediment Accumulation or Decomposure. Sediment Deposits Should be Removed After Each Storm Event. They Must be Removed When Deposits Reach Approximately One-Half the Height of the Barrier. Sediment Control Devices Shall Remain in Place and be Maintained by the Contractor Until Areas Upslope are Stabilized by Turf. All Erosion Control Measures Shall be Inspected Prior to Any Significant Storm Event.
4. No Slopes, Either Permanent or Temporary, Shall be Steeper Than Two to One (2 to 1).
5. If Final Seeding of the Disturbed Areas is not Completed 45 Days Prior to the First Killing Frost, Use Temporary Mulch (Dormant Seeding May be Attempted as Well) to Protect the Site and Delay Seeding Until the Next Recommended Seeding Period.
6. Temporary Seeding of Disturbed Areas That Have Not Been Final Graded Shall be Completed 45 Days Prior to the First Killing Frost to Protect From Spring Runoff.
7. During the Construction Phase, Intercepted Sediment will be Returned to the Site and Regraded Onto Open Areas. All Temporary Erosion Control Measures Shall be Removed Once the Site is Stabilized.
8. Wetlands Will be Protected With Hay Bales and/or Silt Fence Installed at the Edge of the Wetland or the Boundary of Wetland Disturbance. All Areas Within 100 Feet of a Flagged Wetland or Stream Shall Have an Exposure Window of Not More Than 7 Days. All Areas Within 100 Feet of a Flagged Wetland or Stream Shall Follow Appropriate Erosion Control Measures Prior to Each Storm, if Not Being Actively Worked.

**DeMasi Architects P.C.**

105 SMITH AVENUE, MOUNT KISCO, NEW YORK 10549

EMAIL: Lou@DemasiArchitects.com

PHONE: (914) 666-3858



Accessory Apartment Site Plan For

231 Clinton Avenue  
Dobbs Ferry, NY

Revision Date

Date Oct 10, 2023

Job No 223-149

Drawing

SP 2 OF 2



2020 Residential Code Of New York State

Climatic & Geographic Design Criteria Table R301.2(1)										
Ground Snow Load	Wind Design Speed (mph)	Topographic Effects	Special Wind Region	Wind-Borne Debris Zone	Seismic Design Category	Subject To Damage From Weathering	Freeze Protection	Winter Design Temp.	Ice Shield Material Required	Flood Hazards
30 lbf/sf	115 - 120 mph	No	Yes	Zone I	B	Severe	42"	Moderate Heavy	7°F F	Yes
										No
										1500 or Less
										52.2 F

Manual J Design Criteria							
Elevation	Latitude	Winter Heating	Summer Cooling	Altitude Correction Factor	Indoor Design Temperature	Design Temperature Cooling	Heating Temperature Difference
436	41	7	81	1	68	75	61
Cooling Temperature Difference	Wind Velocity Heating	Wind Velocity Cooling	Coincident Wet Bulb	Daily Range	Winter Humidity	Summer Humidity	
12	20.4	15	15	M	30	55	

Insulation And Fenestration Requirements By Component Table R402.1.2									
Climate Zone	Fenestration U-Factor	Skylight U-Factor	Glazed Fenestration SHGC	Ceiling R-Value	Wood Frame Wall R-Value	Mass Wall R-Value	Floor R-Value	Basement Wall R-Value	Slab R-Value And Depth
4	0.21	0.50	0.4	49	21 Int. Or 20+5 Or 15+10	15/20	30	15/14	10, 4 Ft.
									Crawl Space Wall R-Value
									15/14

Construction Type Note:

As Per Title 19 NYCRR Part 1265

Provide Label As Shown Below



V = Construction Type As Per Section 602 of BCNYS

FR = Floor And Roof Framing As Per Designation For Structural Components That Are Of These/Engineered Type Construction

Size:

6" Diameter Circle

Color:

Circle To Be 1/2" Stroke - Reflective Red Pantone #187  
Inner Circle - Reflective White  
Text - Reflective Red Pantone #187

Sign Location:

The Sign Or Symbol Required Shall Be Affixed To The Electric Box Attached To The Exterior Of The Residential Structure.  
See Section 1265.5 For Further Notes On Sign Location.

See Title 19 NYCRR Part 1265 For Other Specs

Insulation Note:

Prescriptive Insulation Method To Be Used No Recheck Required  
No Recheck Required  
See Table R402.1.2 Of The NYStretch Energy Code 2020

Sprinkler Note:

Sprinkler Plan By Other

Lighting Note:

All Exterior Lighting To Comply With Section 300-41

Square Footage

First Floor	2,741 Sf
Second Floor	2,433 Sf
Total	5,174 Sf
Garage	561 Sf
Green House	166 Sf

Typical Roof Construction  
(Refer To Wall Section For All Other Information)

"Simpson" H4 Seismic & Hurricane Tie Or Equal

2 x 4 Cont. Plate (Set On Top Of Joist)

Typical Wall Construction  
(Refer To Wall Section For All Other Information)

Note:  
Plywood Must To Extend Under 2 x 4 Plate, If Plywood Is Not Installed Provide 2 x 4 Tie-Backs @ 16" o/c


Rafter / Tailout Detail @ Garage

Scale: 1" = 1'-0"

Schedule For Proposed Building Material and Color Scheme

Name:	Type:	Color:
Siding:	Hardi-plank	Bevel
Windows:	Pella	Double Hung
Trim:	Hardi-plank	Composite
Front Door:		Wood
Roofing:		Asphalt Shingle Roof
Garage Door:		Composite

All Materials Shall Be As Specified Or Similar

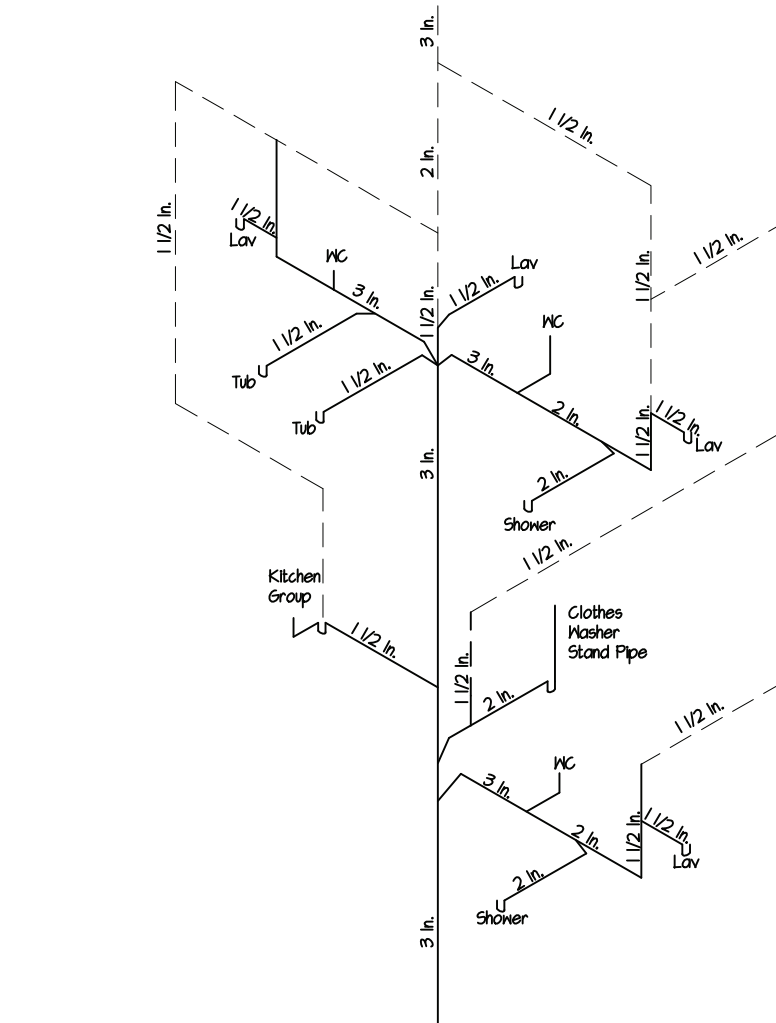


Typical Plumbing Riser Diagram

Scale: None

Riser diagram taken from "2020 Residential Code Of New York State" Figure N5, Refer to diagram for all other information

Note:  
Plumbing riser diagram shown is generic, and should be used only for informational purposes. Plumbing contractor to install plumbing system as per state & local building codes.

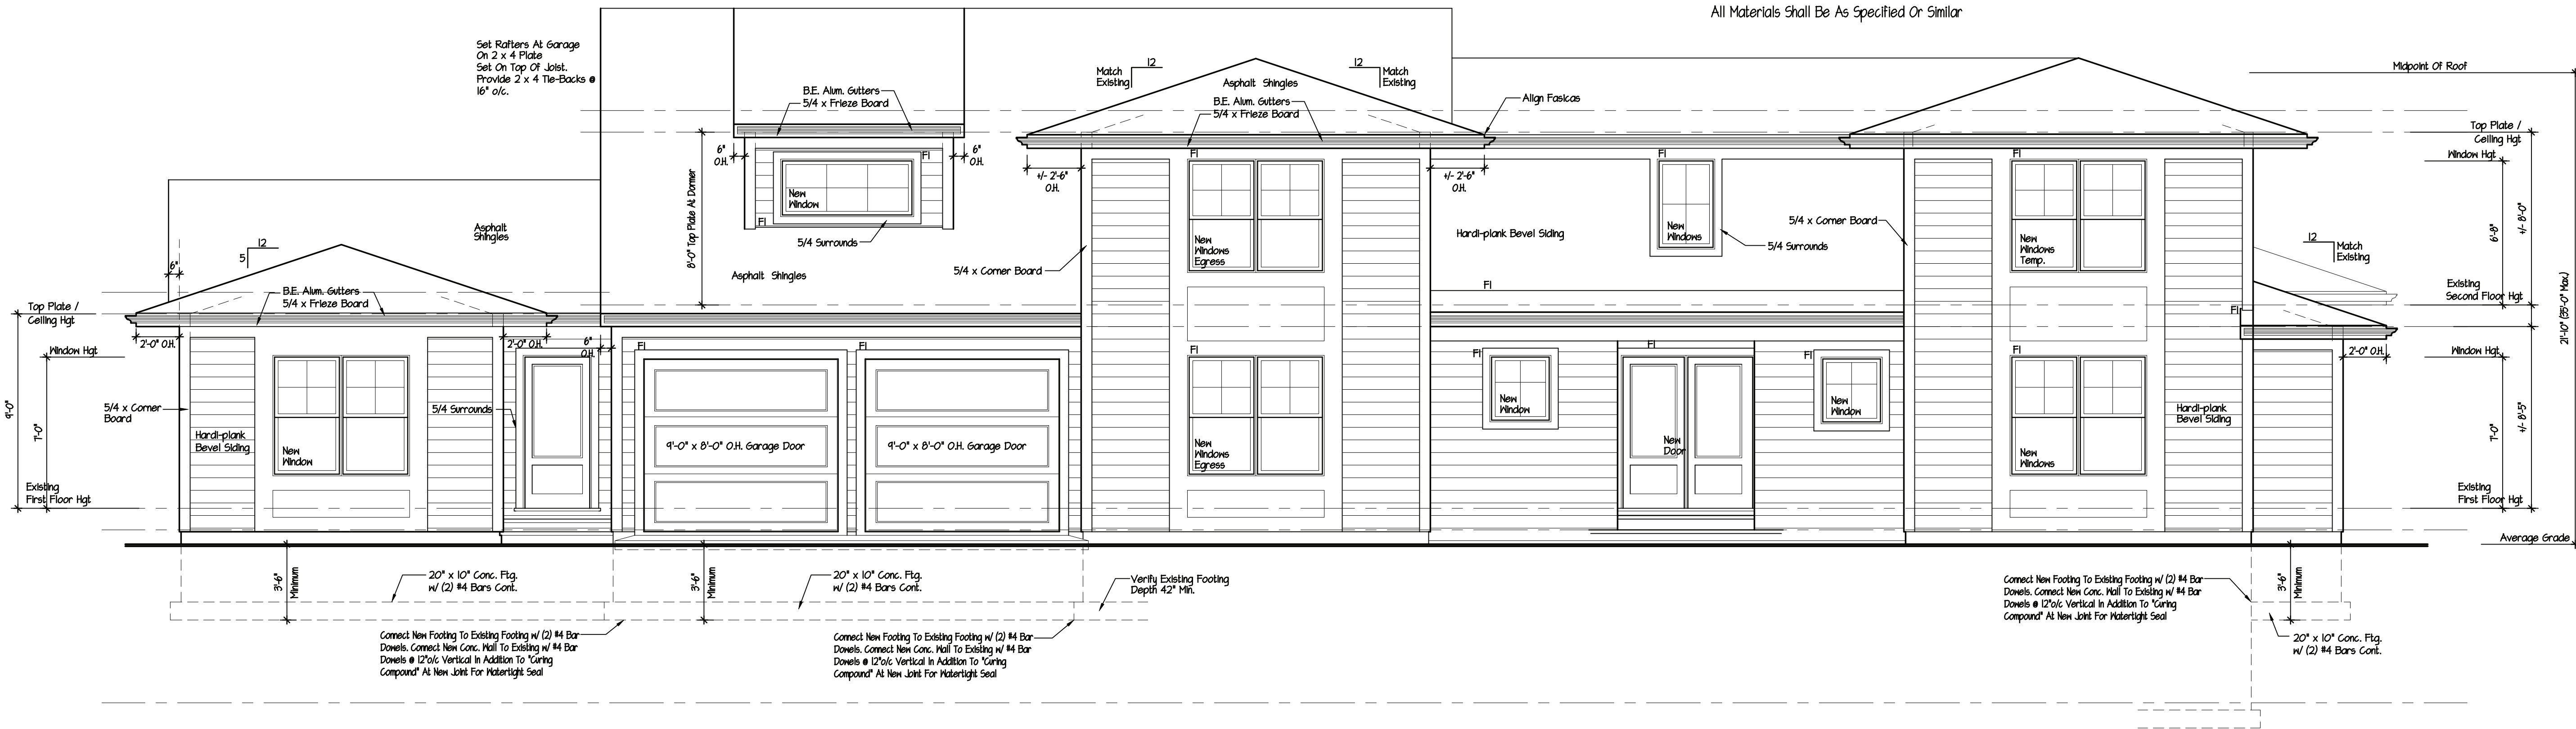

Proposed Front Elevation

Scale: 1/4" = 1'-0"

Addition For

231 Clinton Avenue  
Dobbs Ferry, NY

As Built 10/10/23

Revision Date

Date Nov. 24, 2022

Job No 222-118

Drawing

1 OF 2



These plans are the property of the Architect. Any use or reproduction in whole or part without the written authorization of the Architect is prohibited. Any person or corporation who reproduces these plans without the written authorization of the Architect, shall be liable to the Architect for the construction of one structure only by the person whose name appears on the plans.


DeMasi Architects P.C.

105 SMITH AVENUE, MOUNT KISCO, NEW YORK 10549

PHONE: (914) 666-3850 EMAIL: Lou@DemasiArchitects.com

Do Not Scale Prints



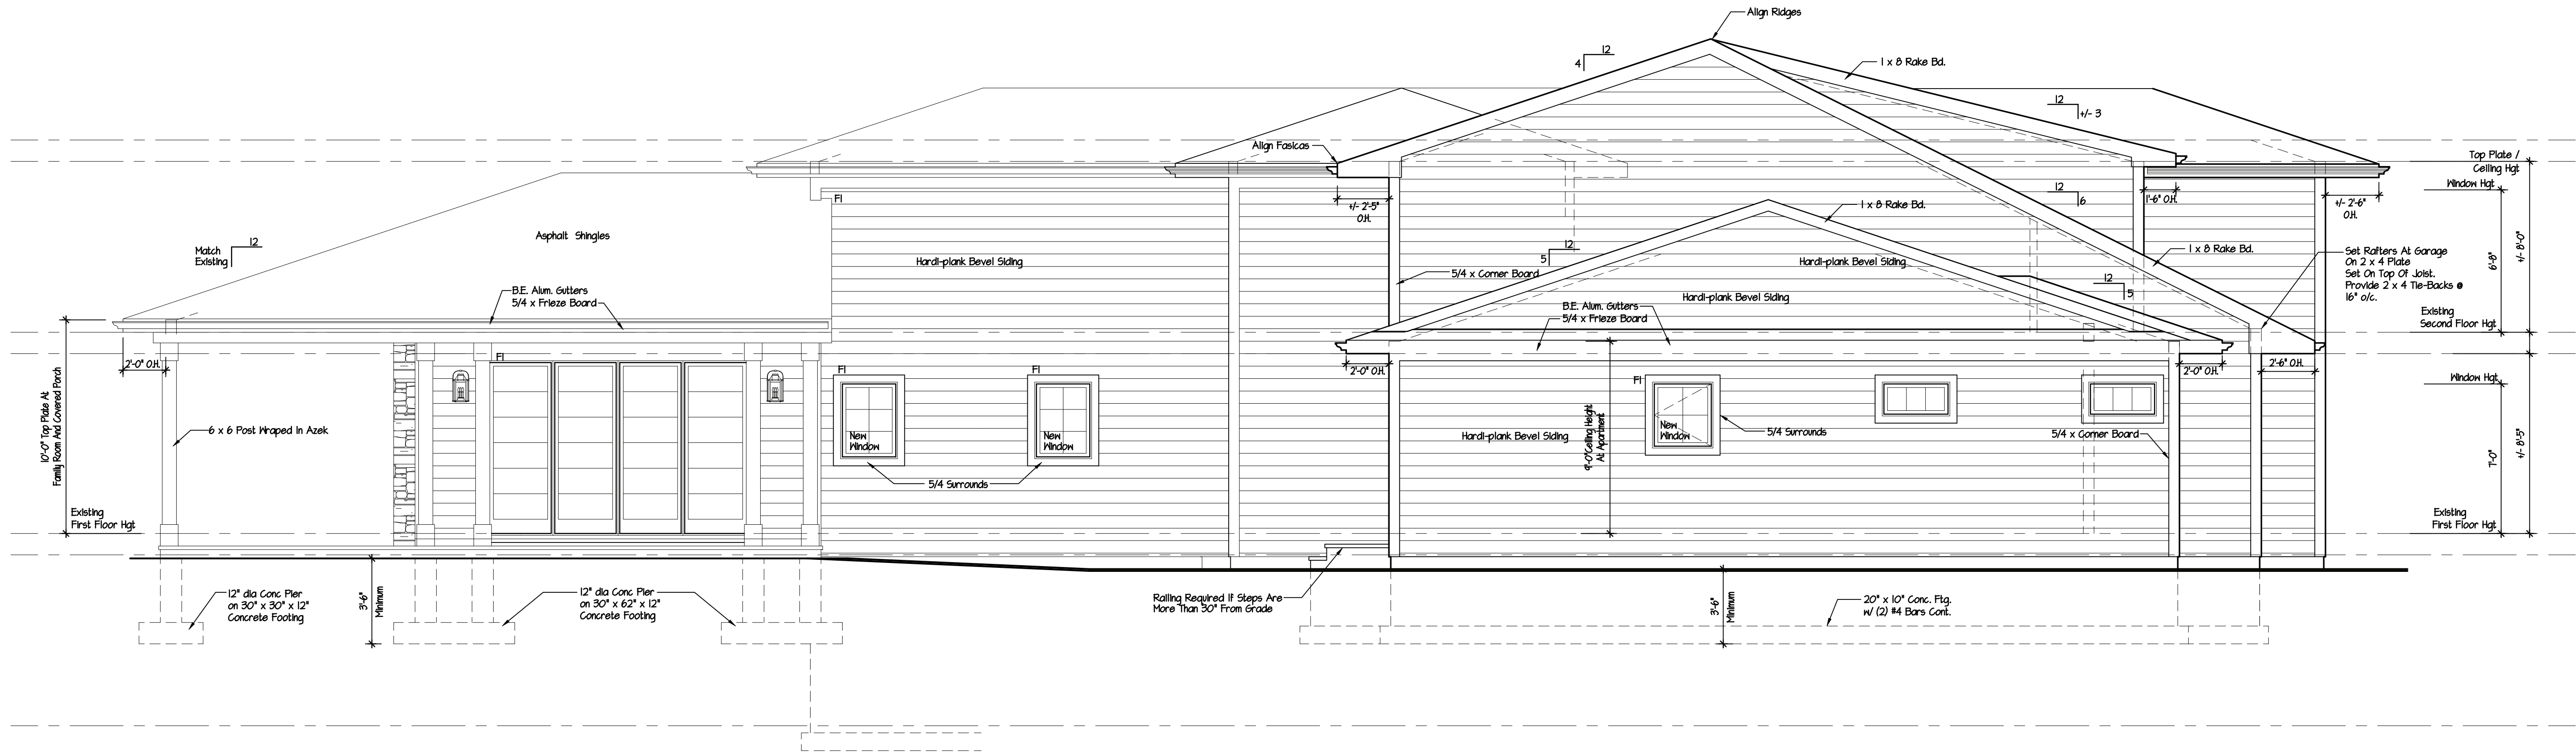


Proposed  
**Left Side Elevation**  
Scale: 1/4" = 1'-0"

**Schedule For Proposed Building Material and Color Scheme**


	Name:	Type:	Color:
Siding:	Hardi-plank	Bevel	Snowbound
Windows:	Pella	Double Hung	Jogging Path
Trim:	Hardi-plank	Composite	Jogging Path
Front Door:		Wood	Mahogany
Roofing:		Asphalt Shingle Roof	Black
Garage Door:		Composite	Jogging Path

All Materials Shall Be As Specified Or Similar

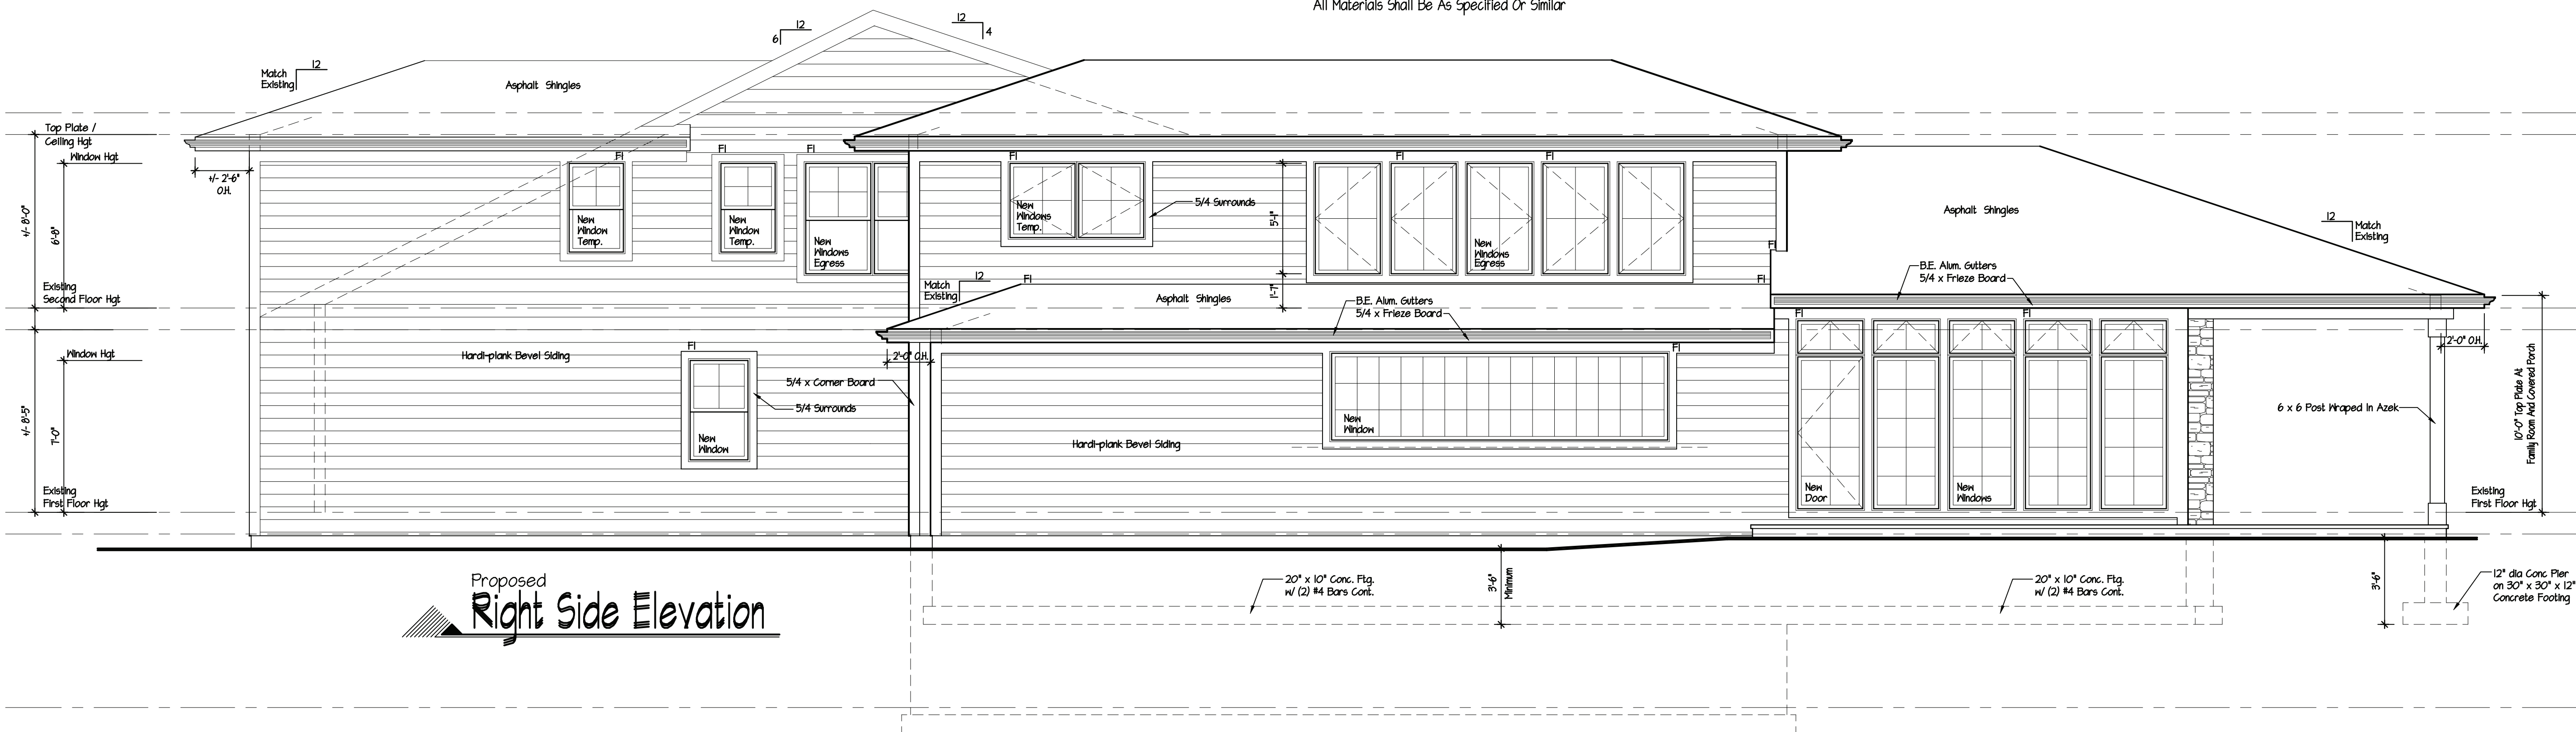


Proposed  
**Right Side Elevation**



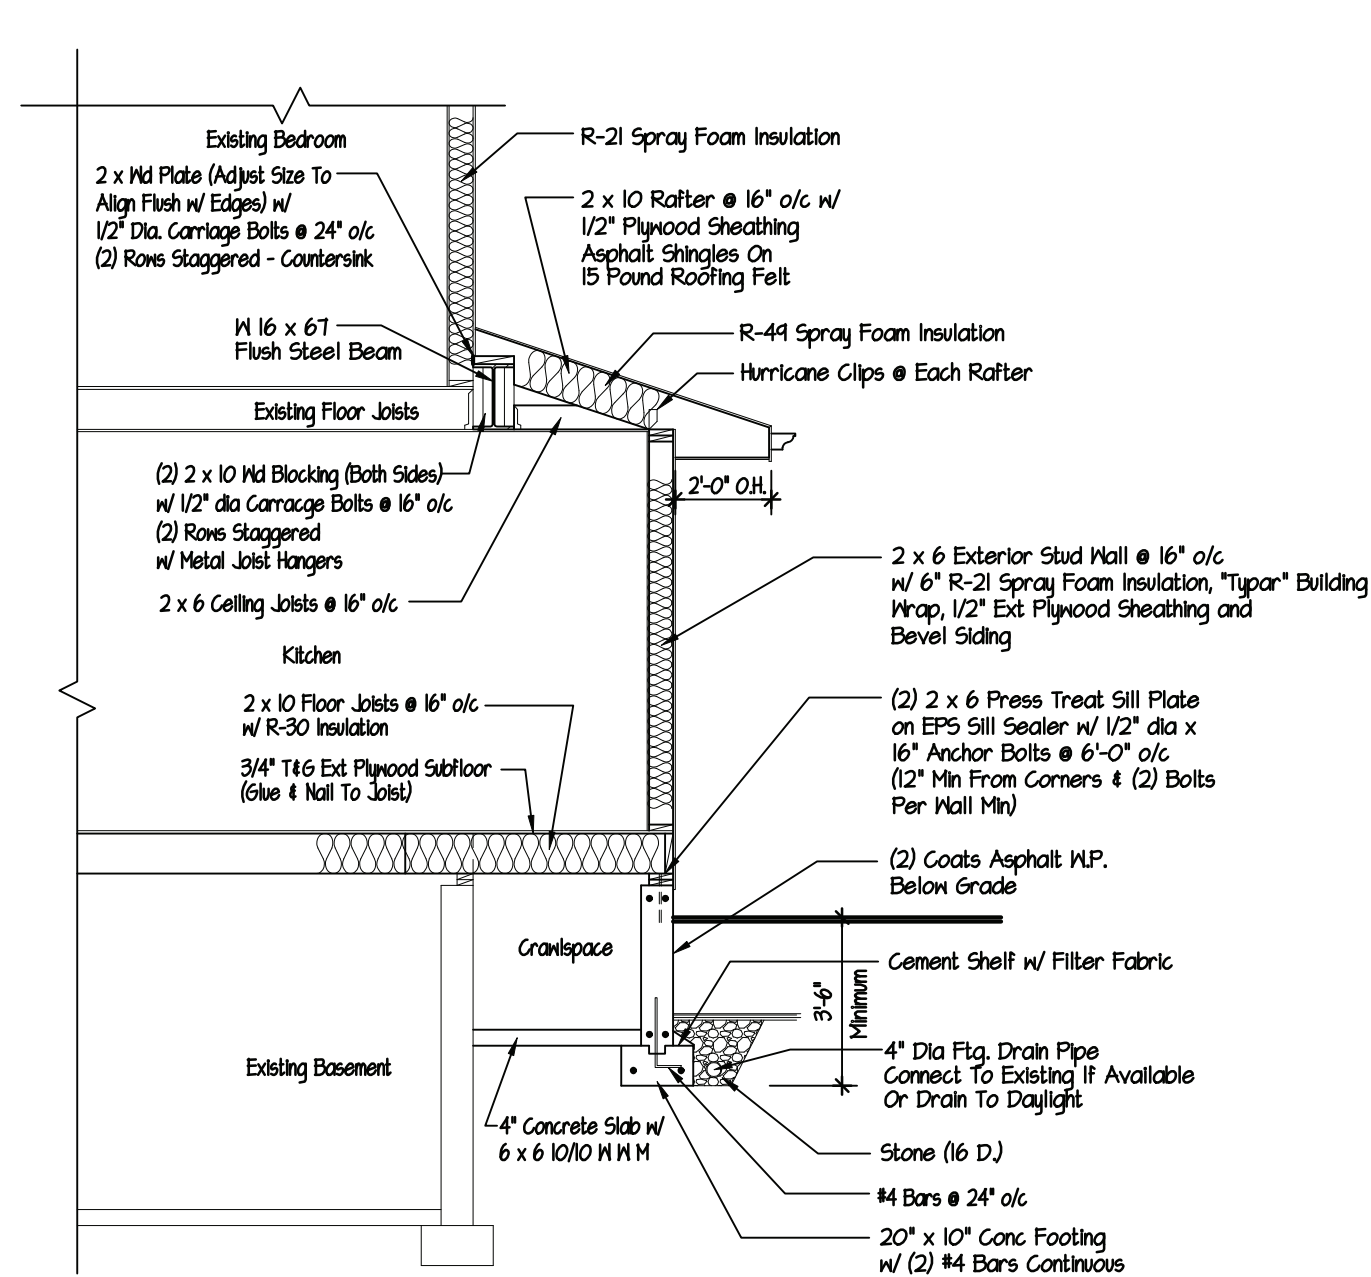

ALL FOOTINGS TO BEAR ON SOLID UNDISTURBED EARTH.

**Section B**  
Scale: 1/4" = 1'-0"

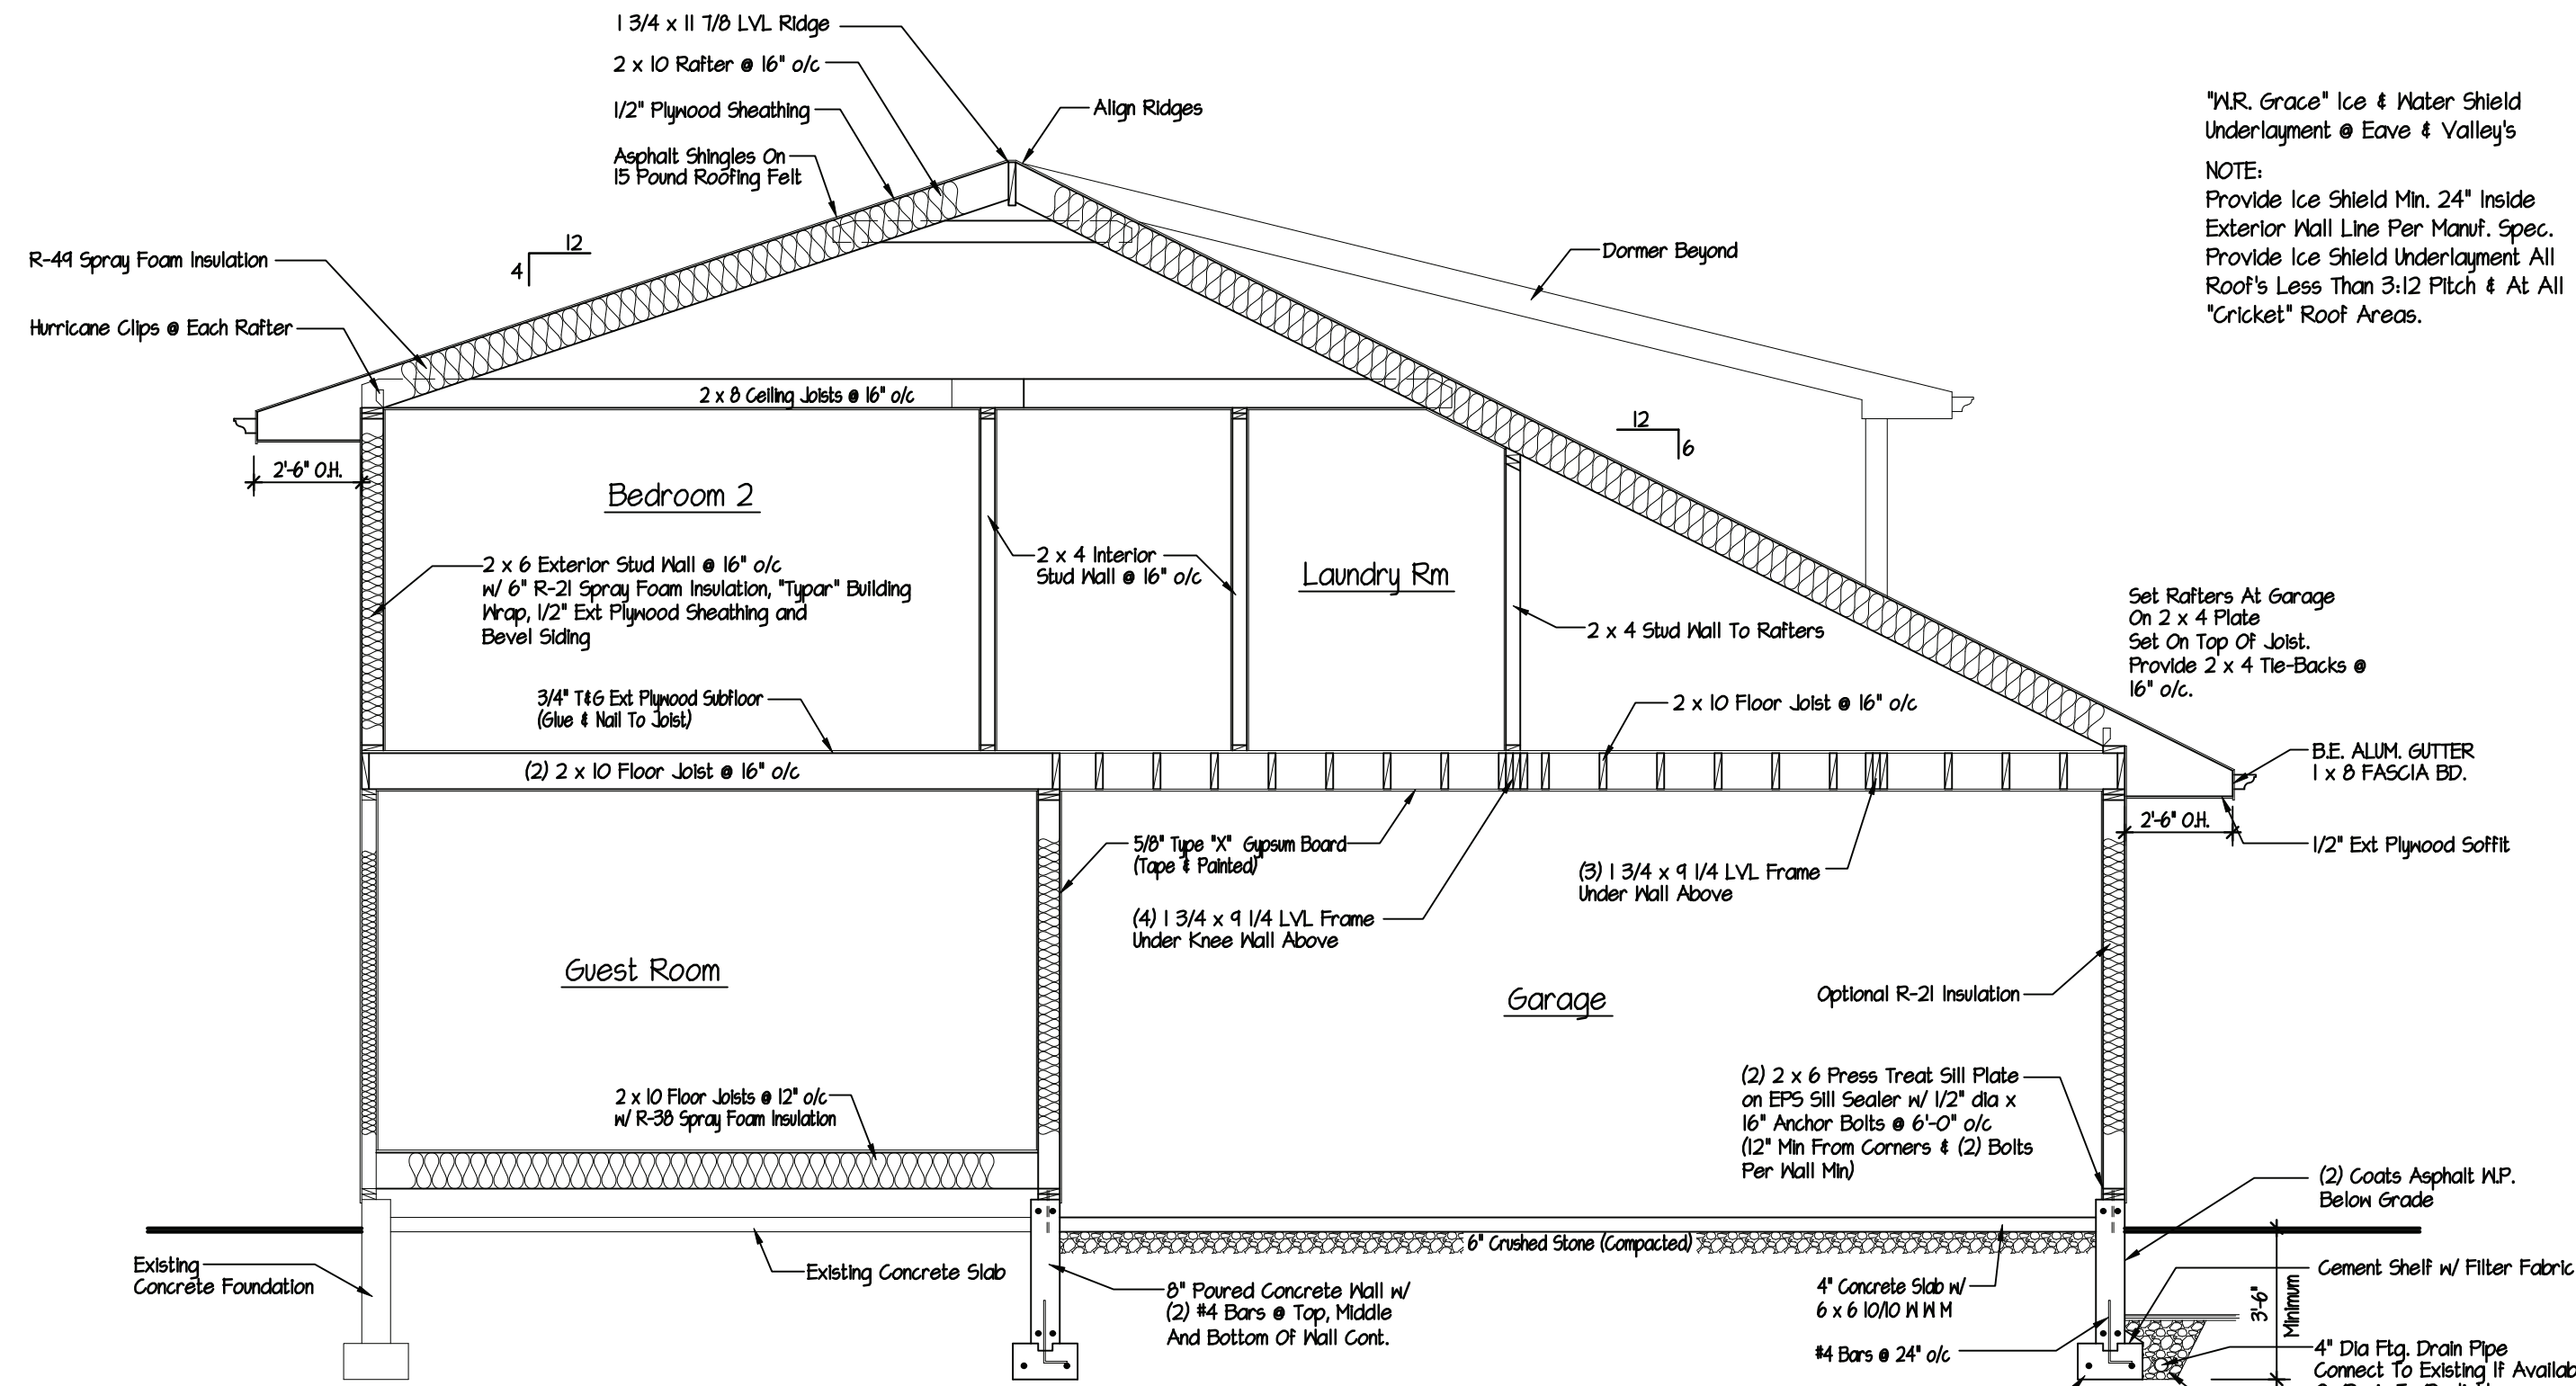


ALL FOOTINGS TO BEAR ON SOLID UNDISTURBED EARTH.

**Section A**  
Scale: 1/4" = 1'-0"


**Schedule For Proposed Building Material and Color Scheme**

	Name:	Type:	Color:
Siding:	Hardi-plank	Bevel	Snowbound
Windows:	Pella	Double Hung	Jogging Path
Trim:	Hardi-plank	Composite	Jogging Path
Front Door:		Wood	Mahogany
Roofing:		Asphalt Shingle Roof	Black
Garage Door		Composite	Jogging Path

All Materials Shall Be As Specified Or Similar

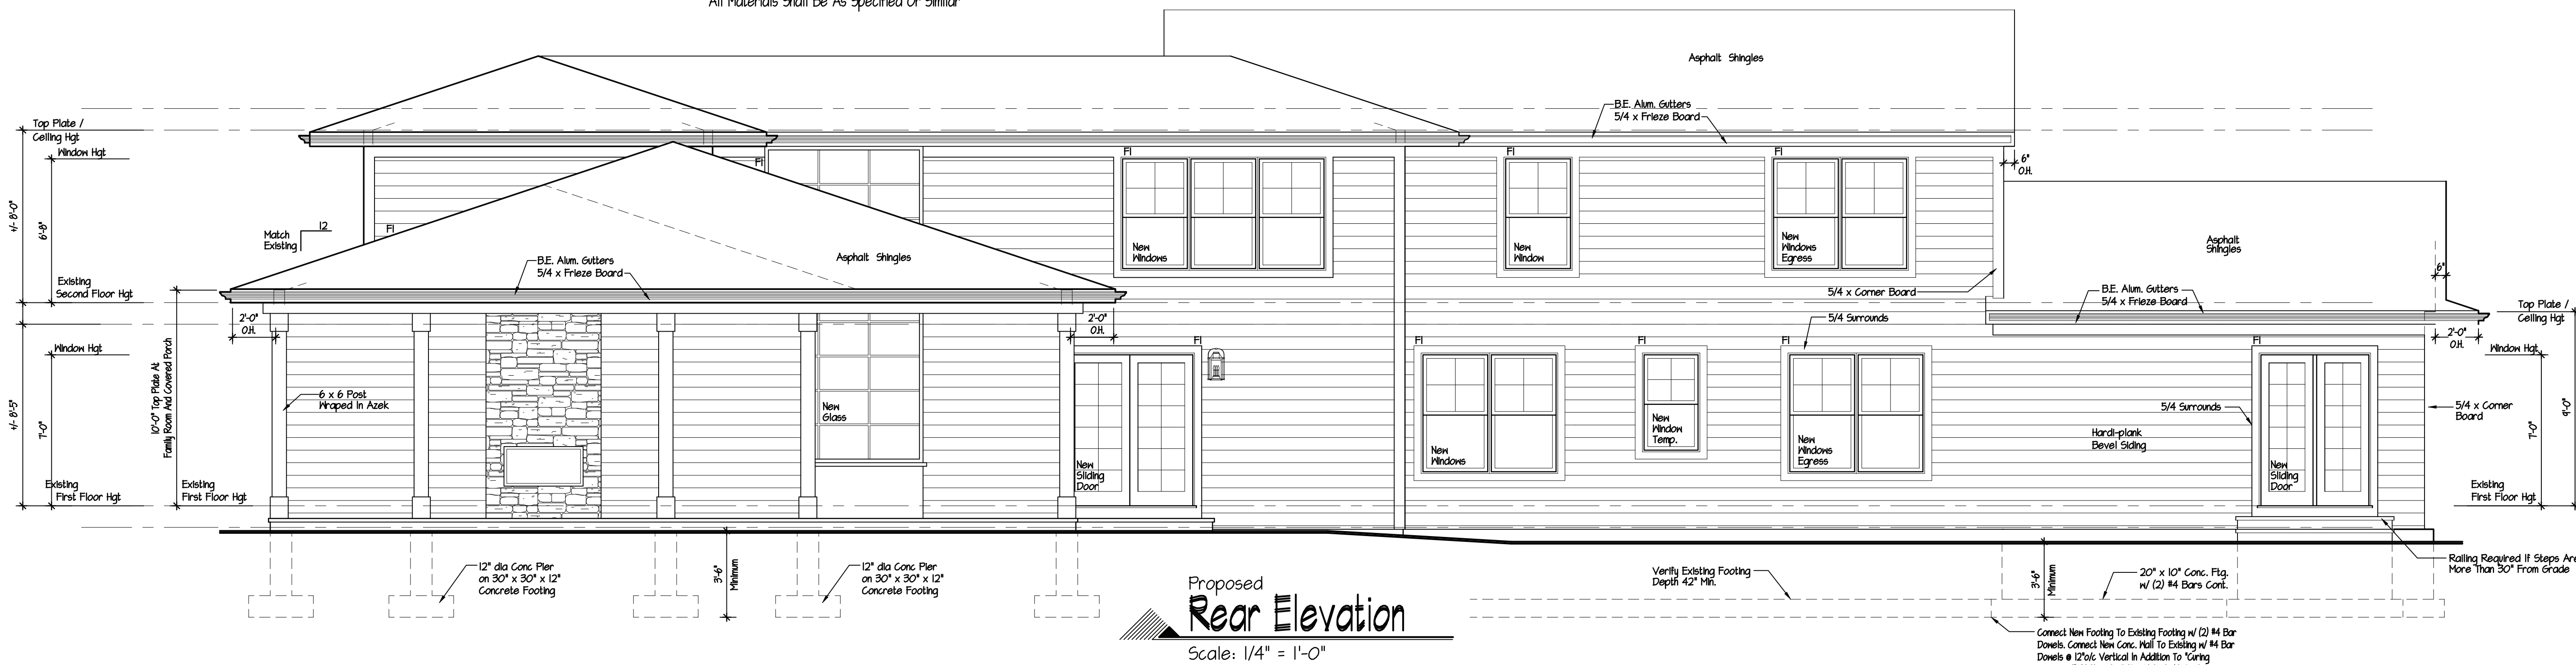

**Proposed Rear Elevation**  
Scale: 1/4" = 1'-0"

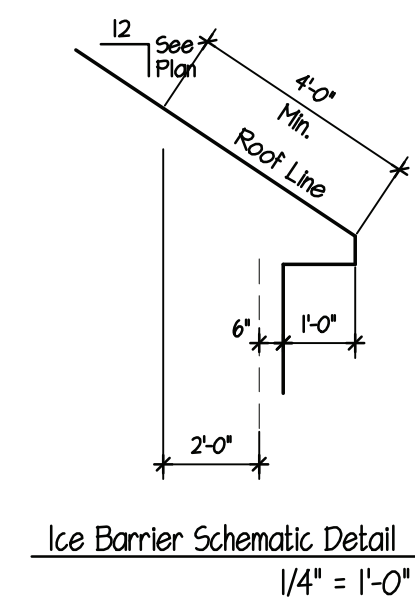

"MR. Grace" Ice & Water Shield Underlayment @ Eave & Valley's  
NOTE:  
Provide Ice Shield Min. 24" Inside Exterior Nail Line Per Manuf. Spec. Provide Ice Shield Underlayment All Roofs Less Than 3:12 Pitch & At All "Cricket" Roof Areas.

**DeMasi Architects P.C.**  
105 SMITH AVENUE, MOUNT KISCO, NEW YORK 10549  
PHONE: (914) 666-3850  
EMAIL: [Love@DemasiArchitects.com](mailto:Love@DemasiArchitects.com)



These plans are the property of the Architect. Any use or reproduction in whole or part without the written authorization of the Architect is prohibited. Any person or corporation who reproduces these plans without the written authorization of the Architect will be responsible to compensate the Architect.  
These plans are not valid for a building permit unless the signature of the Architect is present. The Architect is not responsible for the construction of any structure other than that shown on the plans.

**Addition For**  
**231 Clinton Avenue**  
**Dobbs Ferry, NY**

As Built	10/10/23
Revision	Date
Date	Nov. 24, 2022
Job No	222-118
Drawing	



Floor Joists w/ 3/4" T&E Plywood  
Sillings & Cross Bracing @ 16" o/c  
Span Ratio 1:2 For Sills & Spacing

LVL Beam (See Plan For Size)  
(4) 12" dia Log Bolts (2) Per  
Side of Plate  
5 1/4" x 8" x 12" Steel Bearing  
Plate (Adjust Size To Match Girder  
Width)  
4" od Steel Pipe Column

4" od Steel Pipe Column  
8" x 8" x 3/8" Steel Bearing Plate  
w/ (2) 1/2" dia Expansion Bolts  
4" Concrete Sill on 6" MI  
Poly Vapor Barrier  
6" Crushed Stone  
30" x 30" x 12" Concrete Footing w/  
(4) #4 Bars Eachway

## LVL Girder Detail

Scale: 1" = 1'-0"

### Notes:

All Footings To Bear 12" Below  
Solid Undisturbed Earth  
All Framing Members To Be # 2  
Douglas Fir-Larch On Bottom  
Double All Header All Partitions  
Parallel To Framing  
Type Windows  
If The Floor Is To Be MID Job  
Consult Architect For Additional  
Framing Required


### Legend:

2 x Wood Post/Match  
Beam Match or As Noted  
Smoke Detector  
Carbon Monoxide Det  
w/ Battery Back-Up  
Existing Wall  
(To Remain)  
New Conc. Wall

### Wood Header Schedule


Span	Header Size
Up To 3'-0"	(2) 2 x 8" Lx8'
Up To 4'-0"	(2) 2 x 8" Lx10'
Up To 6'-0"	(2) 2 x 10" Lx10'
Up To 8'-0"	(2) 2 x 10" Lx12'

Notes: Otherwise Noted On Plans

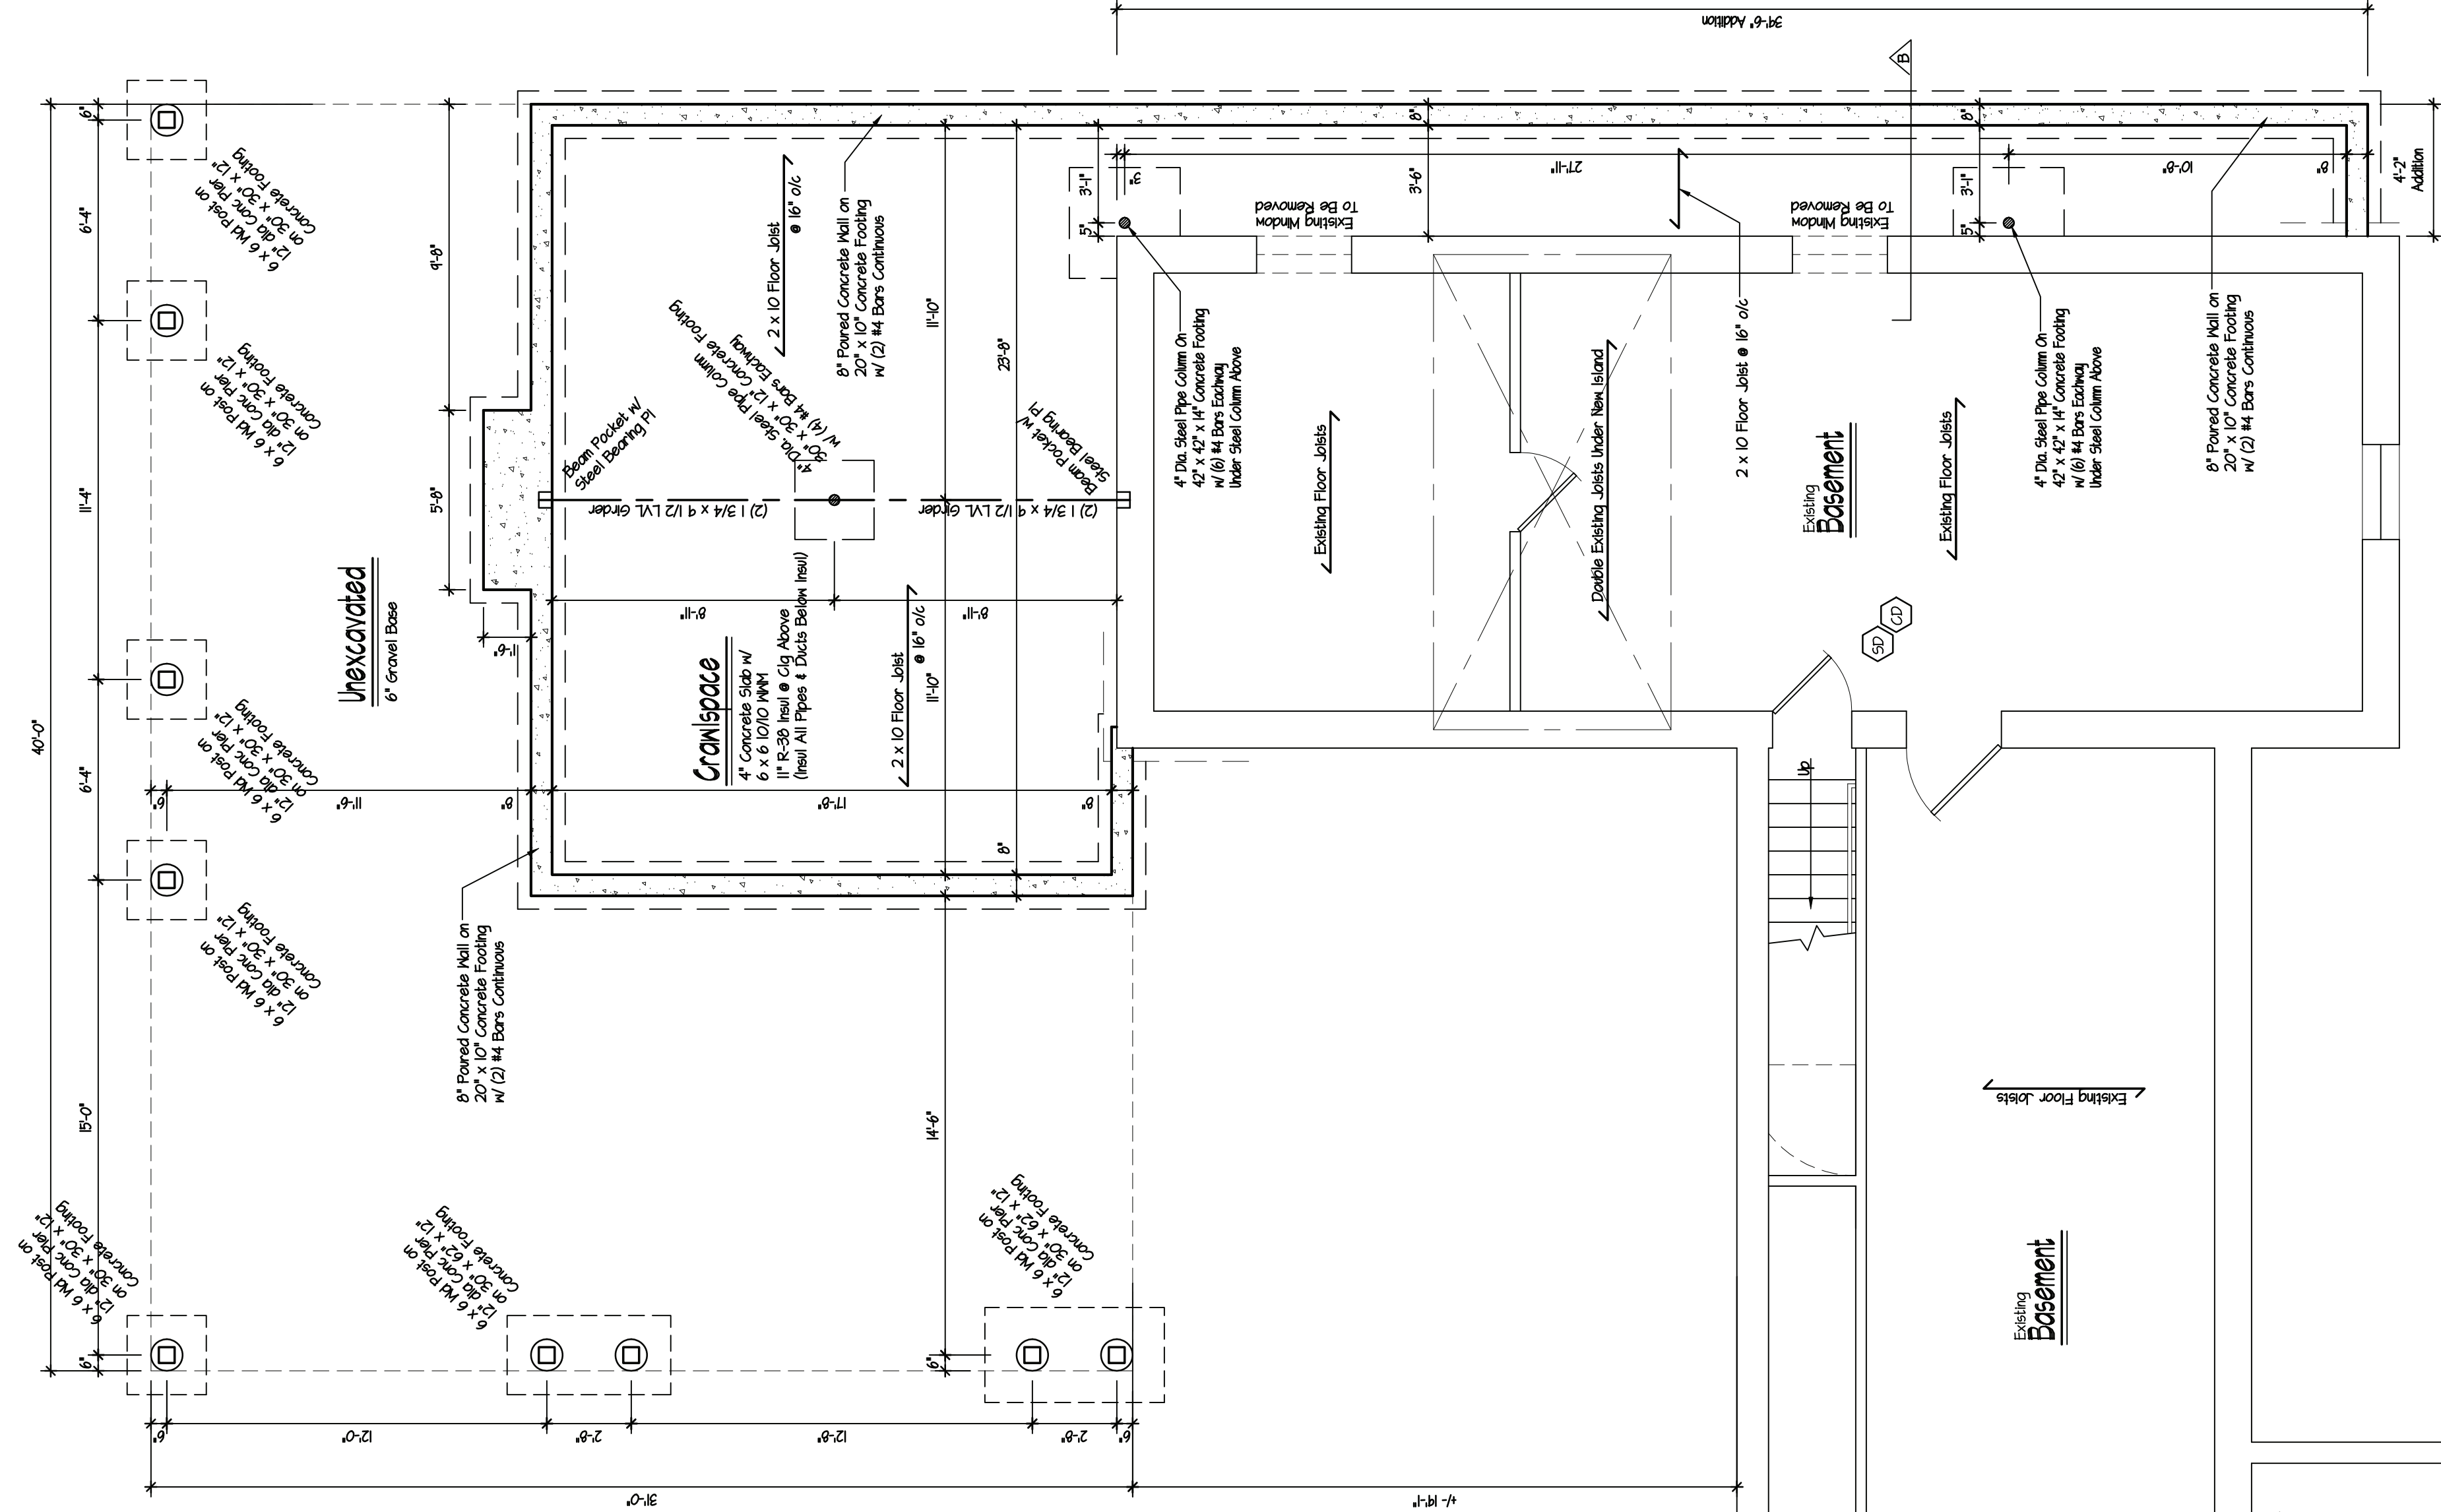

## Proposed Foundation Plan

Scale: 1/4" = 1'-0"

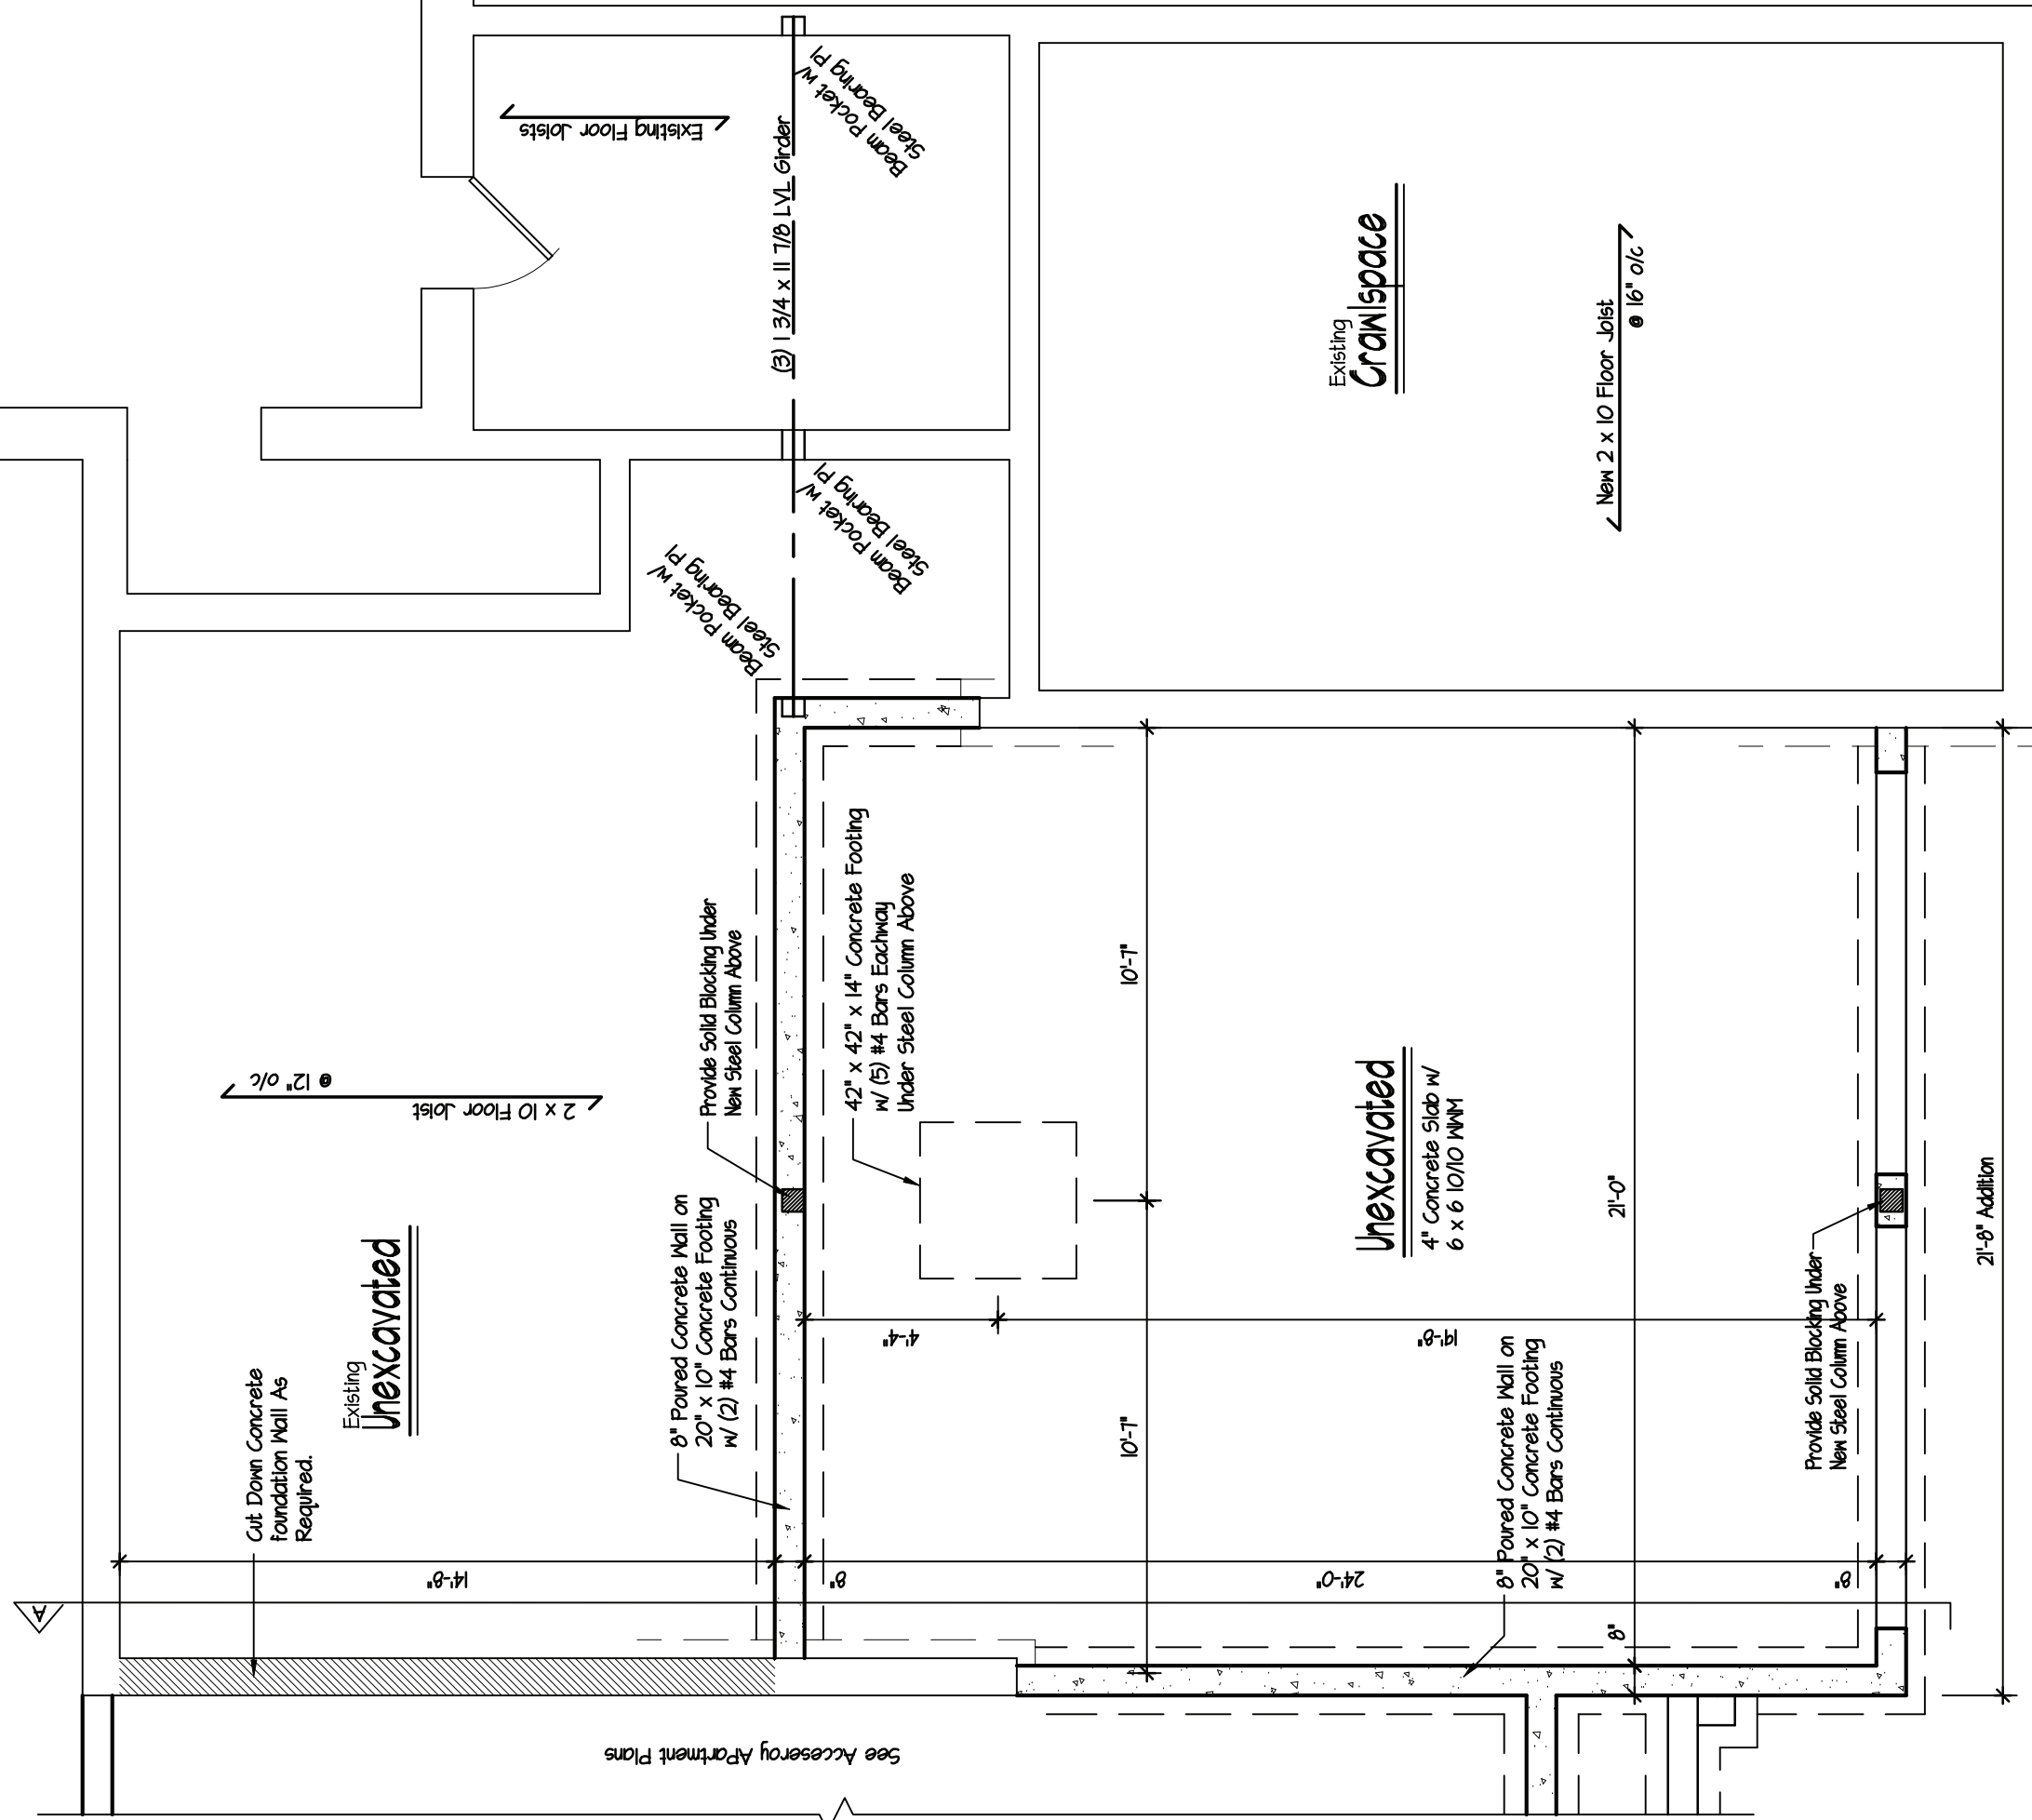

### Addition For

231 Clinton Avenue  
Dobbs Ferry, NY

As Built 10/10/23  
Revision Date  
Date Nov. 24, 2022  
Job No 222-118

### Drawing

4 OF 2

DeMasi Architects P.C.

105 SMITH AVENUE, MOUNT KISCO, NEW YORK 10549

PHONE: (914) 666-3850 EMAIL: Lou@DemasiArchitects.com



These plans are the property of the Architect. Any use or reproduction in whole or part without the written authorization of the Architect is prohibited. Any person or corporation who uses these plans for any purpose other than that authorized by the Architect will be responsible to compensate the Architect.

These plans are not valid for a building permit unless accompanied by a professional seal and signature for the construction of one structure only by the person whose name appears on the plans.

Do Not Scale Prints





Scale: None

Riser diagram taken from "2020 Residential Code Of New York State"  
Figure N5: Refer to diagram for all other information


Playroom Calculations:

## Calculation For Light


Room Area..... 640 sq ft  
 Lumens required..... 6.5 lux  
 $640 \times 6.5 = 4,195$   
 4,195 lumens required  
 18-25 watt CFL = 110 lumens per lamp  
 $4,195 / 110 = 4.04$  or 5 lamps Required  
 10 Lamps Provided

### Calculation For Ventilation

Room Area: 640 sq ft  
Ceiling Hgt. .... 7'-8"  
Cubic Vol. .... 5291 cf  
Divide by 35 air change per hour  
Multiply by 30 air change per hour  
30.06 cfm (min. Airflow required)  
Provides Panasonic "Whisper Comfort" Energy Recovery Ventilator  
Model FV-0AVE1 OR EQUAL that will provide  
20 to 40 cfm At Finished Area

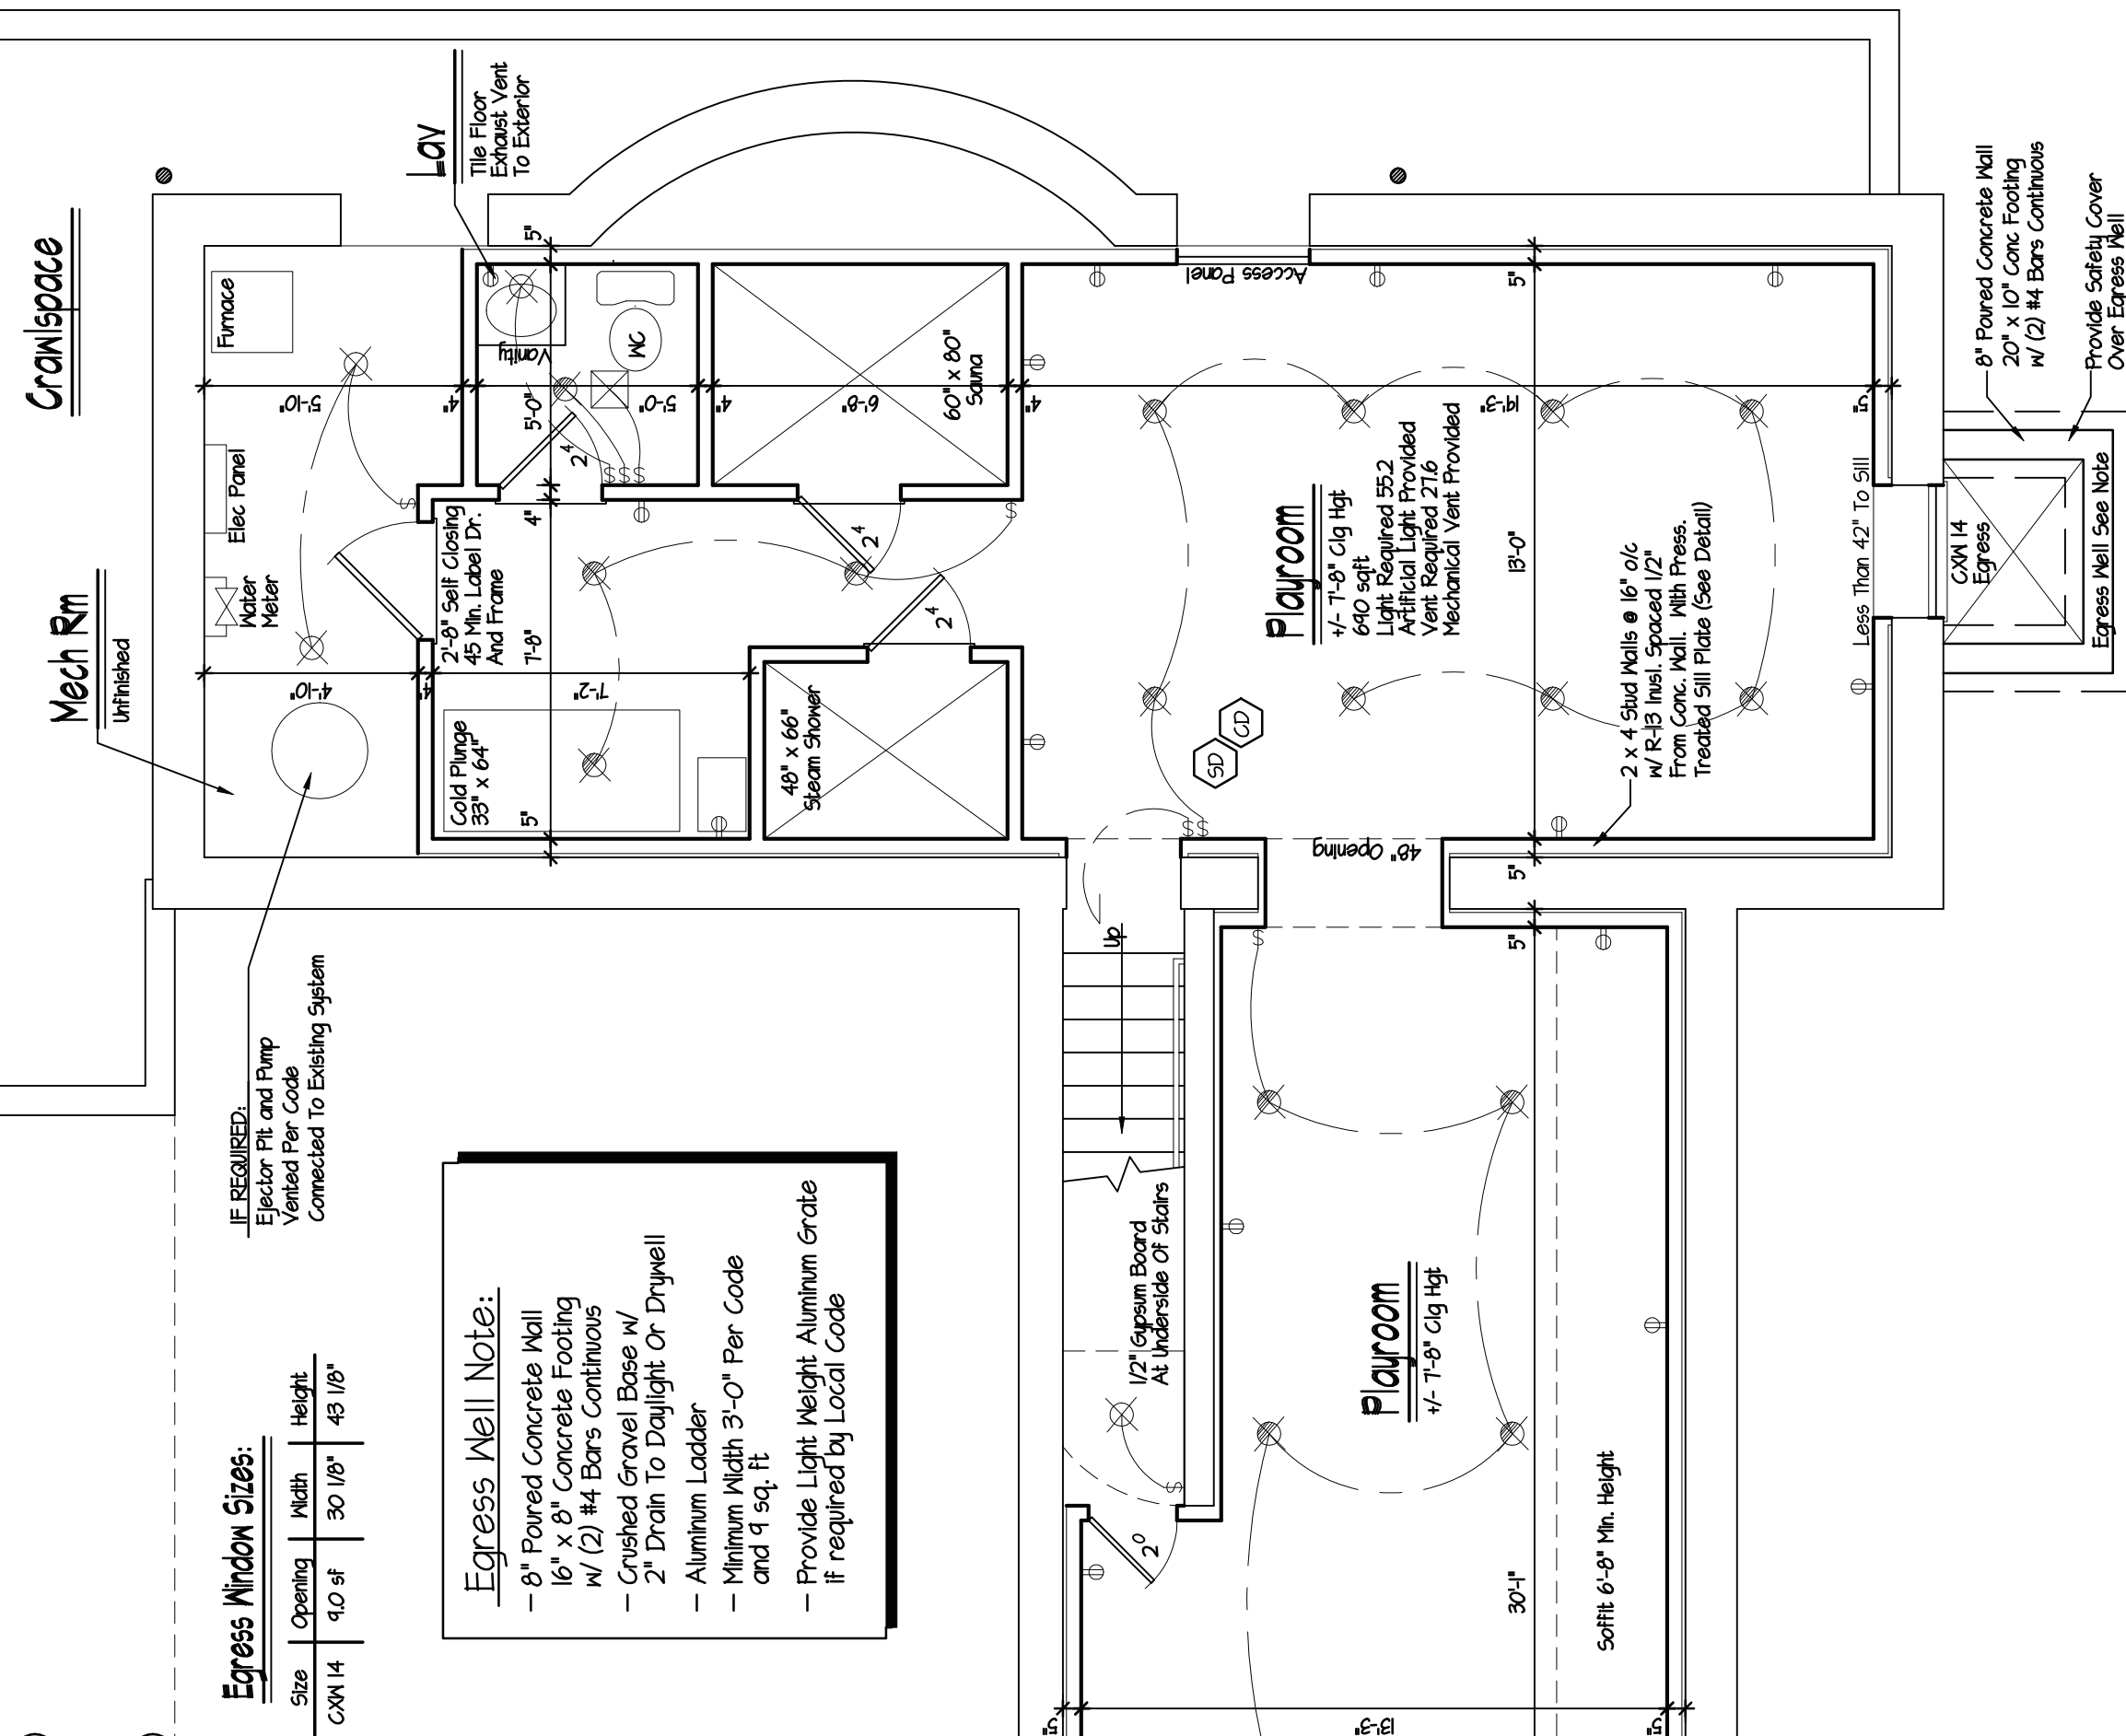

Scale:  $1/2" = 1'-0"$

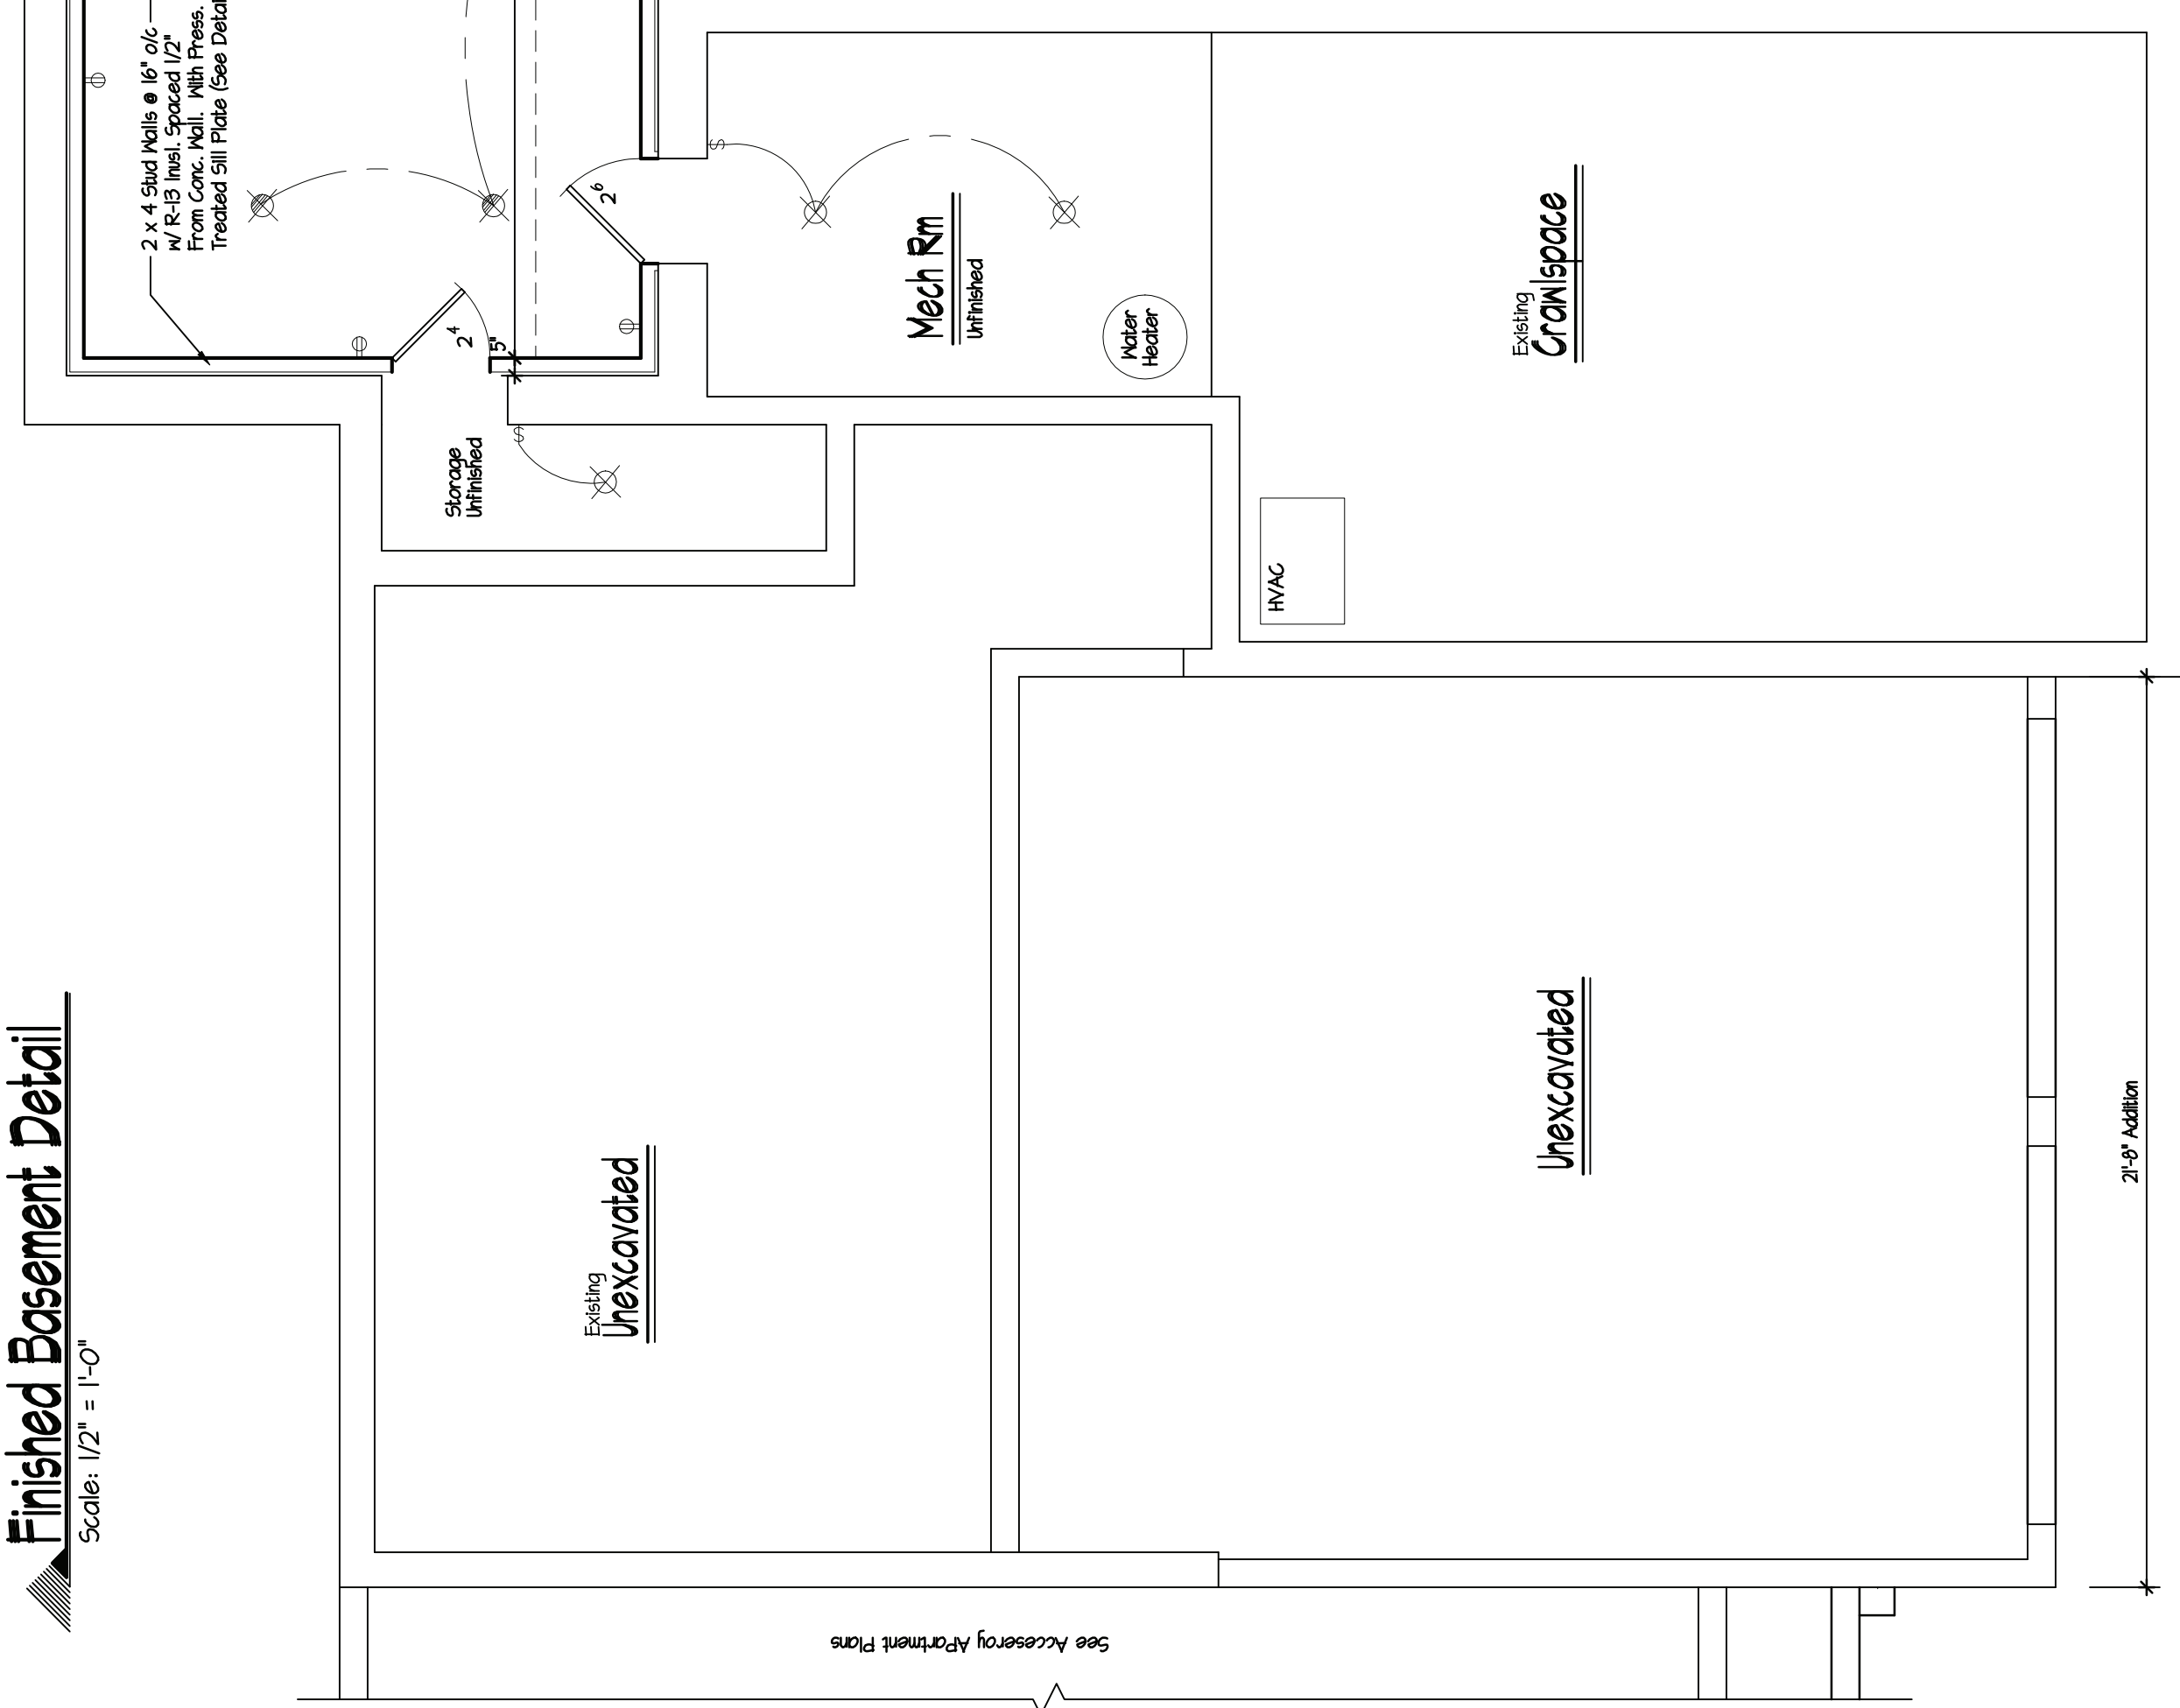

Proposed  
**Finished Basement Plan**  
Scale: 1/4" = 1'-0"

Scale:  $1/4'' = 1'-0''$

## Finished Basement For

231 Clinton Avenue  
Dobbs Ferry, NY



These plans are the property of the Architect. Any use or reproduction in whole or part without the written authorization of the Architect is prohibited. Any person or corporation using plans without proper authorization will be responsible to the Architect.

These plans are not valid for a building permit unless originally signed and sealed by the Architect and are for the construction of one structure only by the person whose name appears on the plans.

DeMasi Architects P.C.



105 SMITH AVENUE, MOUNT KISCO, NEW YORK 10549

PHONE: (914) 666-3858

EMAIL: Lou@DemasiArchitects.com

Do Not Scale Prints




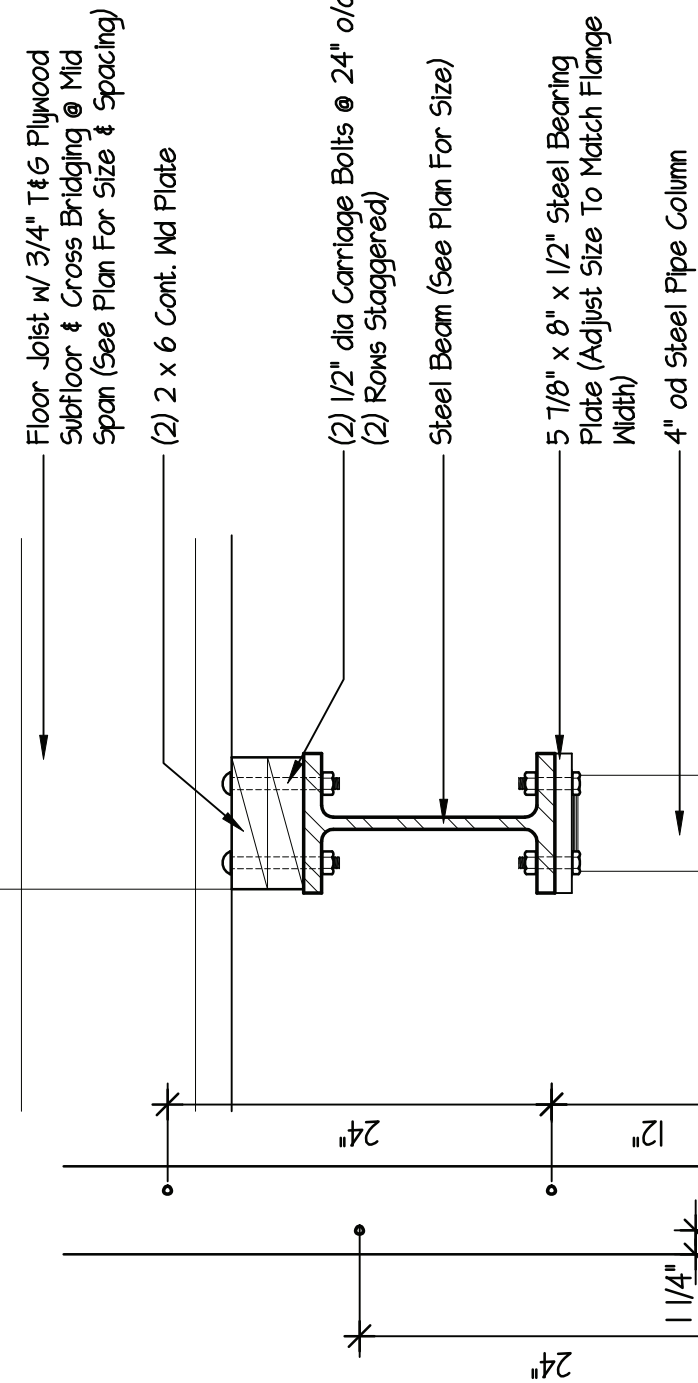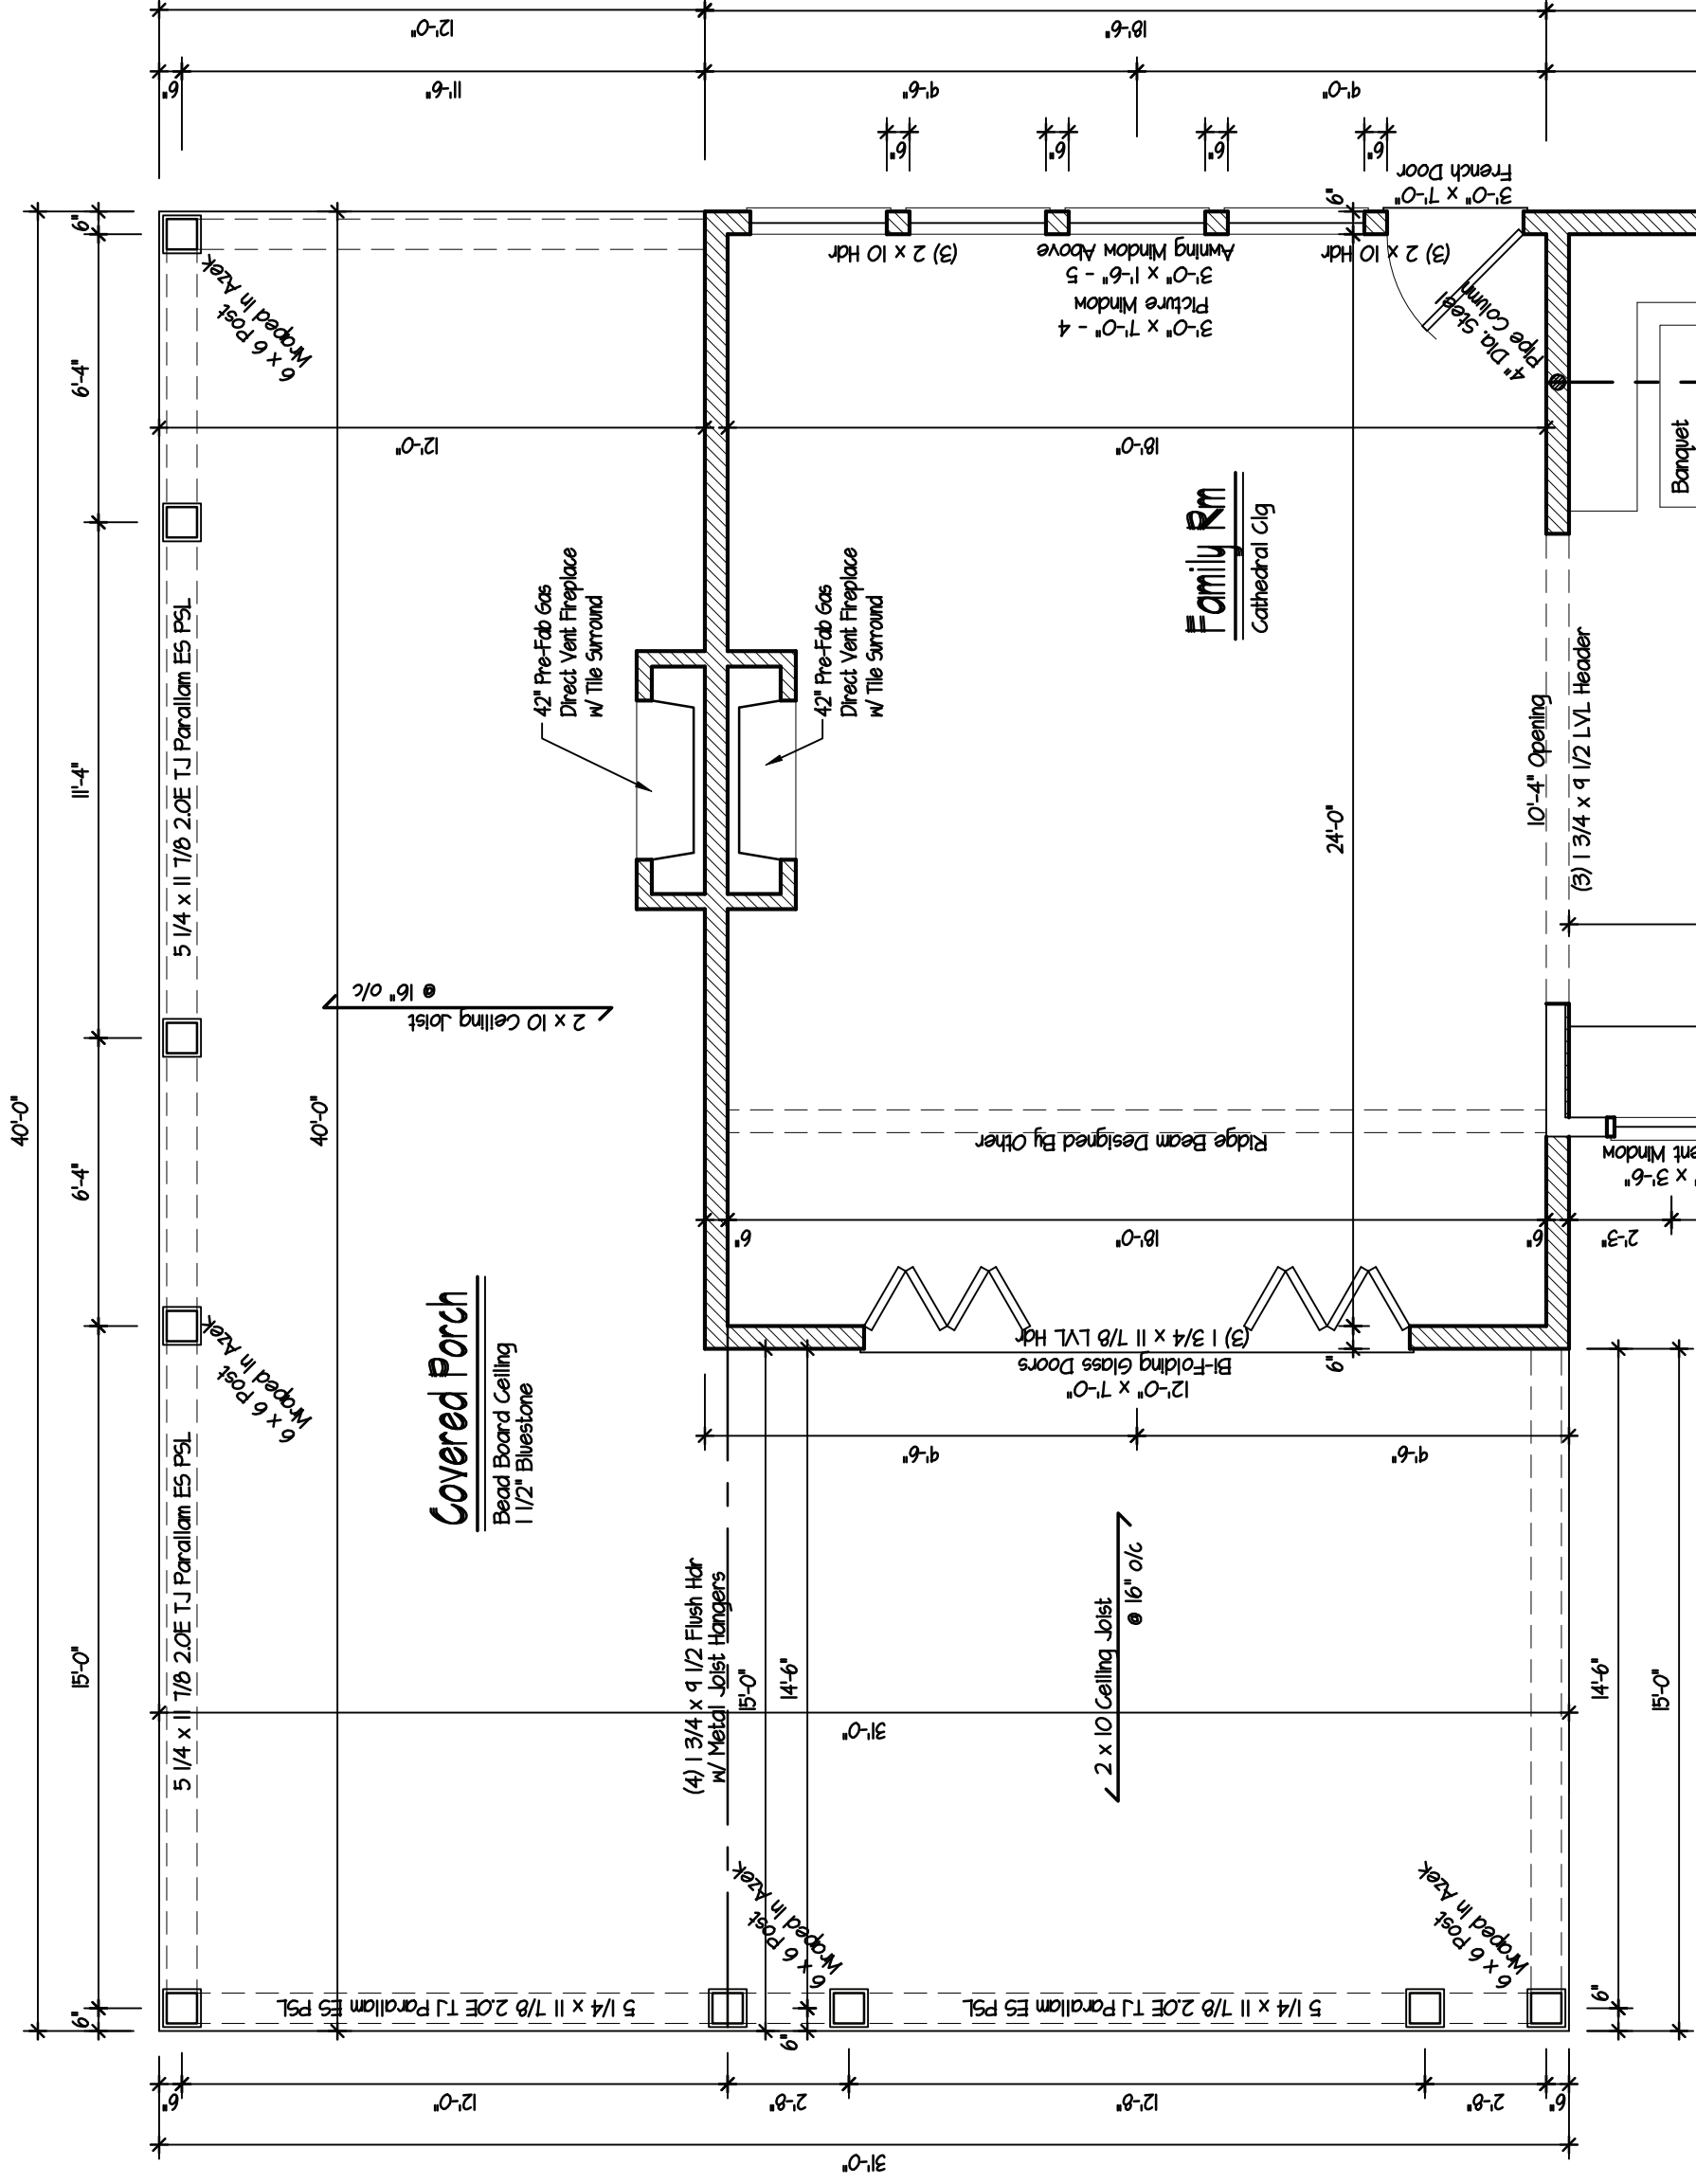

**Bolt Pattern**  
Scale: None

## Steel Beam Detail @ Garage

Scale: 1 1/2" = 1'-0"

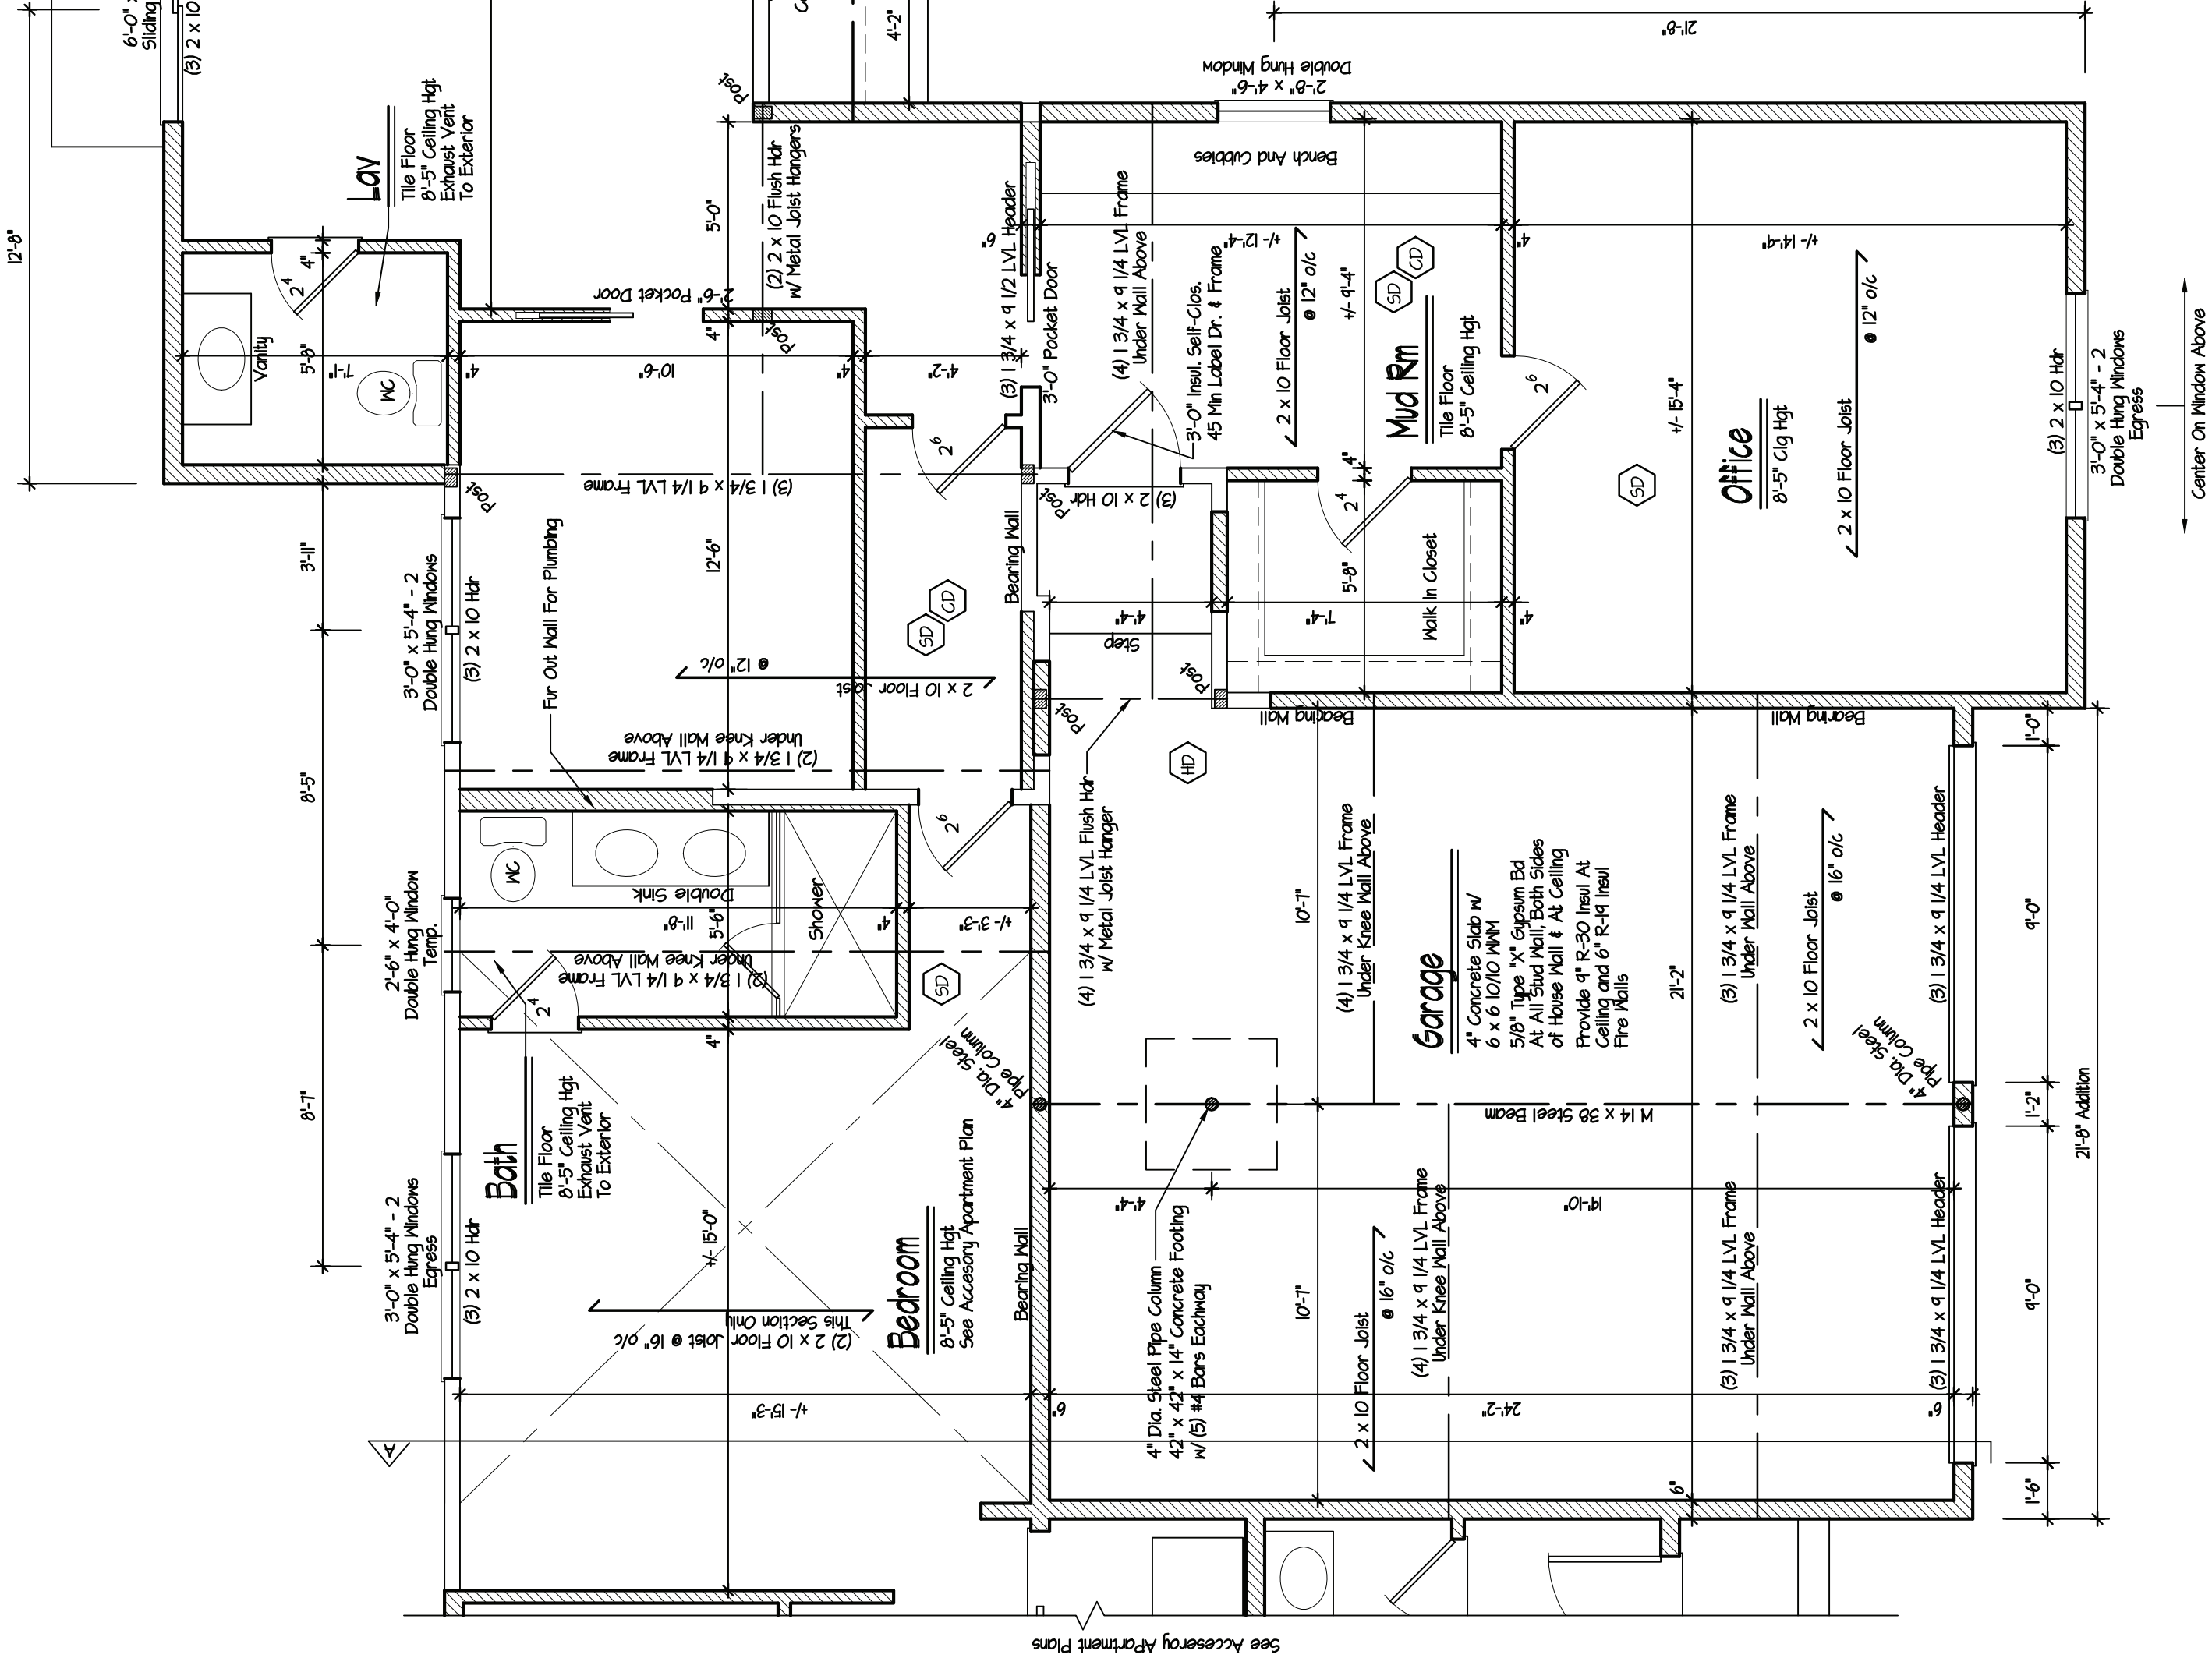

## Proposed First Floor Plan

Scale: 1/4" = 1'-0"

### Notes:

- All Framing Members To Be # 2
- Double Framing Under All Partitions Parallel To Framing
- If The Floor Is To Be MID Job Consult Architect For Additional Framing Required

### Legend:

- 2 x Wood Post (Match Beam Width or As Noted)
- Smoke Detector
- W/ Battery Back-Up
- Carbon Monoxide Det
- W/ Battery Back-Up
- Heat Detector
- W/ Battery Back-Up
- Existing Wall (To Remove)
- New Wall

### Wood Header Schedule

#### Header Size

- Up To 3'-0"
- Up To 4'-0"
- Up To 6'-0"

#### Span

- (2) 2 x 8 1st
- (2) 2 x 10 1st
- (2) 2 x 10 1st

#### Note:

Unless Otherwise Noted On Plans

### Window Note:

- All Glazing To Be Low E Insulated Glazes
- All Windows Within 18" Of Floor To Have Tempered Glazes (Double Hangs-Bottom Sash Only, All Others Full Unit).
- All Glazing In Doors & Windows Enclosing Hot Tiles, Whirlpool Tiles, Sponges, Steam Rooms, Bathtubs and Showers Within 60" Of Window or Door Unit Shall Have Tempered Glazes.
- All Egress Windows To Have A Minimum Clear Opening Area Of 5.7 Sq Total W/ 24" min Clear Opening Height & 20" min Clear Width. Refer To Manufacturers Specifications For All Other Information.
- All Windows or Doors Marked W/ "E" To Have Full Unit Tempered.
- All Windows Sills Within 24" Above The Finished Floor & Greater Than 12" Above Requires Fall Protection. See Section R902.2 For More Info.

### Addition For

231 Clinton Avenue  
Dobbs Ferry, NY

As Built	10/10/23
Revision	Date
Date	Nov. 29, 2022
Job No	222-118

### Drawing

51 OF 12

These plans are the property of the Architect. Any use or reproduction in whole or part without the written authorization of the Architect is prohibited. Any person or corporation who uses these plans for any purpose other than that for the construction of one structure only by the person whose name appears on the plans.



DeMasi Architects P.C.



105 SMITH AVENUE, MOUNT KISCO, NEW YORK 10549

PHONE: (914) 666-3850

EMAIL: Love@DemasiArchitects.com

Do Not Scale Prints




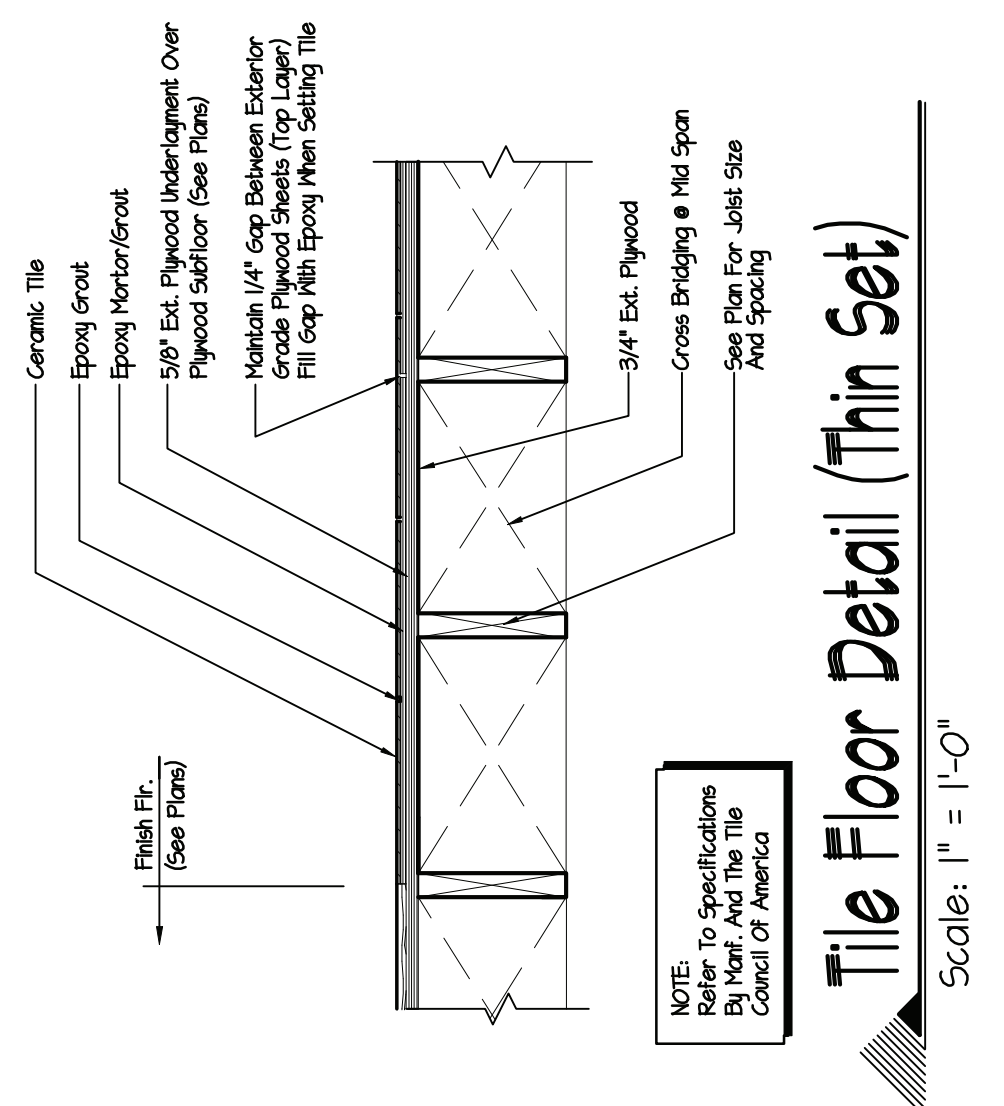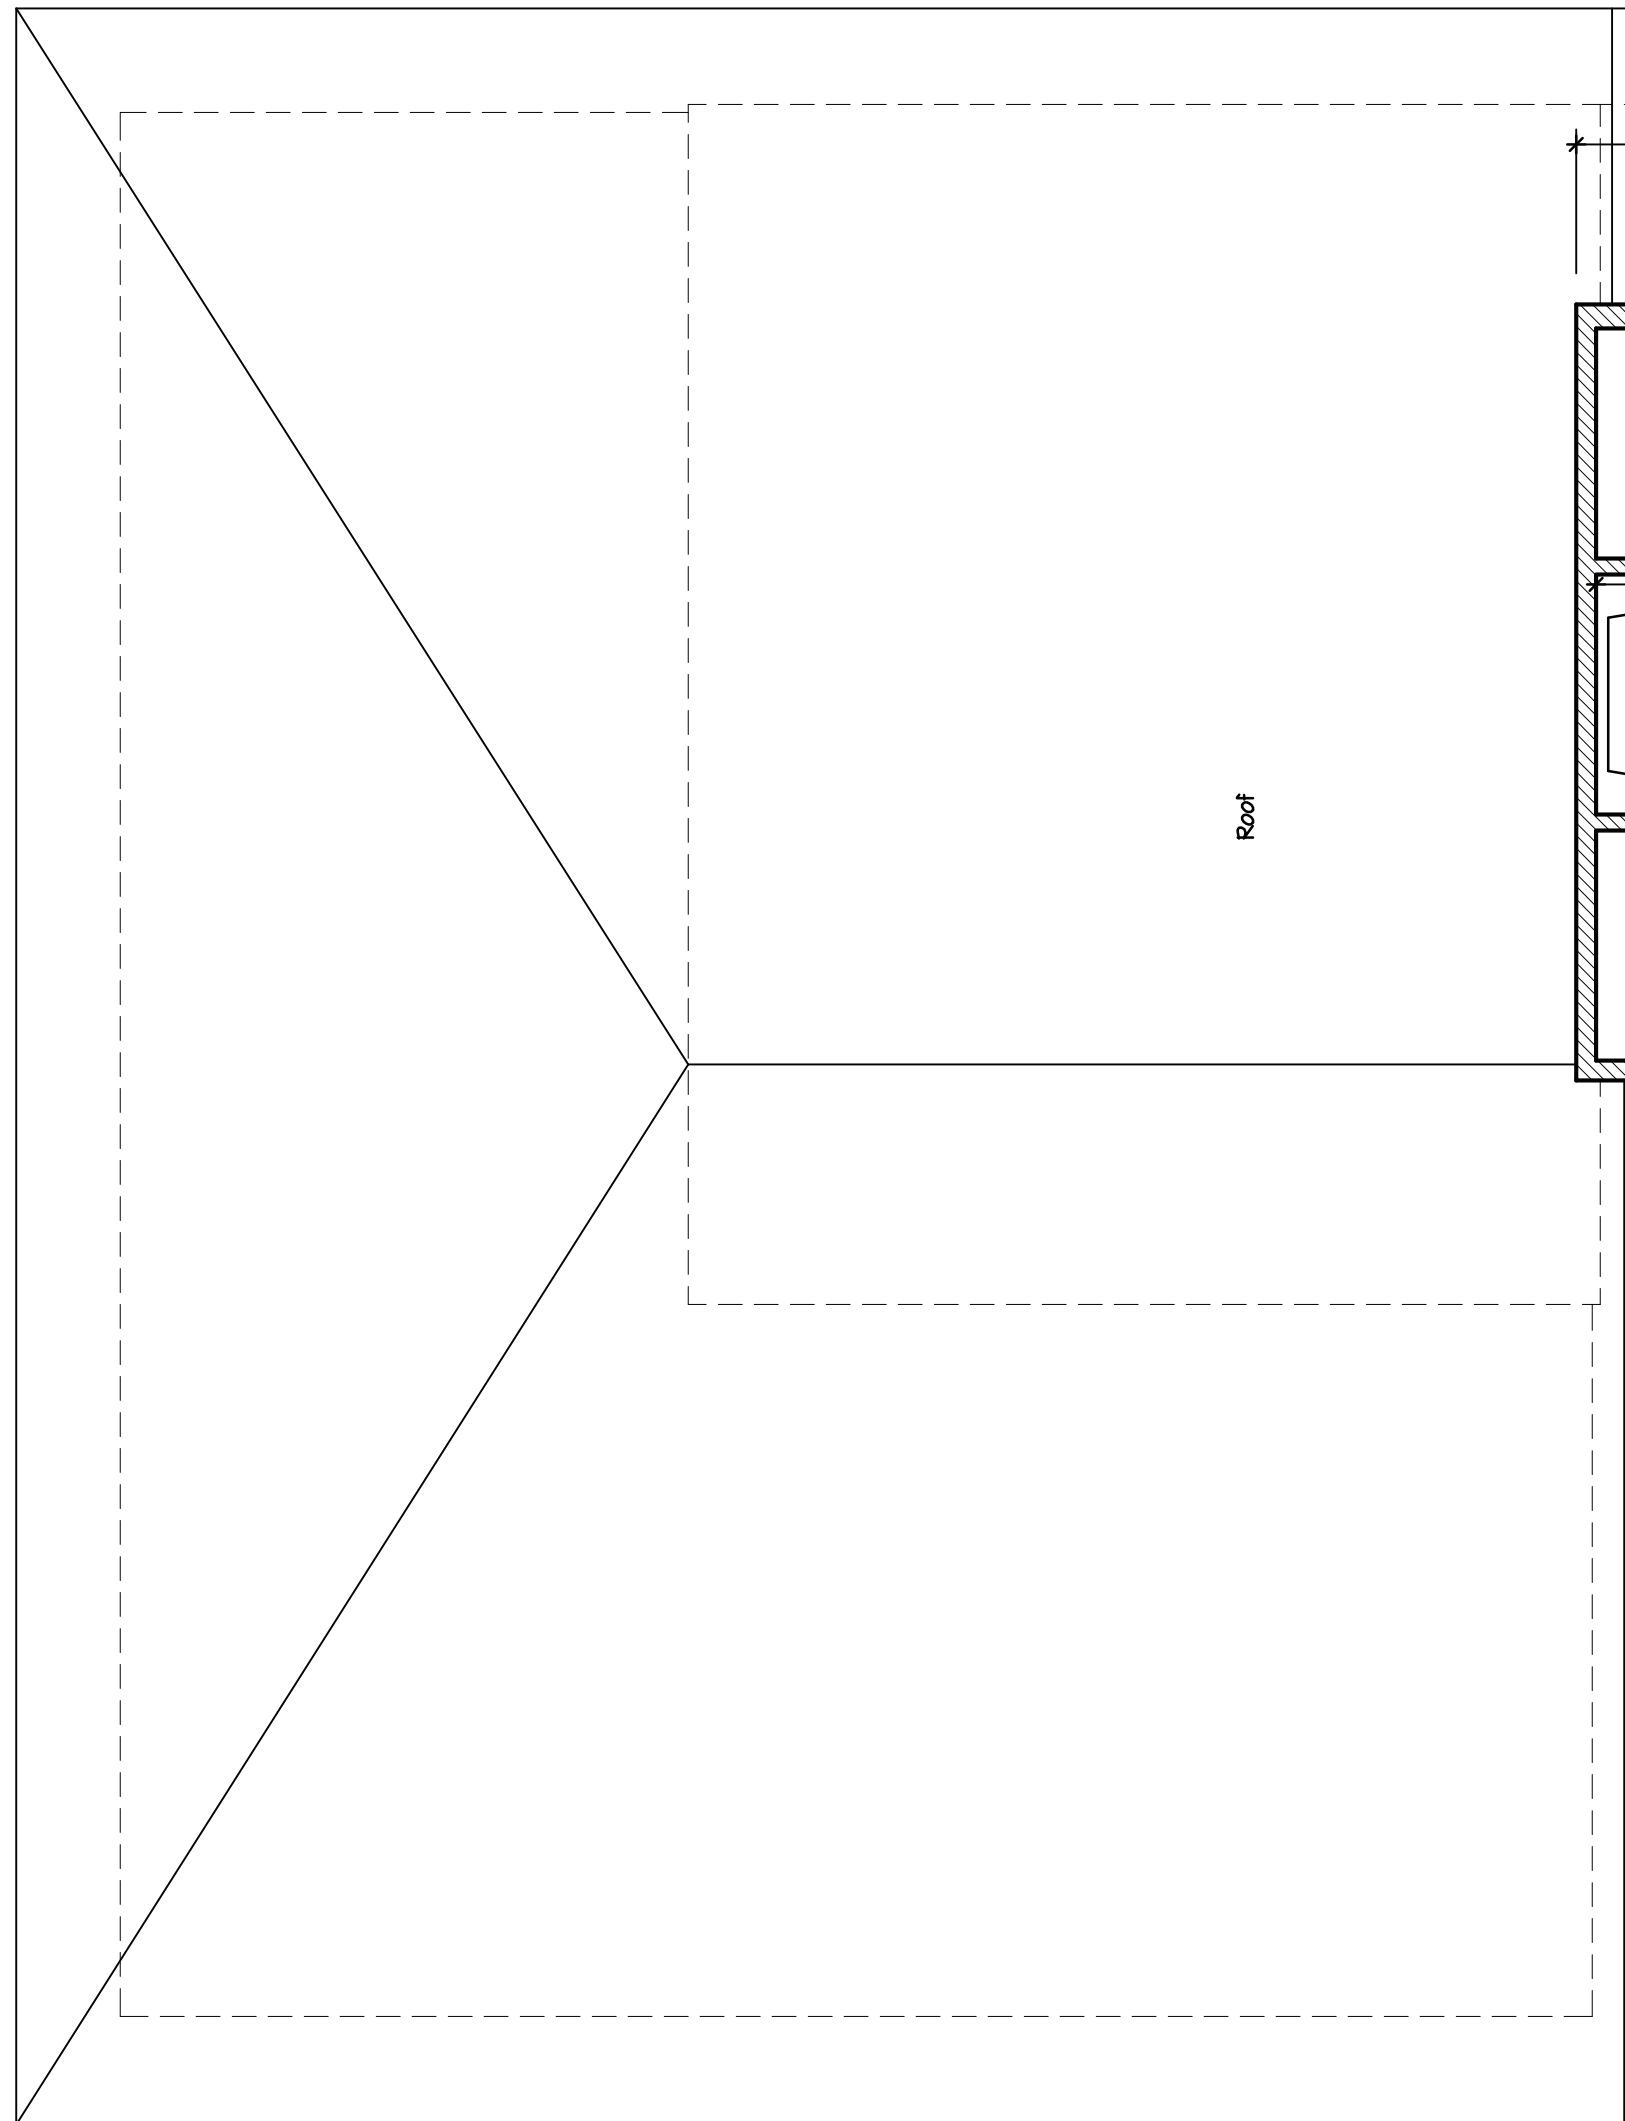

NOTE:  
Refer to Specifications  
By Name, And The Tile  
Control On Plans (S)

### Tile Floor Detail (Thin Set)

Scale: 1" = 1'-0"

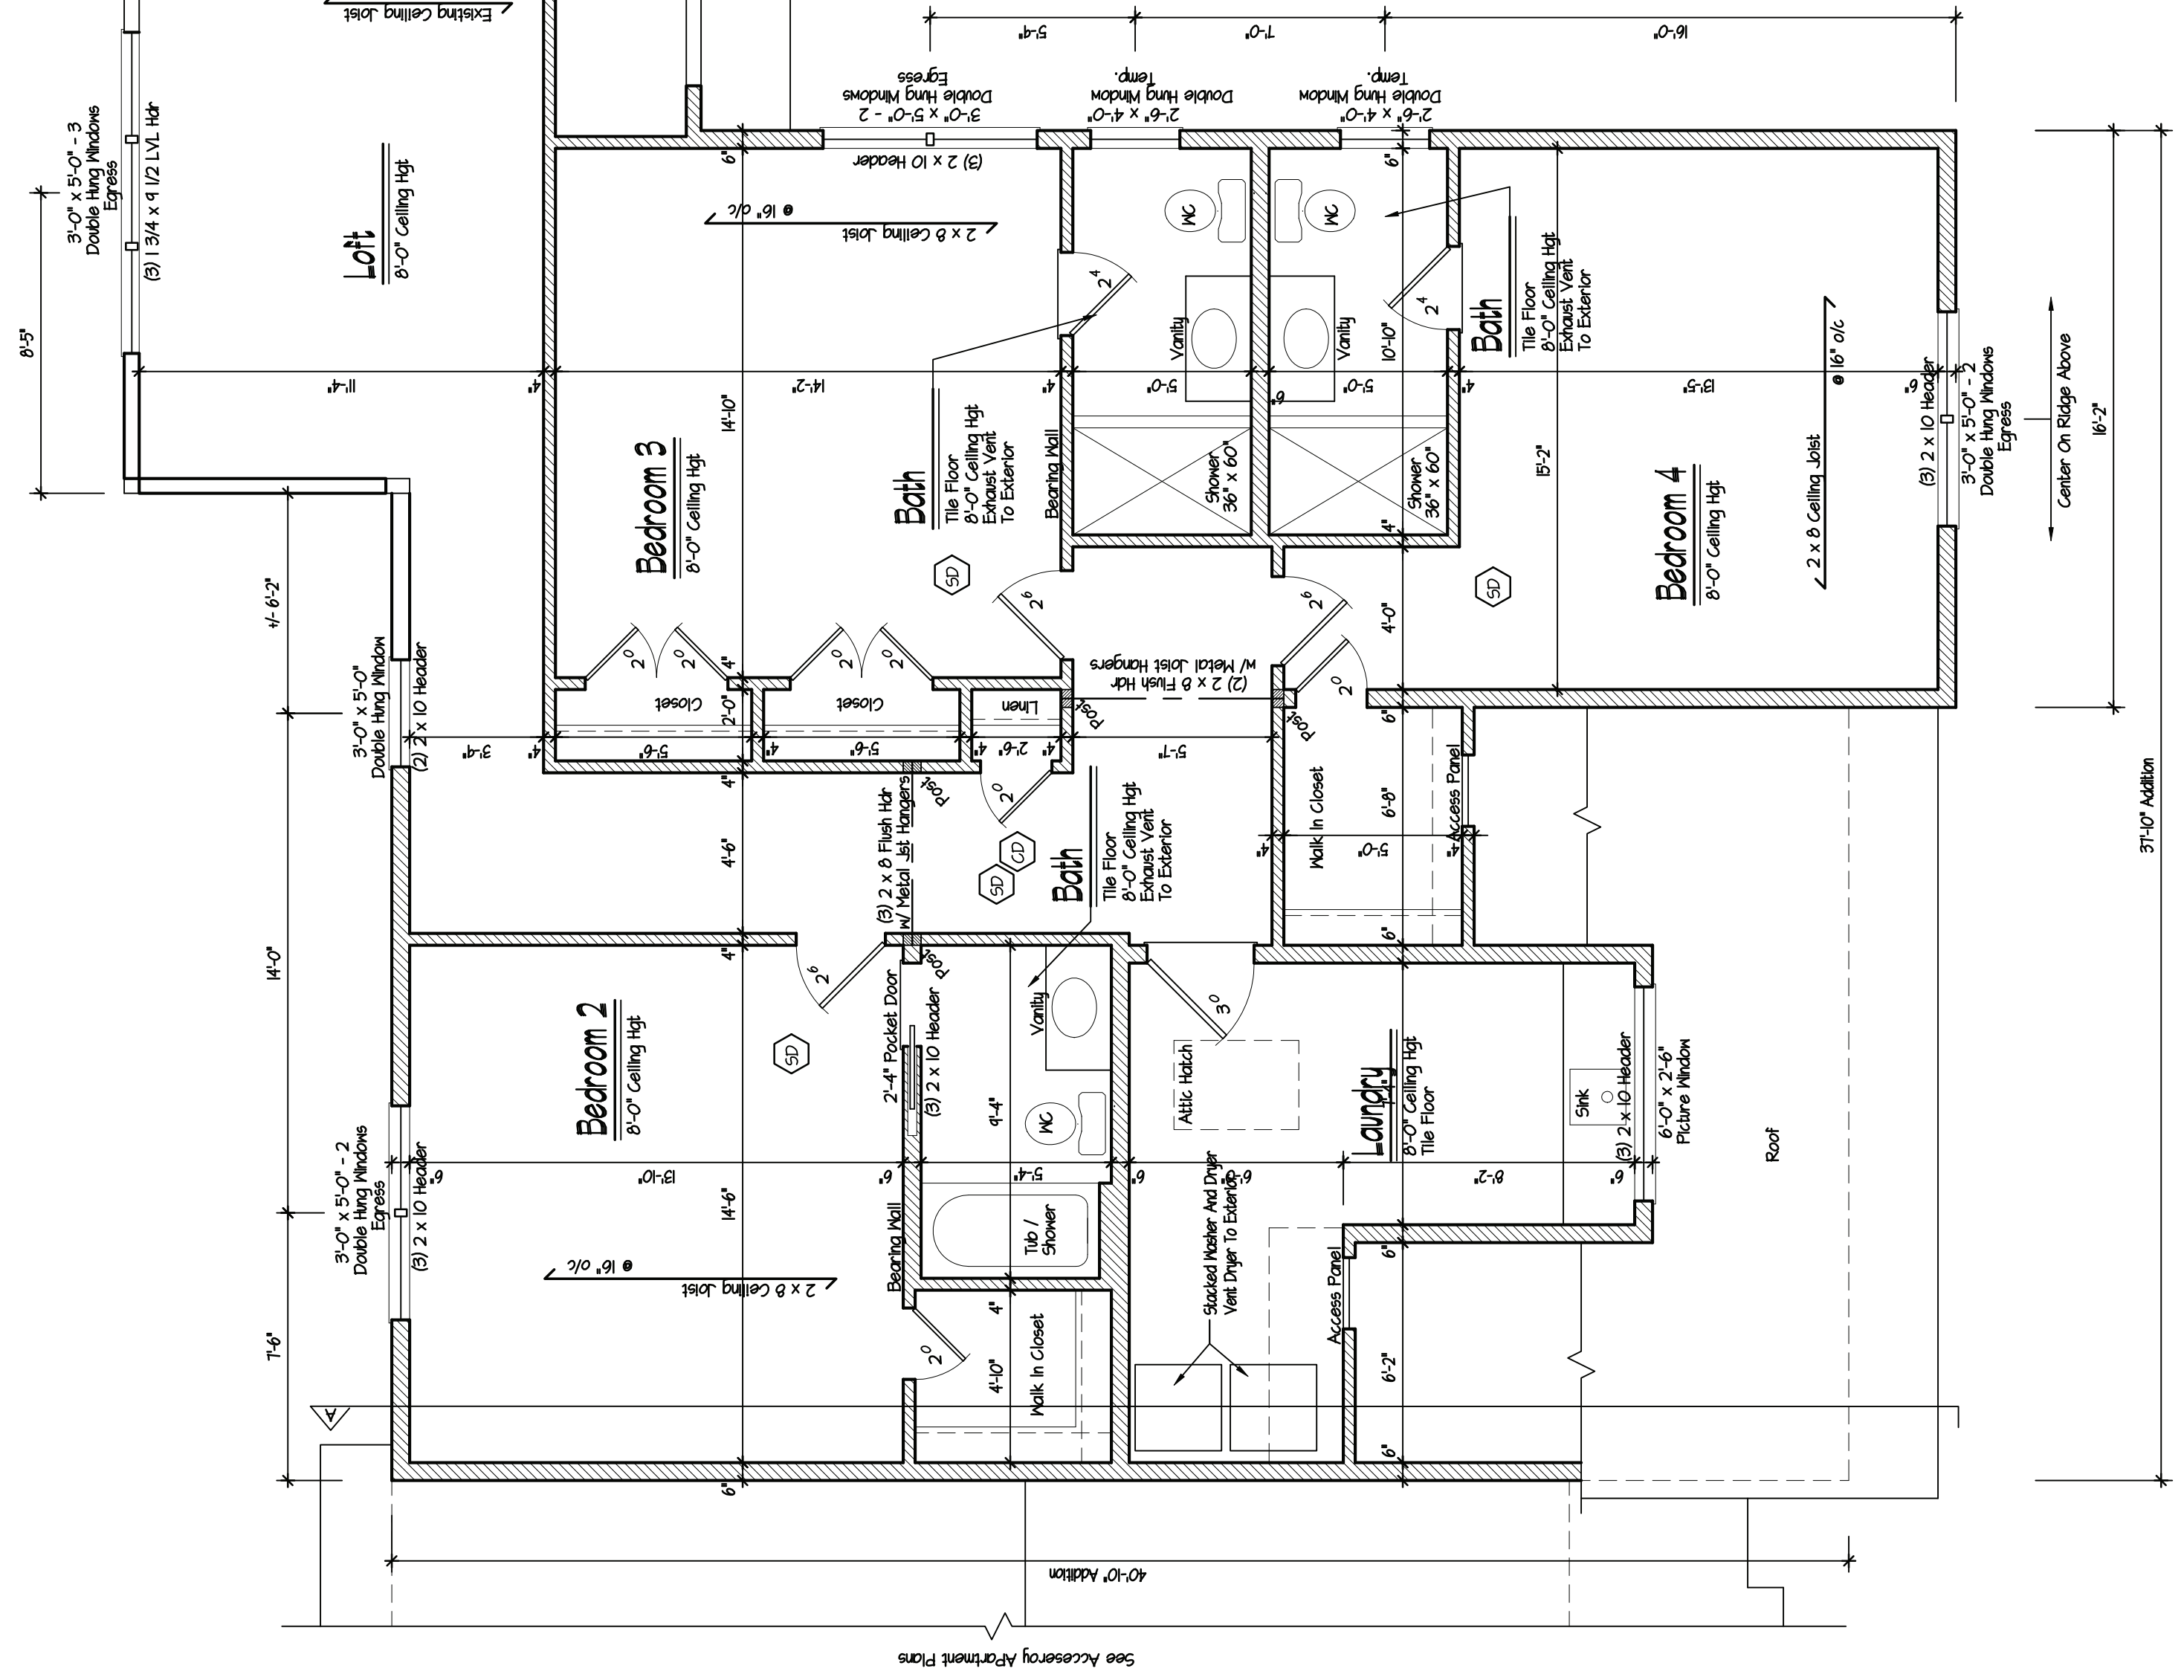

### Proposed Second Floor Plan

Scale: 1/4" = 1'-0"

**Notes:**

- All Framing Members To Be # 2 Douglas Fir - Larch Or Better
- Double Frame Under All Partitions Parallel To Framing
- If Tile Floor Is To Be MD Job, Contact Architect For Additional Framing Request

**Legend:**

- 2 x 10 Wood Deck Match Beam With 6" x 6" Noted
- Spoke Detector
- N' Batting Back-Up
- Carbon Monoxide Det
- N' Batting Back-Up
- Existing Mail (To Room)
- New Mail

**Wood Header Schedule**

Span	Header Size
Up To 3'-0"	(2) 2 x 6
Up To 4'-0"	(2) 2 x 10
Up To 6'-0"	(2) 2 x 10

**Note:**  
Unless Otherwise Noted On Plans

#### Addition For

231 Clinton Avenue  
Dobbs Ferry, NY

As Built	10/10/23
Revision	Date
Date	Nov. 24, 2022
Job No	222-118
Drawing	6 OF 2

These plans are the property of the Architect. Any use or reproduction in whole or part without the written authorization of the Architect is prohibited. Any person or corporation who reproduces these plans without the written authorization of the Architect will be responsible to compensate the Architect.

These plans are not valid for a building permit unless accompanied by a professional seal and signature for the construction of one structure only by the person whose name appears on the plans.




**DeMasi Architects P.C.**

105 SMITH AVENUE, MOUNT KISCO, NEW YORK 10549


PHONE: (914) 666-3858 EMAIL: [Love@DemasiArchitects.com](mailto:Love@DemasiArchitects.com)

Do Not Scale Prints



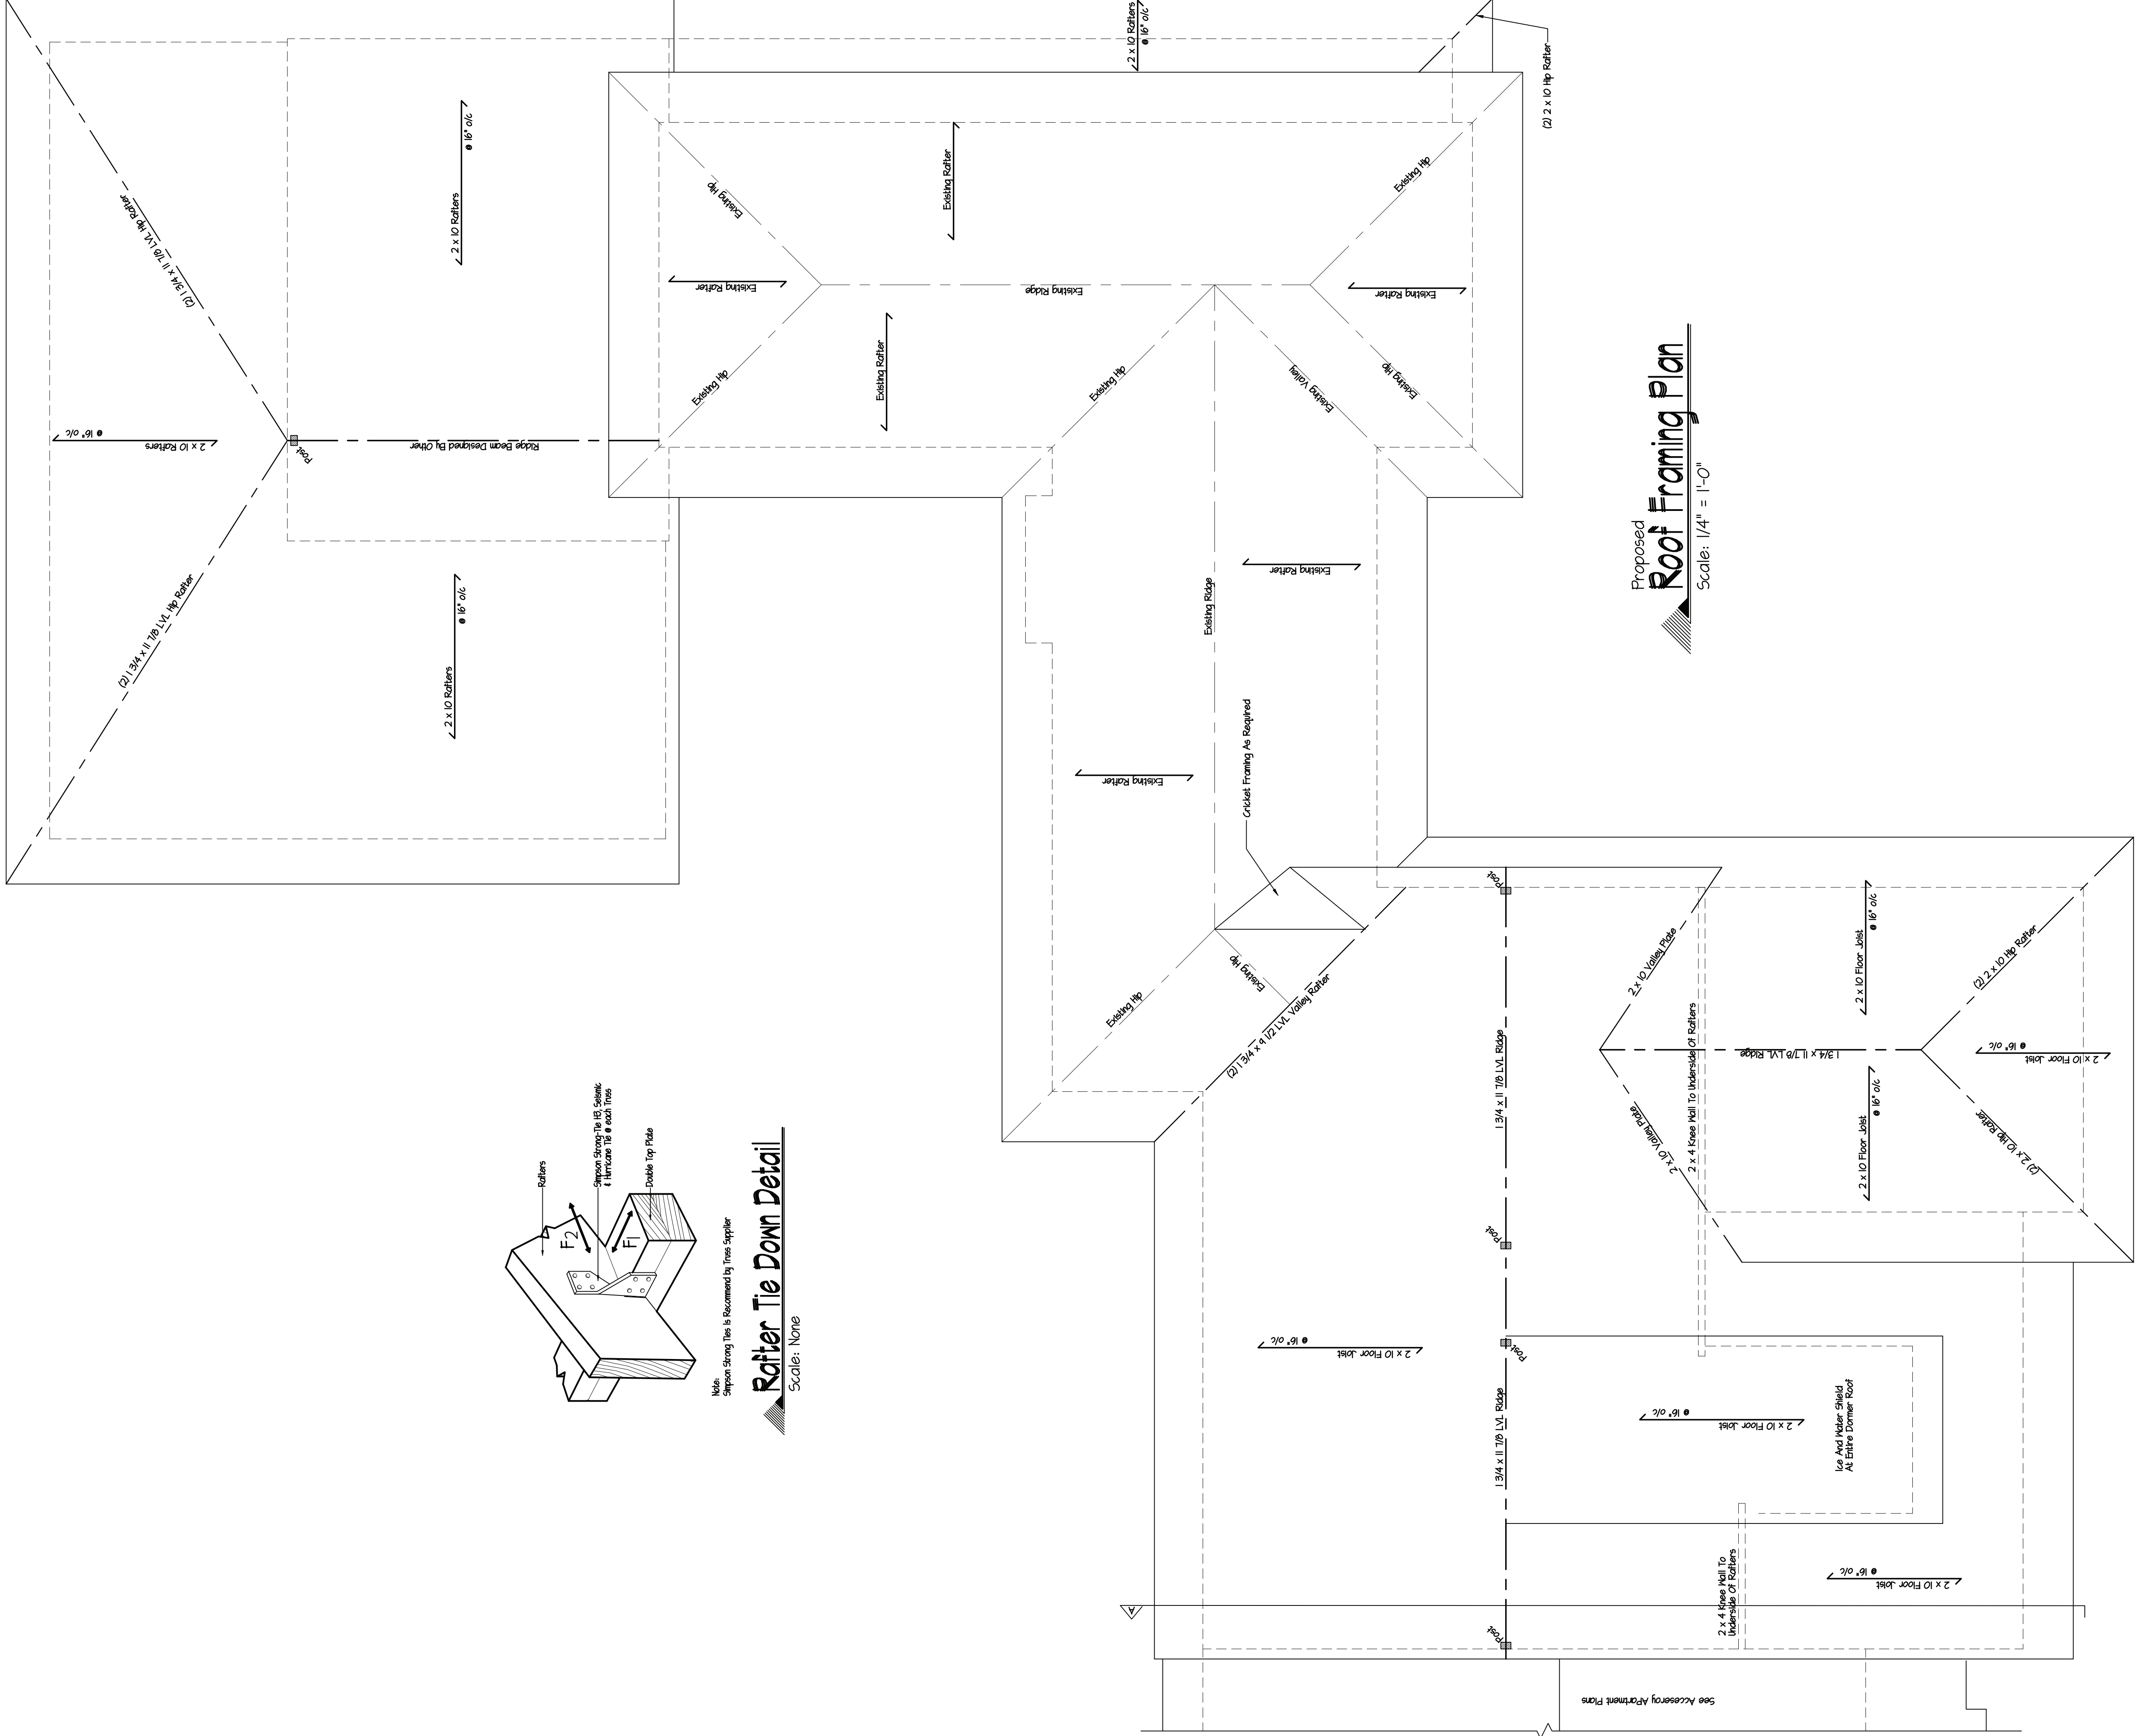

Proposed  
**Roof Framing Plan**  
Scale: 1/4" = 1'-0"

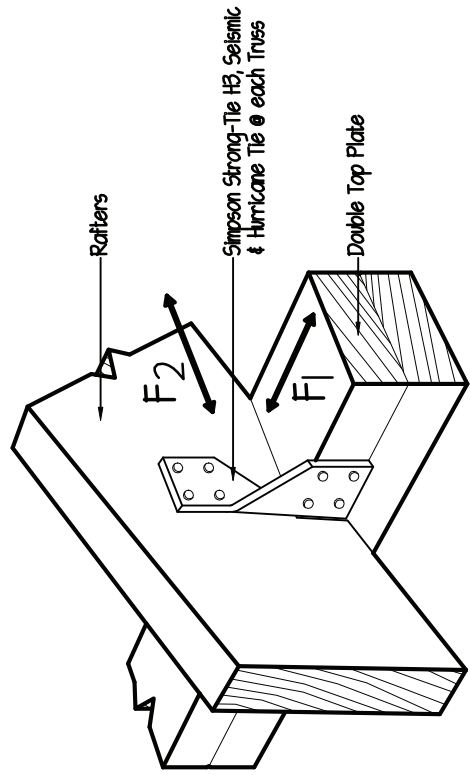


Note:  
Simpson Strong Tie is Recommended by This Supplier

**Rafter Tie Down Detail**  
Scale: None

These plans are the property of the Architect. Any use or reproduction in whole or part without the written authorization of the Architect is prohibited. Any person or corporation who reproduces these plans without the written authorization of the Architect will be responsible to compensate the Architect.

These plans are not valid for a building permit unless accompanied by a professional seal and signature for the construction of one structure only by the person whose name appears on the plans.

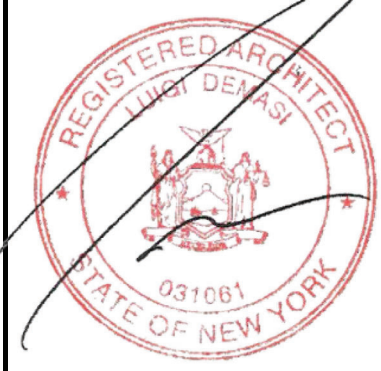

**DeMasi Architects P.C.**

105 SMITH AVENUE, MOUNT KISCO, NEW YORK 10549

PHONE: (914) 666-3850      EMAIL: [Lo@DemasiArchitects.com](mailto:Lo@DemasiArchitects.com)

Addition For

**231 Clinton Avenue  
Dobbs Ferry, NY**


As Built	10/10/23
Revision	Date
Date	Nov. 29, 2022
Job No	222-1181
Drawing	7 of 12










 Existing Wall  
 (To Be Removed)

 Existing Wall  
 (To Remain)


9 OF 2

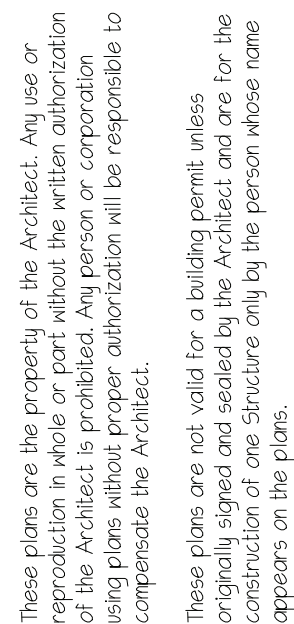

PHONE: (914) 666-3858

Do Not Scale Prints



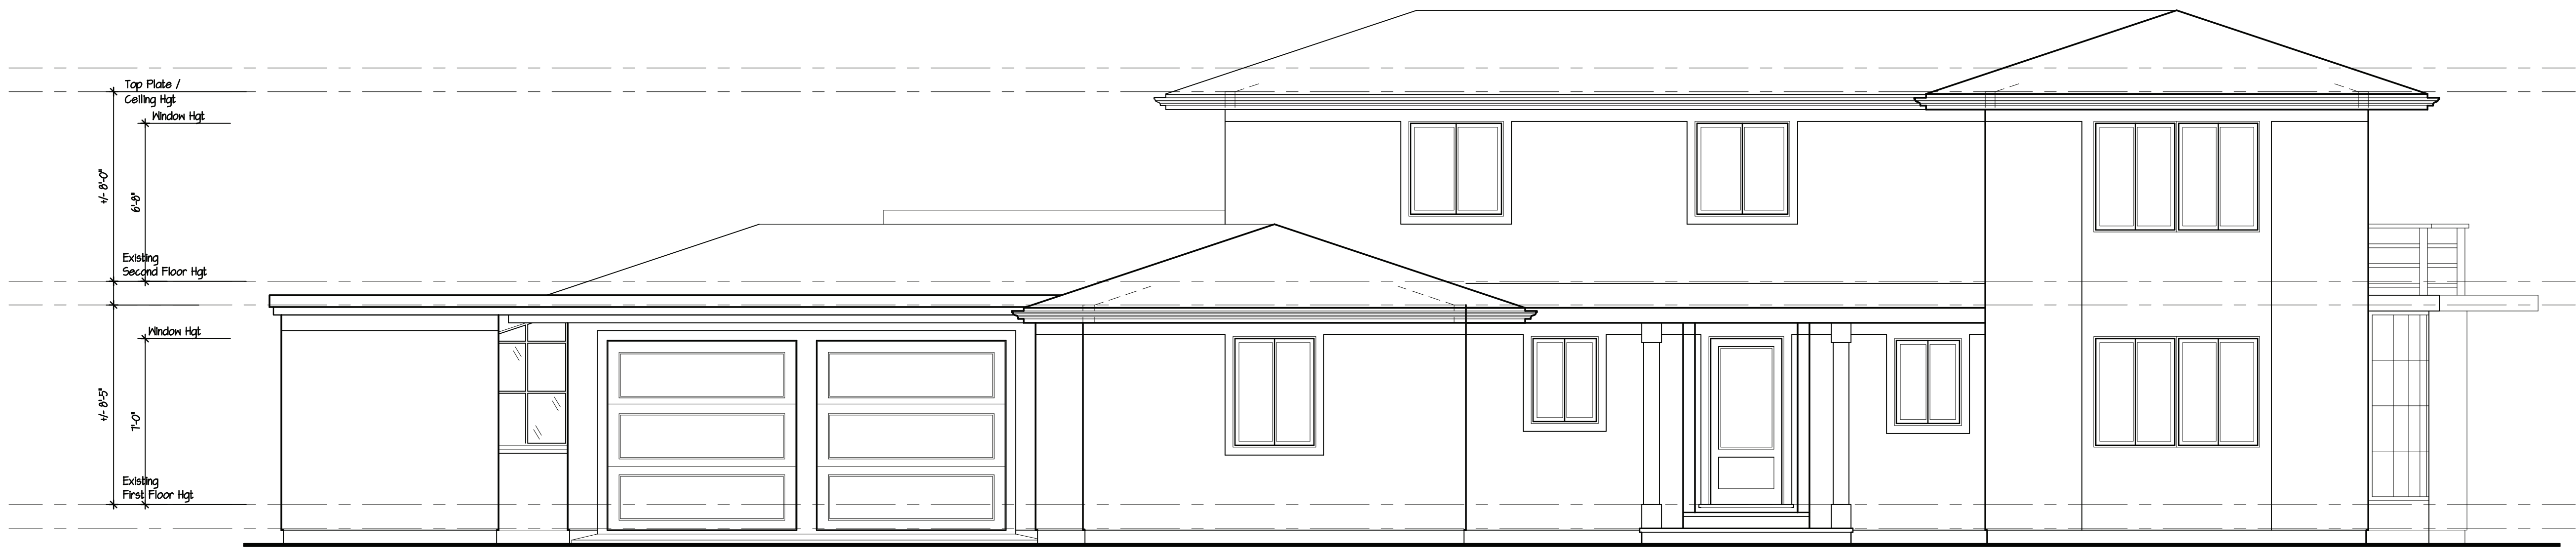

Existing  
**Front Elevation**  
Scale: 1/4" = 1'-0"



Existing  
**Rear Elevation**  
Scale: 1/4" = 1'-0"

**DeMasi Architects P.C.**  
105 SMITH AVENUE, MOUNT KISCO, NEW YORK 10549  
EMAIL: [Lo@DemasiArchitects.com](mailto:Lo@DemasiArchitects.com)



These plans are the property of the Architect. Any use or reproduction in whole or part without the written authorization of the Architect is prohibited. Any person or corporation who reproduces these plans without the written authorization of the Architect will be responsible to compensate the Architect.  
These plans are not valid for a building permit unless accompanied by a signed and sealed certificate of approval for the construction of one structure only by the person whose name appears on the plans.

Addition For

**231 Clinton Avenue  
Dobbs Ferry, NY**

As Built	10/10/23
Revision	Date
Date	Nov. 24, 2022

Job No	222-118
--------	---------

Drawing	10 OF 2
---------	---------





Existing  
**Left Side Elevation**  
Scale: 1/4" = 1'-0"



Existing  
**Right Side Elevation**  
Scale: 1/4" = 1'-0"



These plans are the property of the Architect. Any use or reproduction in whole or part without the written authorization of the Architect is prohibited. Any person or corporation who reproduces these plans without the written authorization of the Architect will be responsible to compensate the Architect.

These plans are not valid for a building permit unless countersigned and sealed by the Architect for the construction of one structure only by the person whose name appears on the plans.

Addition For

231 Clinton Avenue  
Dobbs Ferry, NY

As Built	10/10/23
Revision	Date
Date	Nov. 29, 2022

Job No	222-118
--------	---------

Drawing	11 OF 12
---------	----------

**DeMasi Architects P.C.**


105 SMITH AVENUE, MOUNT KISCO, NEW YORK 10549

PHONE: (914) 666-3858

EMAIL: Lou@DemasiArchitects.com

Do Not Scale Prints



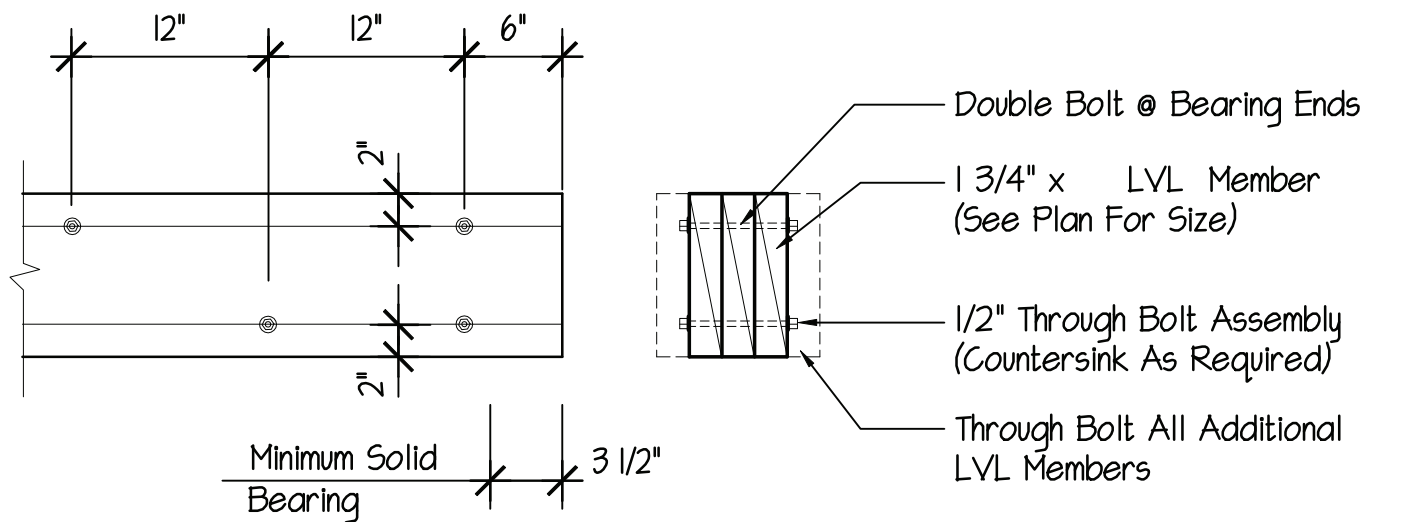


### Elevation

#### Note:

LVL = Laminated Veneer Lumber  
By Trus-Joist Meyerhaeuser (1.9 E)  
Minimum or Equal

## LVL Beam Detail (Bolted)

Scale: None

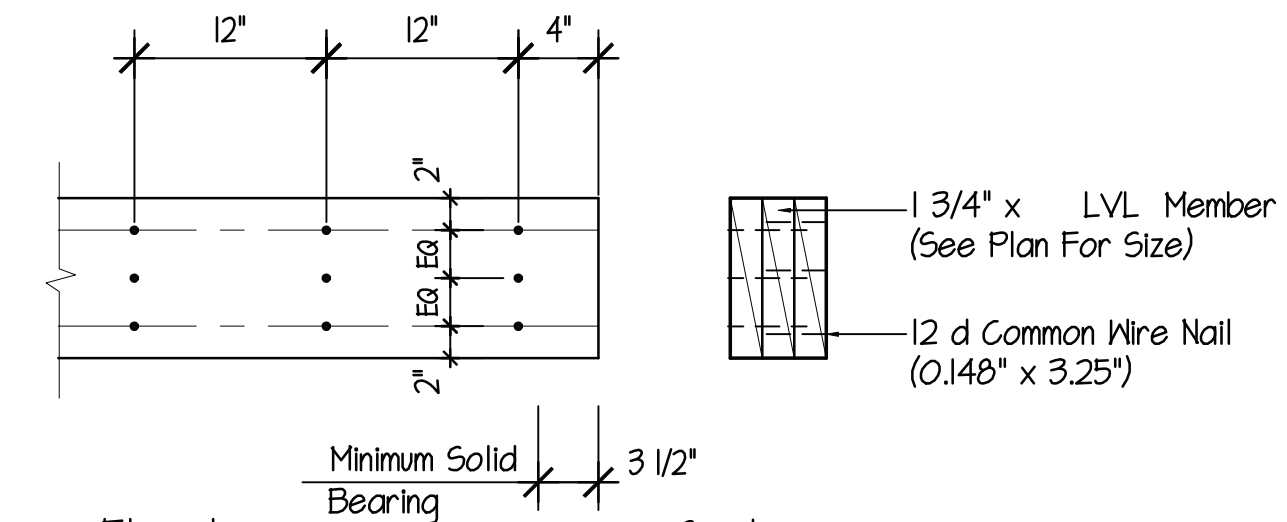

### Elevation

#### Note:

LVL = Laminated Veneer Lumber  
By Trus-Joist Meyerhaeuser (1.9 E)  
Minimum or Equal

## LVL Beam Detail (Nailed)

Scale: 1" = 1'-0"

#### General Conditions:

SPECIFICATIONS: These specifications are made in general form only and not specifically for any one building. The owner applying these specifications, assumes complete responsibility for their use, changes, or omissions.

SCOPE OF WORK: The Contractor shall provide all labor, materials, appliances and equipment required to complete all work, etc., as shown on the drawings necessary for a complete job, unless otherwise specified. All material and workmanship shall be of good quality.

OMISSIONS: All written figures (notes and dimensions) on the floor plans or specifications shall take precedence over any drawn figures (elevations). Do not scale prints. All dimensions must be verified by the contractor before start of construction. Any discrepancies on the plans or specifications must be reported to the Architect prior to the start of construction.

CODES: All work and materials must conform to all local and The 2020 Residential Code Of New York State, National Board of Fire Underwriters, NYStretch Energy Code 2020 Of New York State and requirements of the Board of Health.

ACCEPTABLE BUILDING STANDARDS: Installation of materials shall comply with industry standards as instituted by the national association or equivalent group of material used. Acceptable associations shall include, but are not limited to, the following: Western Wood Products Assoc., Cedar Shake & Shingle Bureau, Brick Industry Assoc., Tile Council of America, National Roofing Contractors Assoc., and American Concrete Institute, etc.

MATERIALS: Shall be installed according to the manufacturer's specifications. All work shall comply with applicable sections of the state and local codes and the generally accepted standards as listed in the state building code.

PERMANENT CERTIFICATION A permanent certificate shall be completed by the builder or registered design professional and posted on a wall in the space where the furnace is located, a utility room or an approved location inside the building. Where located on an electrical panel, the certificate shall not cover or obstruct the visibility of the circuit directory label, service disconnect label or other required labels. The certificate shall list the predominant R-values of insulation installed in an on ceiling/roof, walls, foundation (slab, basement wall, crawlspace wall and floor) and ducts outside conditioned spaces; U-factors for fenestration and the solar heat gain coefficient (SHGC) of fenestration, and the results from any required duct system and building envelope air leakage testing done at the building. Where there is more than one value for each component, the certificate shall list the value covering the largest area. The certificate shall list the types and efficiencies of heating, cooling and service water heating equipment. Where a gas-fired inverted room heater, electric furnace or baseboard electric heater is installed in the residence, the certificate shall list "gas-fired inverted room heater," "electric furnace" or "baseboard electric heater," as appropriate. An efficiency shall not be listed for gas-fired inverted room heaters, electric furnaces or electric baseboard heaters. See Section R403.3 of the NYStretch Energy Code 2020

SITE CONDITIONS: The General Contractor shall verify all conditions before submitting his proposal. No allowance for extra changes will be permitted because of lack of knowledge of the conditions peculiar thereto except as otherwise specified elsewhere in the contract documents. Each contractor will be responsible for his own engineering and layout once the owner has established property lines and minimum number of benchmarks. The contractor shall verify all lines, levels and dimensions shown on the drawings and will be held responsible for the correctness and setting out of his work.

OWNERSHIP OF PLANS: These plans are the property of DeMasi Architects P.C. Any use or reproduction, in whole or in part, without the written authorization of DeMasi Architects P.C. is prohibited. Any person or corporation using plans without proper authorization will be responsible to compensate the Architect. This plan is for the construction of one house only.

ARCHITECT STATUS: Architect has not been retained by owner to provide periodic job inspections or job administration. Purchaser of the plans shall assume full responsibilities for any deviations or changes to these plans.

ONERSHIP OF PLANS: These plans are the property of DeMasi Architects P.C. Any use or reproduction, in whole or in part, without the written authorization of DeMasi Architects P.C. is prohibited. Any person or corporation using plans without proper authorization will be responsible to compensate the Architect. This plan is for the construction of one house only.

ARCHITECT STATUS: Architect has not been retained by owner to provide periodic job inspections or job administration. Purchaser of the plans shall assume full responsibilities for any deviations or changes to these plans.

EXCAVATION: Excavate all earth, boulders, loose and soft rock to the lines and depths indicated on the drawings. All footings to bear on solid, undisturbed earth. Excavate for all utilities as required.

FOOTINGS: To bear 12" below line of solid undisturbed earth. Design of footings are based on 2,000 psi soil. If soil bearing conditions are questionable, contractor shall consult engineer for footing design. Sloped footings shall be 1:2 max. slope. Provide (2) #4 bars continuous (refer to wall section). All footings bearing from rock to soil shall be reinforced with (4) #5 bars (6 min. on both sides of joint). Dowel and pin all footings bearing on rock with a slope greater than 7:12 (30 degrees) w/ #4 dowels @ 24" o/c max.

FINISH GRADING: Finish grading shall be established to provide surface drainage in all directions away from the house and excavated areas.

#### Concrete & Masonry:

Weathering Condition: Severe

CONCRETE: Shall be a min.  $F_c = 3,000$  psi compressive strength for footings & foundation walls and  $F_c = 3,500$  psi compressive strength for porches, steps & garage floors. Concrete shall be "Air Entrained", total air content shall not be less than 5 % or more than 7 %. All concrete work shall conform to the latest American Concrete Institute (ACI) guidelines.

CONCRETE FLOORS: Shall have a smooth, dense steel trowel finish, suitable to receive composition flooring. Concrete floors in living areas shall have 6 mil. poly vapor barrier and 2" x 24" (min) rigid polystyrene foam insulation around the perimeter of the slab, where slab is within 2'-0" of grade. Pitch all garage and porch floors for drainage. (1/8"/ft. min)

POURED CONCRETE FOUNDATION: Shall comply with the latest edition of American Concrete Institute Specification and shall be plumb, straight, level and true. Forms to be properly constructed to hold concrete. Provide (2) #4 bars located at top and bottom of wall. All reinforcing bars for concrete work shall conform to A.S.T.M. A615 grade 60.

MASONRY: Concrete block shall be load bearing laid level, plumb and straight in a full bed of cement mortar (TYPE "S") with galvanized metal truss-type ties @ 24" horizontal and vertical. All joints to be well tooled. All masonry work shall conform to ACI 530 code and all reinforcement work shall conform to ACI 318-T. Fill top two courses solid with cement mortar.

MASONRY CHIMNEY & FIREPLACES: Where shown on the plans, shall be brick or stone where exposed and laid in a full bed of cement mortar with well tooled joints. Flues to be fire clay, size shown on the plans. Provide cast iron damper, ash pit and clear-out doors. Provide for proper clearances with combustible construction. Firestop at all clearances with non-combustible material. Contractor shall ensure proper clearances of chimney and fireplace per 2020 Residential Code Of New York State And NYStretch Energy Code 2020.

ACCEPTABLE BUILDING STANDARDS: Installation of materials shall comply with industry standards as instituted by the national association or equivalent group of material used. Acceptable associations shall include, but are not limited to, the following: Western Wood Products Assoc., Cedar Shake & Shingle Bureau, Brick Industry Assoc., Tile Council of America, National Roofing Contractors Assoc., and American Concrete Institute, etc.

MATERIALS: Shall be installed according to the manufacturer's specifications. All work shall comply with applicable sections of the state and local codes and the generally accepted standards as listed in the state building code.

PERMANENT CERTIFICATION A permanent certificate shall be completed by the builder or registered design professional and posted on a wall in the space where the furnace is located, a utility room or an approved location inside the building. Where located on an electrical panel, the certificate shall not cover or obstruct the visibility of the circuit directory label, service disconnect label or other required labels. The certificate shall list the predominant R-values of insulation installed in an on ceiling/roof, walls, foundation (slab, basement wall, crawlspace wall and floor) and ducts outside conditioned spaces; U-factors for fenestration and the solar heat gain coefficient (SHGC) of fenestration, and the results from any required duct system and building envelope air leakage testing done at the building. Where there is more than one value for each component, the certificate shall list the value covering the largest area. The certificate shall list the types and efficiencies of heating, cooling and service water heating equipment. Where a gas-fired inverted room heater, electric furnace or baseboard electric heater is installed in the residence, the certificate shall list "gas-fired inverted room heater," "electric furnace" or "baseboard electric heater," as appropriate. An efficiency shall not be listed for gas-fired inverted room heaters, electric furnaces or electric baseboard heaters. See Section R403.3 of the NYStretch Energy Code 2020

SITE CONDITIONS: The General Contractor shall verify all conditions before submitting his proposal. No allowance for extra changes will be permitted because of lack of knowledge of the conditions peculiar thereto except as otherwise specified elsewhere in the contract documents. Each contractor will be responsible for his own engineering and layout once the owner has established property lines and minimum number of benchmarks. The contractor shall verify all lines, levels and dimensions shown on the drawings and will be held responsible for the correctness and setting out of his work.

OWNERSHIP OF PLANS: These plans are the property of DeMasi Architects P.C. Any use or reproduction, in whole or in part, without the written authorization of DeMasi Architects P.C. is prohibited. Any person or corporation using plans without proper authorization will be responsible to compensate the Architect. This plan is for the construction of one house only.

ARCHITECT STATUS: Architect has not been retained by owner to provide periodic job inspections or job administration. Purchaser of the plans shall assume full responsibilities for any deviations or changes to these plans.

EXCAVATION: Excavate all earth, boulders, loose and soft rock to the lines and depths indicated on the drawings. All footings to bear on solid, undisturbed earth. Excavate for all utilities as required.

FOOTINGS: To bear 12" below line of solid undisturbed earth. Design of footings are based on 2,000 psi soil. If soil bearing conditions are questionable, contractor shall consult engineer for footing design. Sloped footings shall be 1:2 max. slope. Provide (2) #4 bars continuous (refer to wall section). All footings bearing from rock to soil shall be reinforced with (4) #5 bars (6 min. on both sides of joint). Dowel and pin all footings bearing on rock with a slope greater than 7:12 (30 degrees) w/ #4 dowels @ 24" o/c max.

FINISH GRADING: Finish grading shall be established to provide surface drainage in all directions away from the house and excavated areas.

EXCAVATION: Excavate all earth, boulders, loose and soft rock to the lines and depths indicated on the drawings. All footings to bear on solid, undisturbed earth. Excavate for all utilities as required.

FOOTINGS: To bear 12" below line of solid undisturbed earth. Design of footings are based on 2,000 psi soil. If soil bearing conditions are questionable, contractor shall consult engineer for footing design. Sloped footings shall be 1:2 max. slope. Provide (2) #4 bars continuous (refer to wall section). All footings bearing from rock to soil shall be reinforced with (4) #5 bars (6 min. on both sides of joint). Dowel and pin all footings bearing on rock with a slope greater than 7:12 (30 degrees) w/ #4 dowels @ 24" o/c max.

FINISH GRADING: Finish grading shall be established to provide surface drainage in all directions away from the house and excavated areas.

#### Concrete & Masonry:

Weathering Condition: Severe

CONCRETE: Shall be a min.  $F_c = 3,000$  psi compressive strength for footings & foundation walls and  $F_c = 3,500$  psi compressive strength for porches, steps & garage floors. Concrete shall be "Air Entrained", total air content shall not be less than 5 % or more than 7 %. All concrete work shall conform to the latest American Concrete Institute (ACI) guidelines.

CONCRETE FLOORS: Shall have a smooth, dense steel trowel finish, suitable to receive composition flooring. Concrete floors in living areas shall have 6 mil. poly vapor barrier and 2" x 24" (min) rigid polystyrene foam insulation around the perimeter of the slab, where slab is within 2'-0" of grade. Pitch all garage and porch floors for drainage. (1/8"/ft. min)

PLYWOOD JOISTS: Shall be "TJI" Joists by Trus Joist Meyerhaeuser. Install as per manufacturer's specifications.

SUB FLOOR: Shall be 23/32" Advantech Flooring w/ manufacture recommendation for glue and screwed to each framing member @ 6" o/c.

SHEATHING: Shall be 1/2" exterior grade plywood nailed to each framing member.

WOOD DECKS AND RAILINGS: Where shown on plans, shall be pressure treated No. 1 Southern yellow pine wood. All nails, bolts and all metal fastenings to be hot-dipped galvanized steel, silicon bronze or copper (see detail).

BRICK OR STONE VENEER: Shall be as shown on plans, laid in cement mortar with galvanized metal ties 24" horizontal and vertical. Provide weep holes at 4' o/c max. or as required (option: provide "MortarNet" at bottom of cavity). All joints to be well tooled. Brick and/or stone shall be selected by owner.

WINDOWS: Shall be ANDERSEN "400 Series" or equal windows with insulated "Low E" glass and screens. Size and type shown on plans. Provide tempered glass where shown or where within 18" of floor.

FRENCH DOORS: Shall be ANDERSEN Frenchwood or equal with tempered insulated "Low E" glass and screens.

FIBER-CEMENT SIDING: Shall be fiber-cement plank siding by Hardie or CertainTeed. Install according to manufacture's guidelines and details. Provide 3/8" x 1 1/2" wood starter strip set to true level 1/4" up from bottom edge of siding. Lap siding on 1 1/4" minimum over course below, placing all end joints over stud bearing. Use only galvanized or corrosion resistant fasteners.

INTERIOR DOORS: Interior doors shall be 1 3/8" flush mahogany stain grade or 6 panel pre-hung units, complete with hardware and casing. Siding, bi-fold and pocket doors shall be 1 3/8" flush mahogany or 6 panel doors or as shown on plans, complete with hardware. Provide a self-closing "50 Min." label insulated door and frame between garage and house.

EXTERIOR TRIM: Shall be "Azek" or Equal. Size and shape shown on plans.

INTERIOR TRIM: Shall be stock sections of pine and shall be neatly fitted and mitered and complete, including doors and window casings, aprons and stools, based at the floor. Closets to have one 3/4" shelf with clothes pole adequately supported. Linen closets to have five (5) 3/4" shelves.

WOOD STAIR: Provide oak tread stair, size shown on the plan. Provide complete hardwood railing post, newel, and balusters (4 1/2" o.c. max.), as required. Stair to have oaktread (10" w/ 1 1/8" nosing @ closed stair), clear pine stringer and risers (8 1/4" max.). Provide oak tread return and bullnose on open sides. Stair shall be glued and wedged. All trim to be mitered and glued. Stair shall be fabricated in millshop by professional stair-builder. The general contractor shall be responsible to field check and verify stair dimensions and compliance with local & state building codes.

FLOORS: Wood floors shall be 23/32 strip oak securely nailed to joists over a layer of rosh paper. Composition floors shall be 1/16" vinyl set in mastic on concrete, or 5/8" exterior A/C plywood underlayment in joist areas.

ATTIC CRAWLSPACE ACCESS: Access doors from conditioned spaces to unconditioned spaces such as attics and crawl spaces shall be weatherstripped and insulated to a level equivalent to the insulation on the surrounding surfaces. Access shall be provided to all equipment that prevents damaging or compressing the insulation. A wood-framed or equivalent barrier or retainer is required to be provided when loose-fill insulation is installed, the purpose of which is to prevent the loose-fill insulation from spilling into the living space when the attic access is opened, and to provide a permanent means of maintaining the installed R-value of the loose-fill insulation. See Section R402.2.4 of the NYStretch Energy Code 2020.

BUILDING CAVITIES: Building framing cavities shall not be used as ducts or plenums As Per Section R403.35 of the NYStretch Energy Code 2020.

ROOFING: All chimneys shall be properly flashed. Provide self-sealing ribbertized waterproof membrane (36" wide min) at all eaves, openings, hips, valleys, and ridges by M/R Grace and Company or equal (ice and watershield). All roofing shall be installed by qualified roofing contractors, in strict accordance with manufacturer's specifications.

ASPHALT SHINGLE ROOF: Shall be 30-yr nstic asphalt shingles laid on 15 lb. roofing felt.

ROOF VENTILATION: Ventilate all attic and rafter spaces with proper sized screened ridge and soffit vents or louvers (see plans).

GYPSUM BOARD: 1/2" nailed with rosh nails according to manufacturer's specifications. All joints to be taped and receive three (3) coats of joint compound. Finish to be smooth and even, ready for painting. Provide 5/8" type "X" gypsum board at both sides of garage house walls and ceilings. Also, provide 100 SF min. over furnace.

GUTTERS AND LEADERS: Provide baked enamel gutters and leaders as required. All leaders and gutters are to be properly supported at all joint areas.

INSULATION: Shall be fiberglass batts with vapor barrier. Provide insulation as per NYStretch Energy Code 2020 Section R402.

RES-CHECK software is allowed to be used to calculate insulation requirements.

#### Tile Work:

CERAMIC TILE: Baths and lavatory floors to receive matt glazed ceramic tile set in thin-set grout. Installation to be as per latest edition of the Tile Council of America specifications. Consult Architect if other setting methods are to be used to verify floor structure. Tub and shower wall to receive glazed ceramic tile set in mastic. 6" tile set in mastic. Provide water-resistant cement backer boards to tub shower walls and wet areas.

ACCESSORIES AND ATTACHMENTS: Provide ceramic accessories such as soap dish, paper holder, 2 towel bars per bath. Provide mirror medicine cabinet with light over. Provide formica stock vanity where shown on plans.

#### Painting:

EXTERIOR: Siding, fascias, and trim shall receive one (1) prime coat and one (1) finish coat of exterior stain or paint.

INTERIOR: Walls to receive one (1) prime coat and one (1) finish coat of latex or oil flat paint. Flush hardwood doors to receive one (1) coat of stain and one (1) coat of satin polyurethane finish. Six (6) panel doors to receive one (1) coat primer and one (1) coat of satin enamel finish. Floors to be sanded and receive one (1) coat of sealer and one (1) coat of floor polyurethane, gloss finish.

TRIM AND MISCELLANEOUS WOOD: Shall have one (1) prime coat and one (1) finish coat of satin enamel.

#### Heating:

HEATING AND AIR CONDITIONING: Shall be oil-fired hydro-air system, complete with boiler, hydronic zone controls, thermostats, oil tank, etc. for 5 zones. Provide domestic hot water coil or separate circulating storage tank if required in boiler. Provide air handling units, condensers, insulated supply ducts and vents to each room. Heating and cooling system to be designed and guaranteed to conform to the latest ASHREA specifications and the NYStretch Energy Code 2020. Heating system shall be designed and guaranteed to maintain 73° degrees F indoor temperature with 7° degrees F outdoor temperature.

DUCTS: All ducts shall be fabricated and rigidly installed with required bracing and supports. The main supply and return duct shall be isolated from the heater and blower by means of fabric insulators. Provide duct damper for each run. Insulate all ducts located in garage, attic, and unheated areas

DUCT TESTING: Ducts shall be pressure tested to determine air leakage by one of the following methods: Rough-In test Or Postconstruction test. A written report of the results of the test shall be signed by the party conducting the test and provided to the code official. See Section R403.3.5 of the NYStretch Energy Code 2020.

EQUIPMENT SIZING AND EFFICIENCY RATING: Heating and cooling equipment shall be sized in accordance with ACCA Manual 5 based on building loads calculated in accordance with ACCA Manual J or other approved heating and cooling calculation methodologies. New or replaced heating and cooling equipment shall have an efficiency rating equal to or greater than the minimum required by federal law for the geographic location where the equipment is installed. See Section R403.1 of the NYStretch Energy Code 2020 For More Detail.

GRILLS AND REGISTERS: Provide supply and return registers in each room. All supply grills to have adjustable dampers.

BALANCING: Heating contractor shall balance entire house so that all rooms heat evenly to the required temperature set on the thermostat.

#### Plumbing:

WORK INCLUDED: Contractor shall furnish all labor, materials and equipment required to fully complete all plumbing work shown on plans.

FLASHING: All pipes passing through roof shall receive aluminum collar, strapped and fitted to provide water-proof seal.

TESTING: Contractor shall test all water, drainage, and vent piping in accordance with local codes.

WATER SUPPLY: Water supply in street or well shall be extended to house with 1" heavy copper pipe and entire house shall be supplied with both hot and cold water by means of heavy copper pipe of appropriate sizes, min. 3/4" sub main to each bath, kitchen, and laundry. The weather resistant hose fittings shall be installed. Provide hook-up for washer where shown.

DRAINAGE SYSTEM: Shall be installed in accordance with local codes and ordinances and shall be complete with copper drains and copper vents, cleanouts, etc. connected to street sewer or septic system. Drains under concrete to be cast in.

FIXTURES: As shown on plans shall be AMERICAN STANDARD, KOHLER, or equal. All exposed fittings and pipe to be chrome plated.

SEPTIC AND WELL SYSTEMS: (If required) shall conform to all requirements of the Board of Health.

#### Electrical:

Electrical system to be designed to comply with NEC 70 specification.

Electrical: Provide a minimum of 120/208-200 amp, or larger, if required, for service. Switches to be silent type. Locations of outlets, fixtures, etc., as shown on plans. All electric work to conform to the National Board of Fire Underwriters Codes. Provide a complete door bell system.

Contractor to provide exhaust fans at both rooms (vent to exterior). Provide 4 install as per code.

Contractor to provide smoke & heat detectors with battery back-up (see plans for location). Detectors shall conform to all applicable codes and shall be installed as per code R314.3. Hard-wire and interconnected per section R314.4

Contractor to provide carbon monoxide detectors with battery back-up (see plans for location). Detectors shall conform to all applicable codes and shall be installed as per building code. Section R315.

Lighting Equipment: Not less than 40 percent of the permanently installed lighting fixtures shall contain only high-efficacy lamps. Of the NYStretch Energy Code 2020.

MECHANICAL VENTILATION: The building shall be provided with ventilation that meets the requirements of the NYStretch Energy Code 2020 or 2020 Mechanical Code Of New York State, as applicable, or with other approved means of ventilation. Outdoor air intakes and exhausts shall have automatic or gravity dampers that close when the ventilation system is not operating. See Section R403.6 of the NYStretch Energy Code 2020 For More Detail.

#### Site Work:

SITE WORK: Provide 2" blacktop driveway, 4" gravel base to street. Sidewalks to be 3' wide, 4" concrete or 1 1/2" flagstone laid in sand, from house to driveway. Provide top soil and seed to all areas disturbed by construction.

#### Insulation / Energy Code:

Refer to "RES CHECK" energy study attached to plans or fixed to first page.

INSULATION: Shall be fiberglass batt with foil faced vapor barrier, "R" value stated on attached RES-CHECK.

Pack insulation in all cavities around all exterior windows, doors and other openings.

AIR LEAKAGE: Joints, penetrations, and all other such openings in the building envelope that are sources of air leakage must be sealed in accordance with the requirements of Sections R402.4.1 through R402.4.4. Of the 2020 Energy Conservation Code Of New York State. Recessed lights must be 1) Type IC rated, or 2) installed inside an appropriate air-tight assembly with a 0.5" clearance from combustible materials. If non-IC rated, the fixture must be installed with a 3" clearance from insulation.

VAPOR RETARDER: Required on the warm-in-winter side of all non-vented framed ceilings, walls, and floors.

#### Material Identification:

Materials and equipment must be installed in accordance with the manufacturer's installation instructions. Materials and equipment must be identified so that compliance can be determined. Manufacturer manuals for all installed heating and cooling equipment and service water heating equipment must be provided. Insulation R-values and glazing U-factors must be clearly marked on the building plans or specifications.

#### Duct Insulation:

Supply and return ducts in attics shall be insulated to an R-value of not less than R-8 for ducts 3 inches (16 mm) in diameter and larger and not less than R-6 for ducts smaller than 3 inches (16 mm) in diameter.

Supply and return ducts in other portions of the building shall be insulated to not less than R-6 for ducts 3 inches (16 mm) in diameter and to not less than R-4.2 for ducts smaller than 3 inches (16.2 mm) in diameter. Exception being ducts located in conditioned spaces. See 2020 Residence Code Of New York State.

Ducts buried within ceiling insulation both supply and return shall have an insulation R-value not less than R-8. At all points along each duct, the sum of the ceiling insulation R-values against and above the top of the duct, and against and below the bottom of the duct shall be not less than R-4, excluding the R-value of the duct insulation.

#### Duct Construction:

All joints, seams, and connections must be securely fastened with welds, gaskets, mastics (adhesives), mastic-plus-embedded-fabric, or tapes. Duct tape is not permitted.

- Exception: Continuously welded and locking-type longitudinal joints and seams on ducts operating at less than 2 in. Hg. (500 Pa).
- Exception: Air-impermeable spray foam products shall be permitted to be applied without additional joint seals.

Ducts shall be supported every 10 feet or in accordance with the manufacturer's instructions.

Cooling ducts with exterior insulation must be covered with a vapor retarder.

Air filters are required in the return air system. The HVAC system must provide a means for balancing air and water systems.

#### Temperature Controls:

The thermostat controlling the primary heating or cooling system of the dwelling unit shall be capable of controlling the heating and cooling system on a daily schedule to maintain different temperature setpoints at different times of the day. The thermostat shall include the capability to set back or temporarily operate the system to maintain zone temperatures of not less than 55 F (13 C) to not greater than 85 F (24 C). The thermostat shall be programmed initially by the manufacturer with a heating temperature setpoint of not greater than 70 F (21 C) and a cooling temperature setpoint of not less than 78 F (26 C).

#### Electrical Systems:

Separate electric meters are required for each dwelling unit.

#### Fireplaces:

Fireplaces must be installed with tight fitting non-combustible fireplace doors. Fireplaces must be provided with a source of combustion air, as required by the Fireplace construction provisions of the Building Code, the Residential Code as applicable.

#### Service Water Heating:

Water heaters with vertical pipe risers must have a heat trap on both the inlet and outlet unless the water heater has an integral heat trap or is part of a circulating system.

#### Swimming Pools:

All heated swimming pools must have an on/off heater switch and require a cover unless over 20% of the heating energy is from non-depletable sources. Pool pumps require a time clock.

#### Heating & Cooling Piping Insulation:

Mechanical system piping capable of carrying fluids above 105 degrees F or chilled fluids below 55 degrees F must be insulated to a Minimum of R-3. See Section R403.4 of the NYStretch Energy Code 2020 for more detail.

Do Not Scale Prints

DeMasi Architects P.C.

105 SMITH AVENUE, MOUNT KISCO, NEW YORK 10549

EMAIL: [Louis@DemasiArchitects.com](mailto:Louis@DemasiArchitects.com)

PHONE: (914) 666-3850




These plans are the property of the Architect. Any use or reproduction in whole or part without the written authorization of the Architect is prohibited. Any person or corporation using these plans without proper authorization will be responsible to compensate the Architect.

These plans are not valid for a building permit unless they are stamped and signed by the Architect for the construction of one structure only by the person whose name appears on the plans.

Addition For	
231 Clinton Avenue Dobbs Ferry, NY	
As Built	10/10/23
Revision	Date
Date	Nov. 24, 2022
Job No	222-118
Drawing	12 of 12



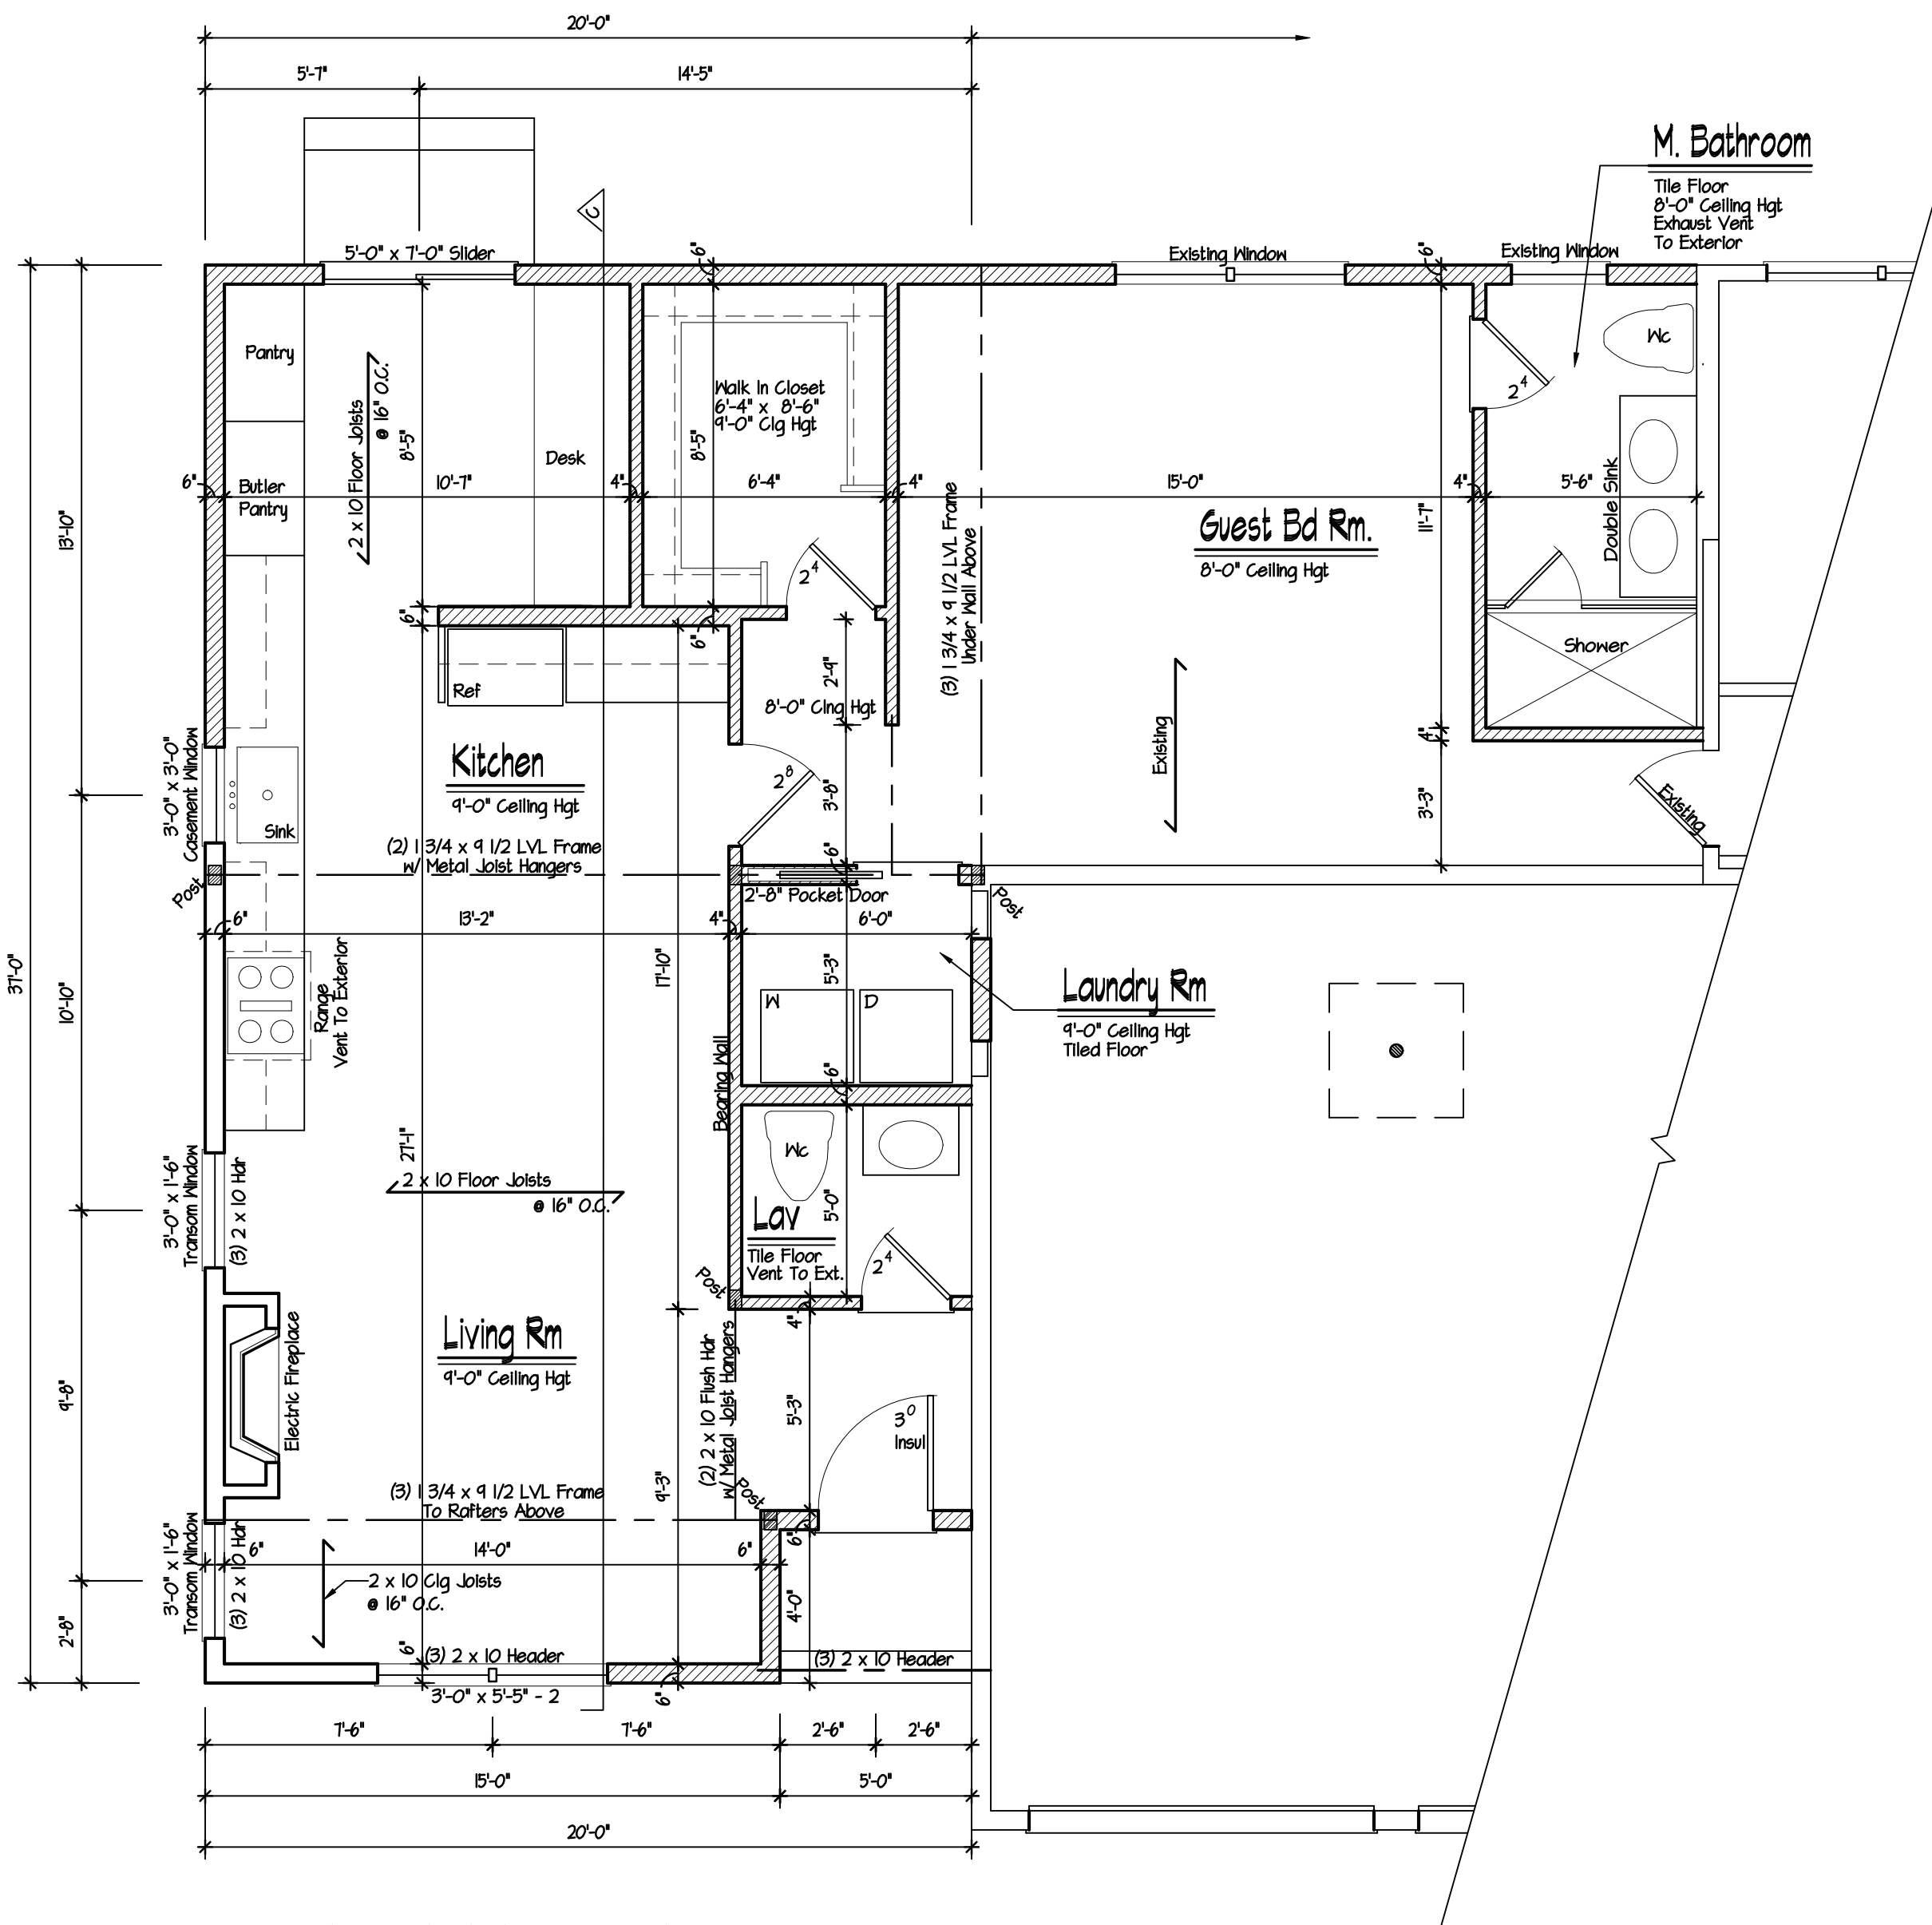

**First Floor Plan**  
Scale: 1/4" = 1'-0"

- Window Note:**
1. All Glazing To Be Low "E" Insulated Glass w/ Minimum U-Factor Of 0.27 And SHGC Of .04
  2. All Windows Within 10' Of Floor To Have Tempered Glass (Double Hung's-Bottom Sash Only, All Others Full Unit).
  3. All Glazing In Doors & Windows Enclosing Hot Tubs, Whirlpool Tubs, Saunas, Steam Rooms, Bathtubs and Showers Within 60" Of Window or Door Unit Shall Have Tempered Glass.
  4. All Egress Windows To Have A Minimum Clear Opening Area Of 5.7 Sq Total w/ 24" min Clear Opening Height & 20" min Clear Width. Refer To Manufacturers Specifications For All Other Information.
  5. All Windows or Doors Marked w/ "TEMP" To Have Full Unit Tempered.
  6. All Windows Sills Within 24" Above The Finished Floor & Greater Than 12" Above Finished Grade Or Other Surface. Requires Fall Protection. See Section R312.2 For More Info.

**Notes:**

All Framing Members To Be # 2 Douglas Fir-Larch Or Better Double Frame Under All Partitions Parallel To Framing

If Tile Floor Is To Be MUD Job Consult Architect For Additional Framing Required


**Legend:**

- 2 x Wood Post (Match Beam Width or As Noted)
- Smoke Detector w/ Battery Back-Up
- Carbon Monoxide Det w/ Battery Back-Up
- Existing Wall (To Remain)
- New Wall

**Wood Header Schedule**

Span	Header Size
Up To 3'-0"	(2) 2 x 8 Hdr
Up To 4'-0"	(2) 2 x 10 Hdr
Up To 6'-0"	(3) 2 x 10 Hdr

Note: Unless Otherwise Noted On Plans

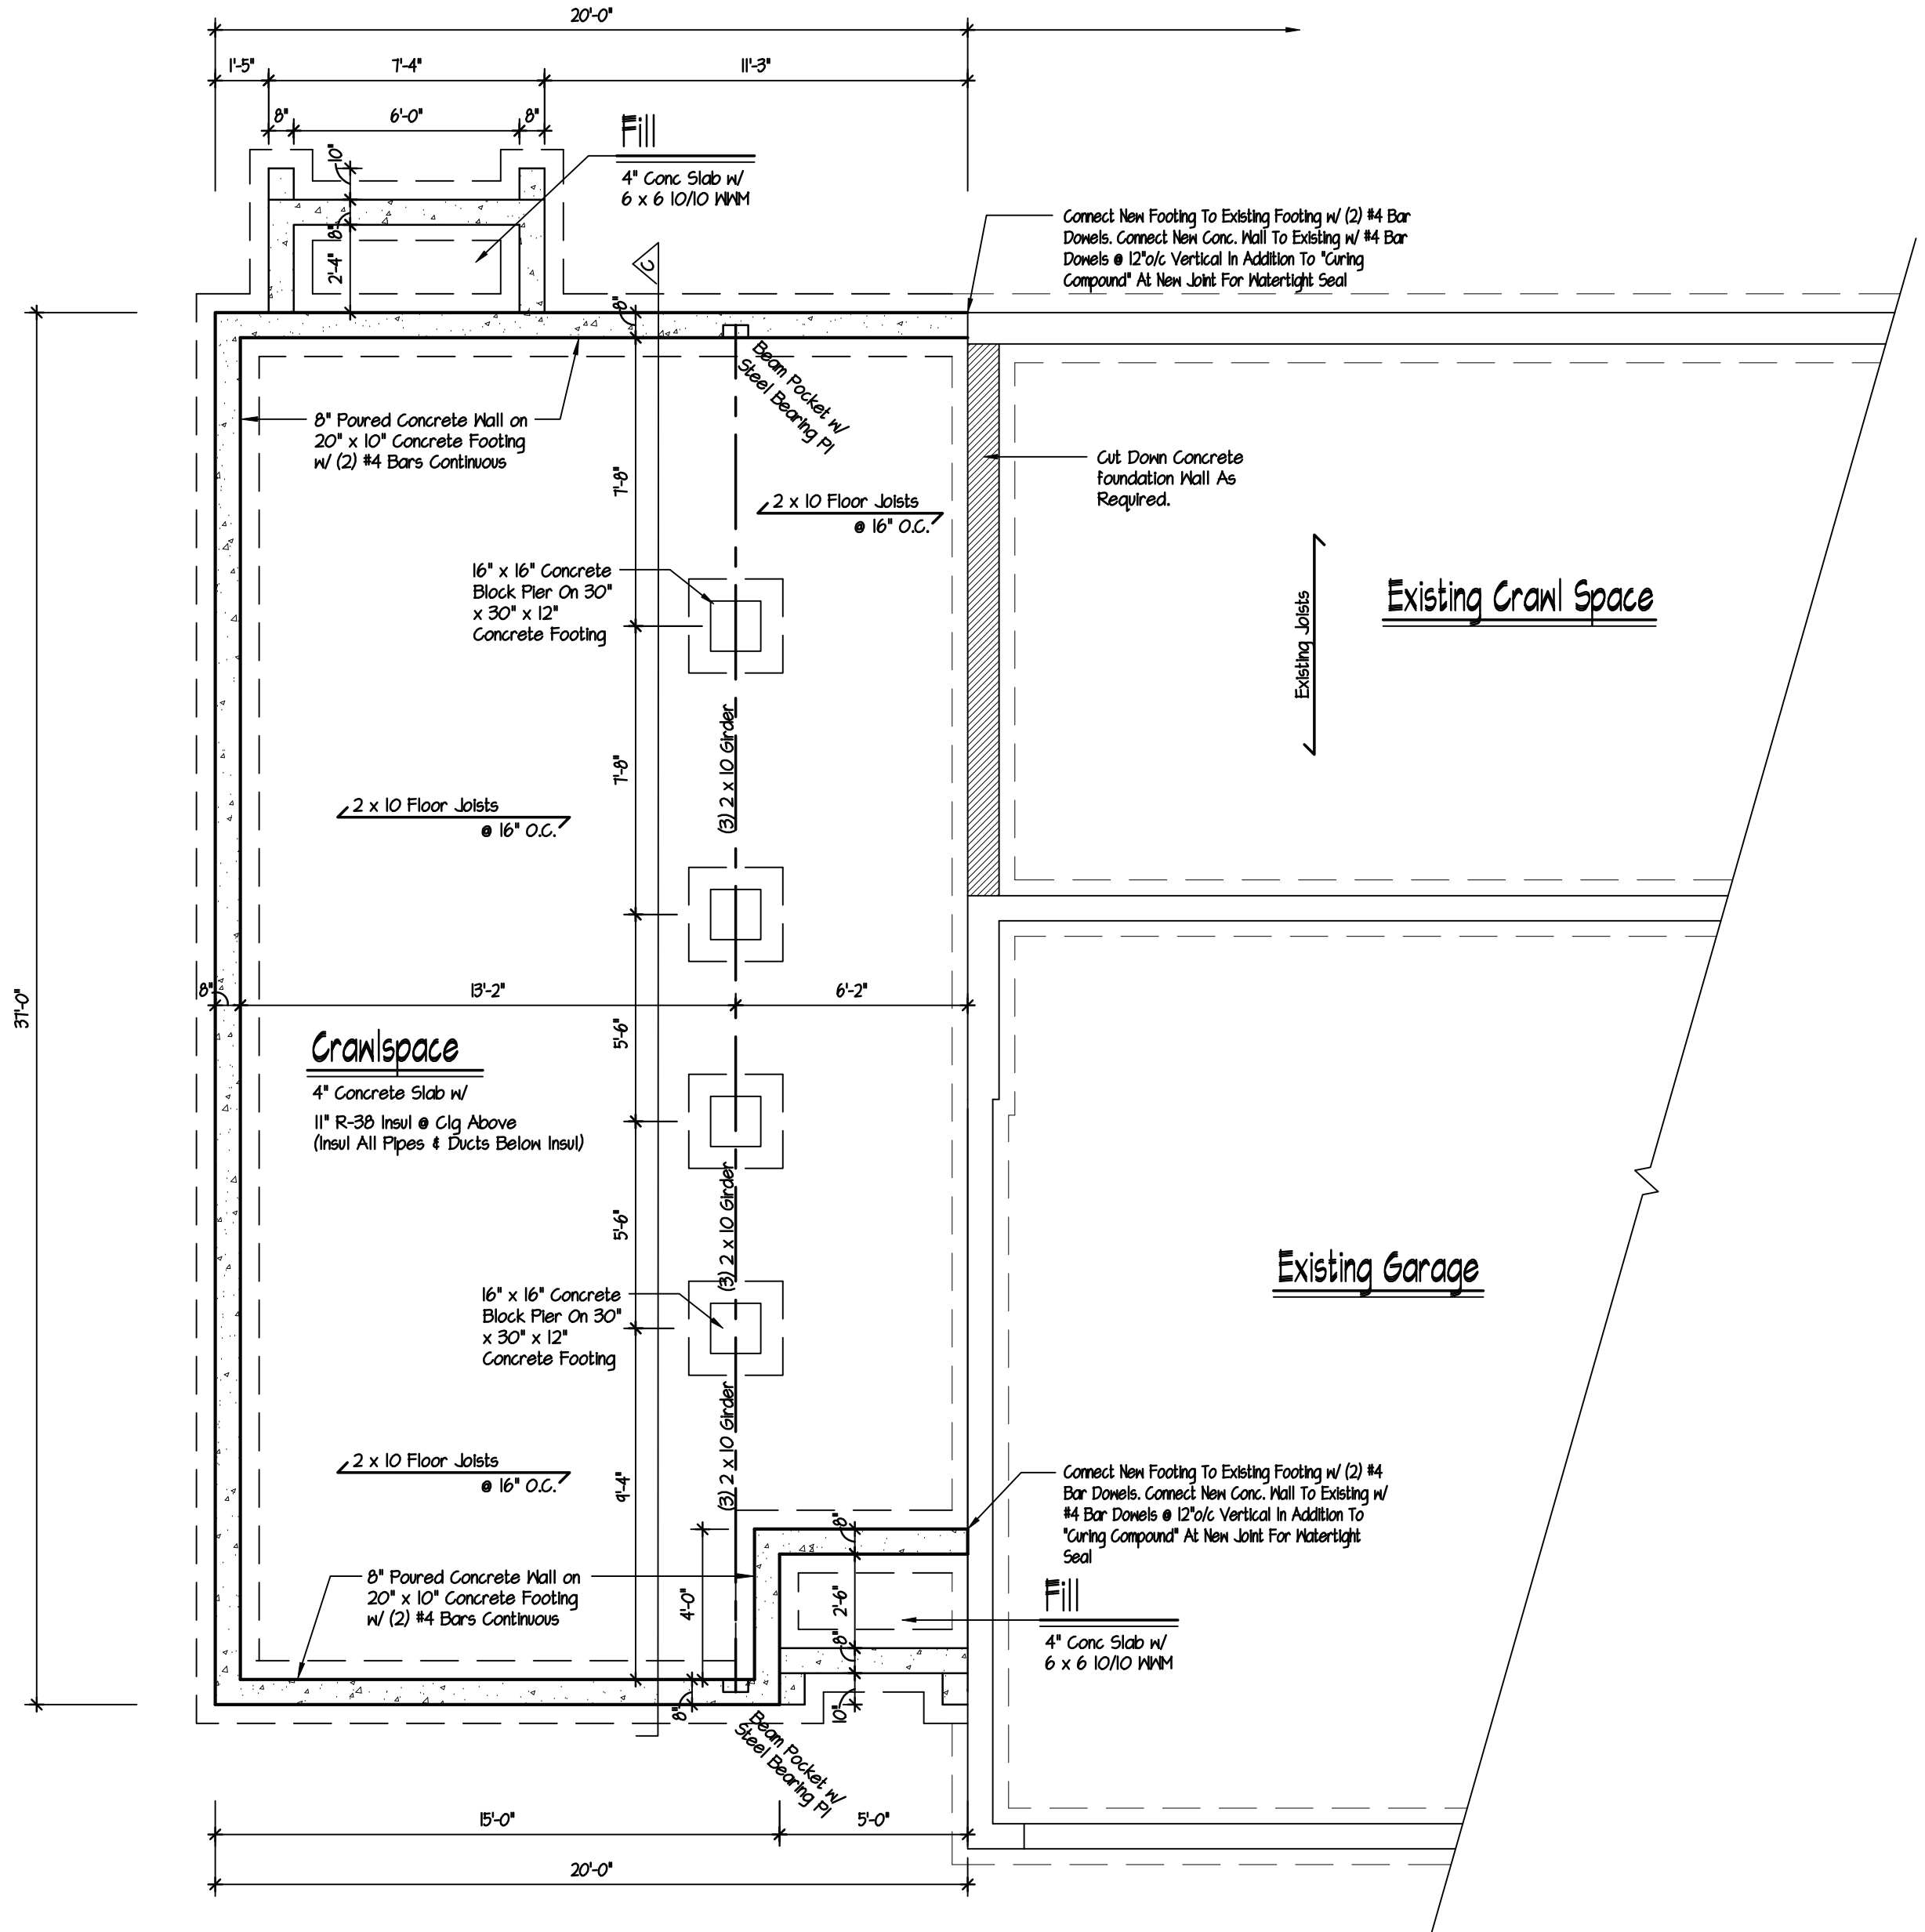

**Foundation Plan**  
Scale: 1/4" = 1'-0"

Accessory Apartment For

231 Clinton Avenue  
Dobbs Ferry, NY

Revision	Date
Date	Oct. 10, 2023
Job No	223-149
Drawing	

A OF 2




These plans are the property of the Architect. Any use or reproduction in whole or part without the written authorization of the Architect is prohibited. Any person or corporation who reproduces these plans without the written consent of the Architect shall be liable to the Architect for the cost of the reproduction of these plans. These plans are not valid for a building permit unless the Architect's seal and signature are present on the plans.

**DeMasi Architects P.C.**  
105 SMITH AVENUE, MOUNT KISCO, NEW YORK 10549

PHONE: (914) 666-3850  
EMAIL: Lou@DemasiArchitects.com

Do Not Scale Prints

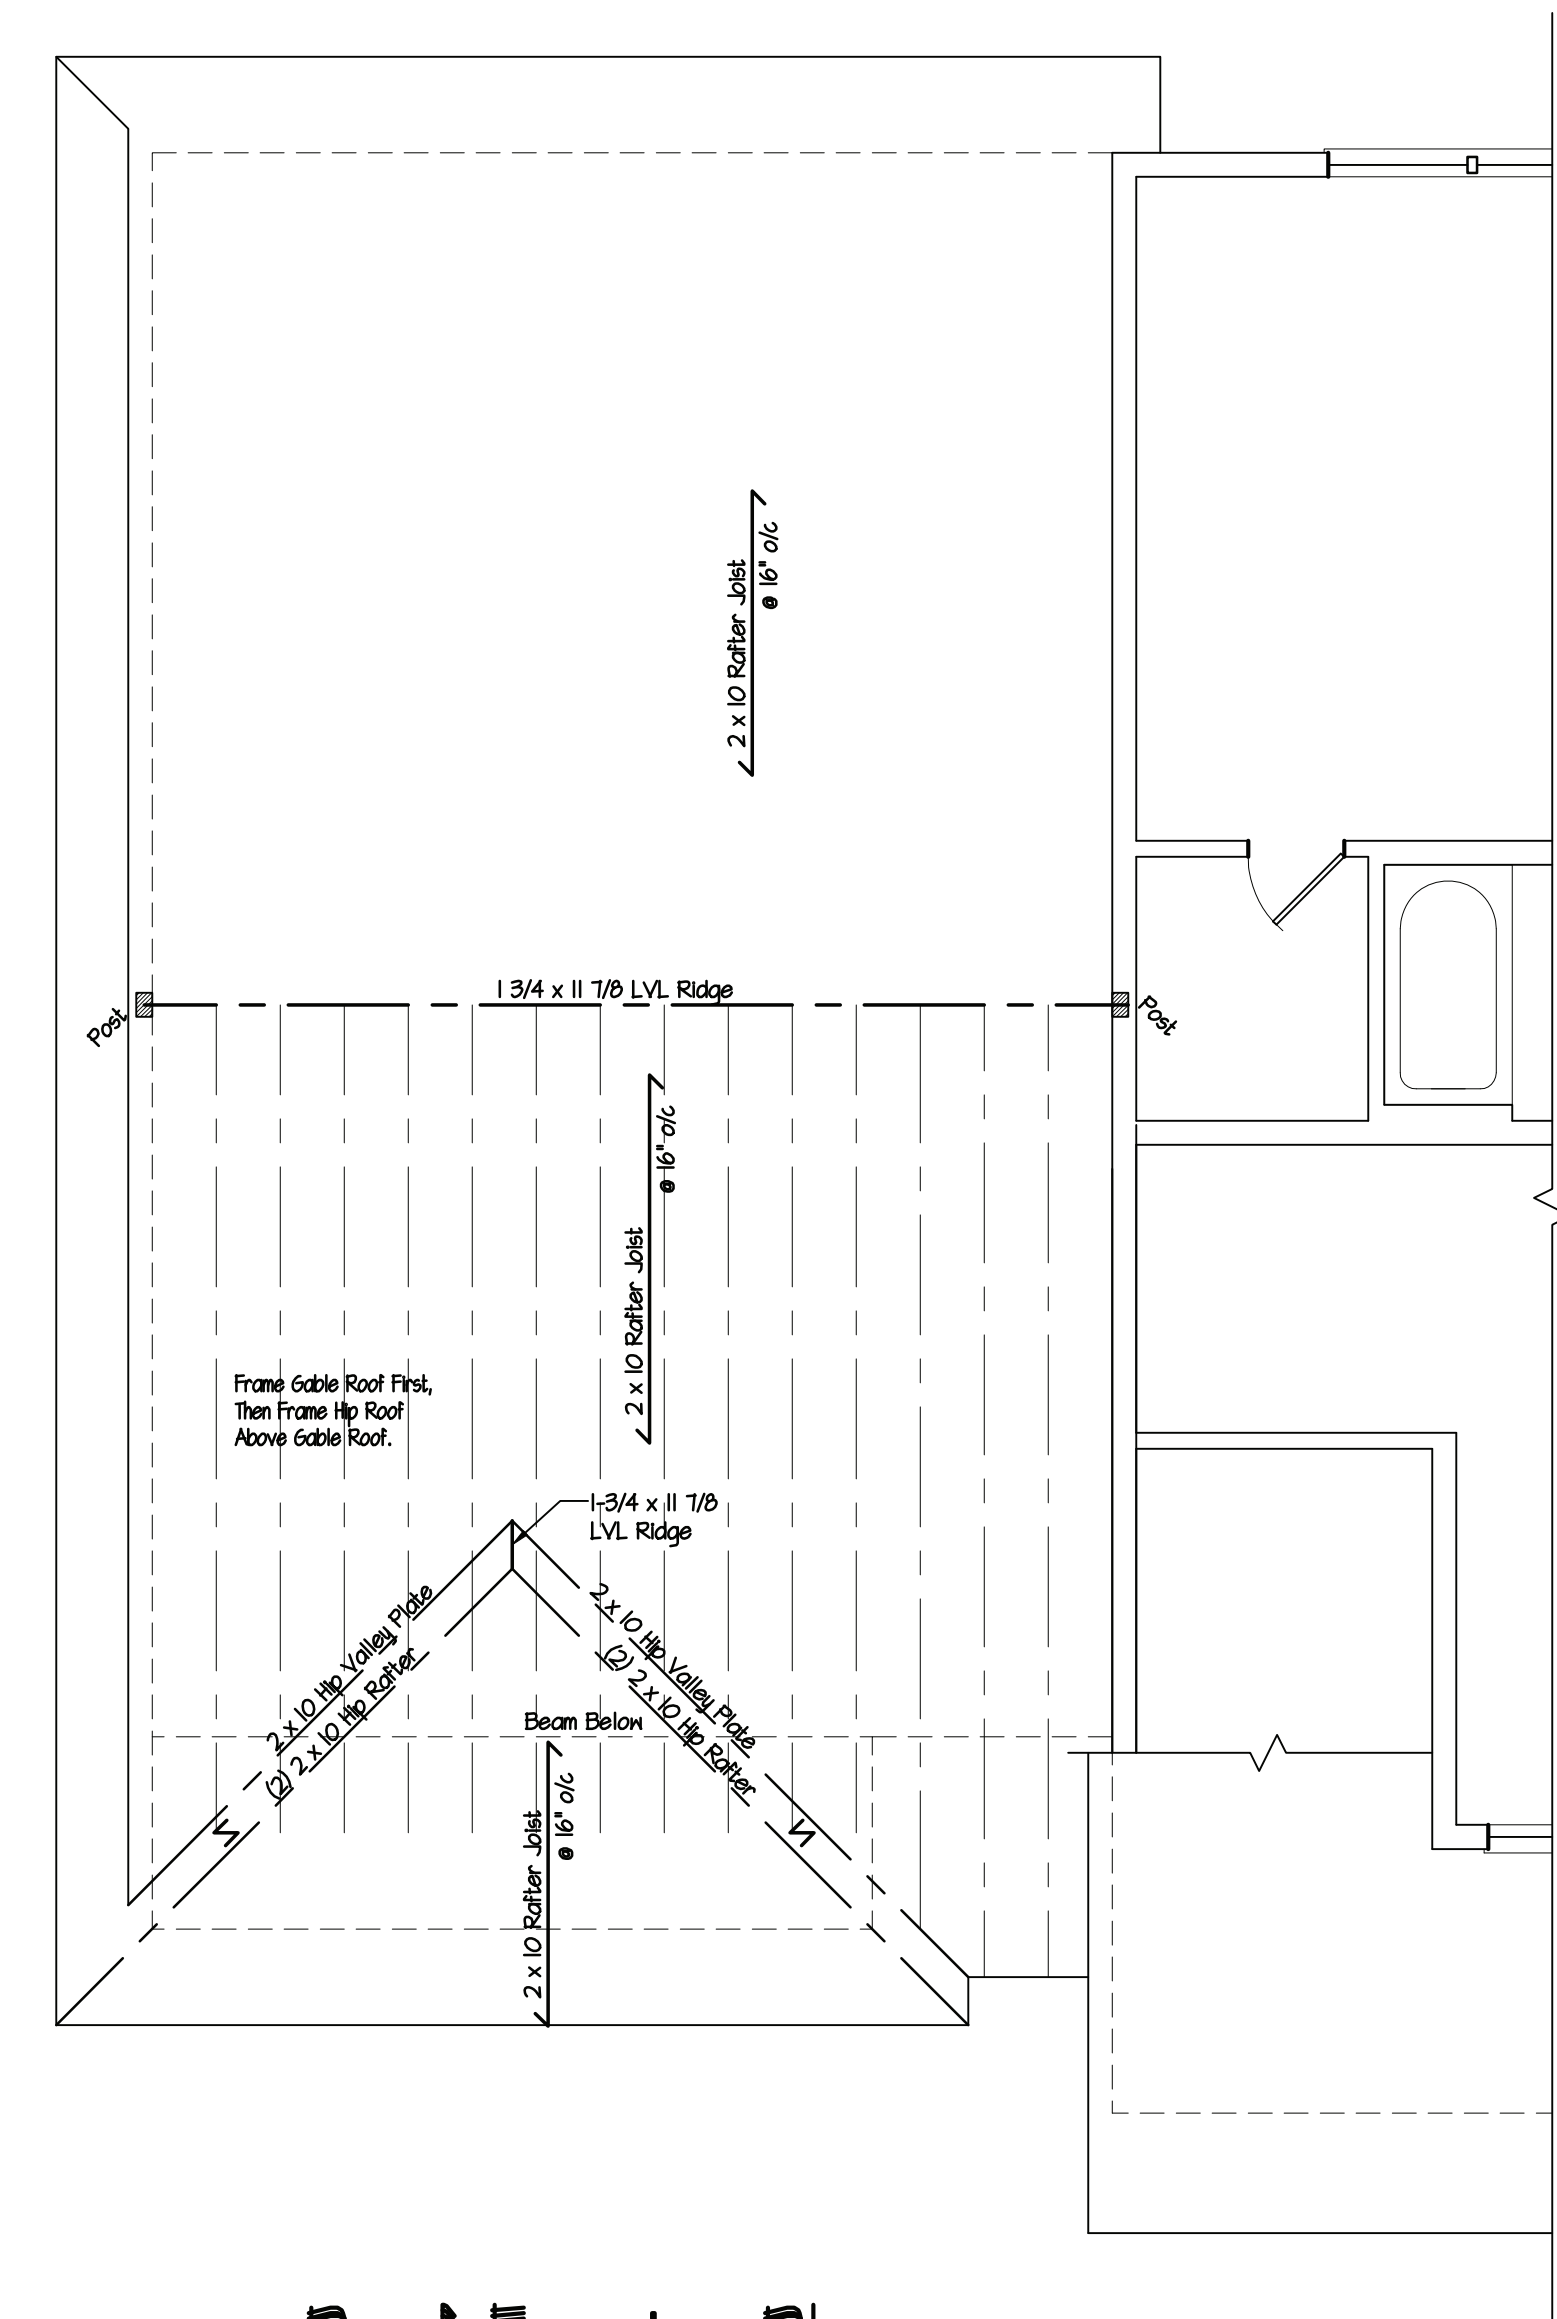

Accessory Apartment For  
231 Clinton Avenue  
Dobbs Ferry, NY

These plans are the property of the Architect. Any use or reproduction in whole or part without the written authorization of the Architect is prohibited. Any person or corporation who reproduces or authorizes reproduction will be responsible to compensate the Architect.

These plans are not valid for a building permit unless originally signed and sealed by the Architect, and are for the construction of one structure only by the person whose name appears on the plans.



**DeMasi Architects P.C.**  
105 SMITH AVENUE, MOUNT KISCO, NEW YORK 10549

PHONE: (914) 666-3858

---

EMAIL: [Low@DenasiArchitects.com](mailto:Low@DenasiArchitects.com)

Do Not Scale Prints

Revision	Date
Date <u>Oct. 10, 2023</u>	
Job No <u>223-149</u>	
Drawing	
